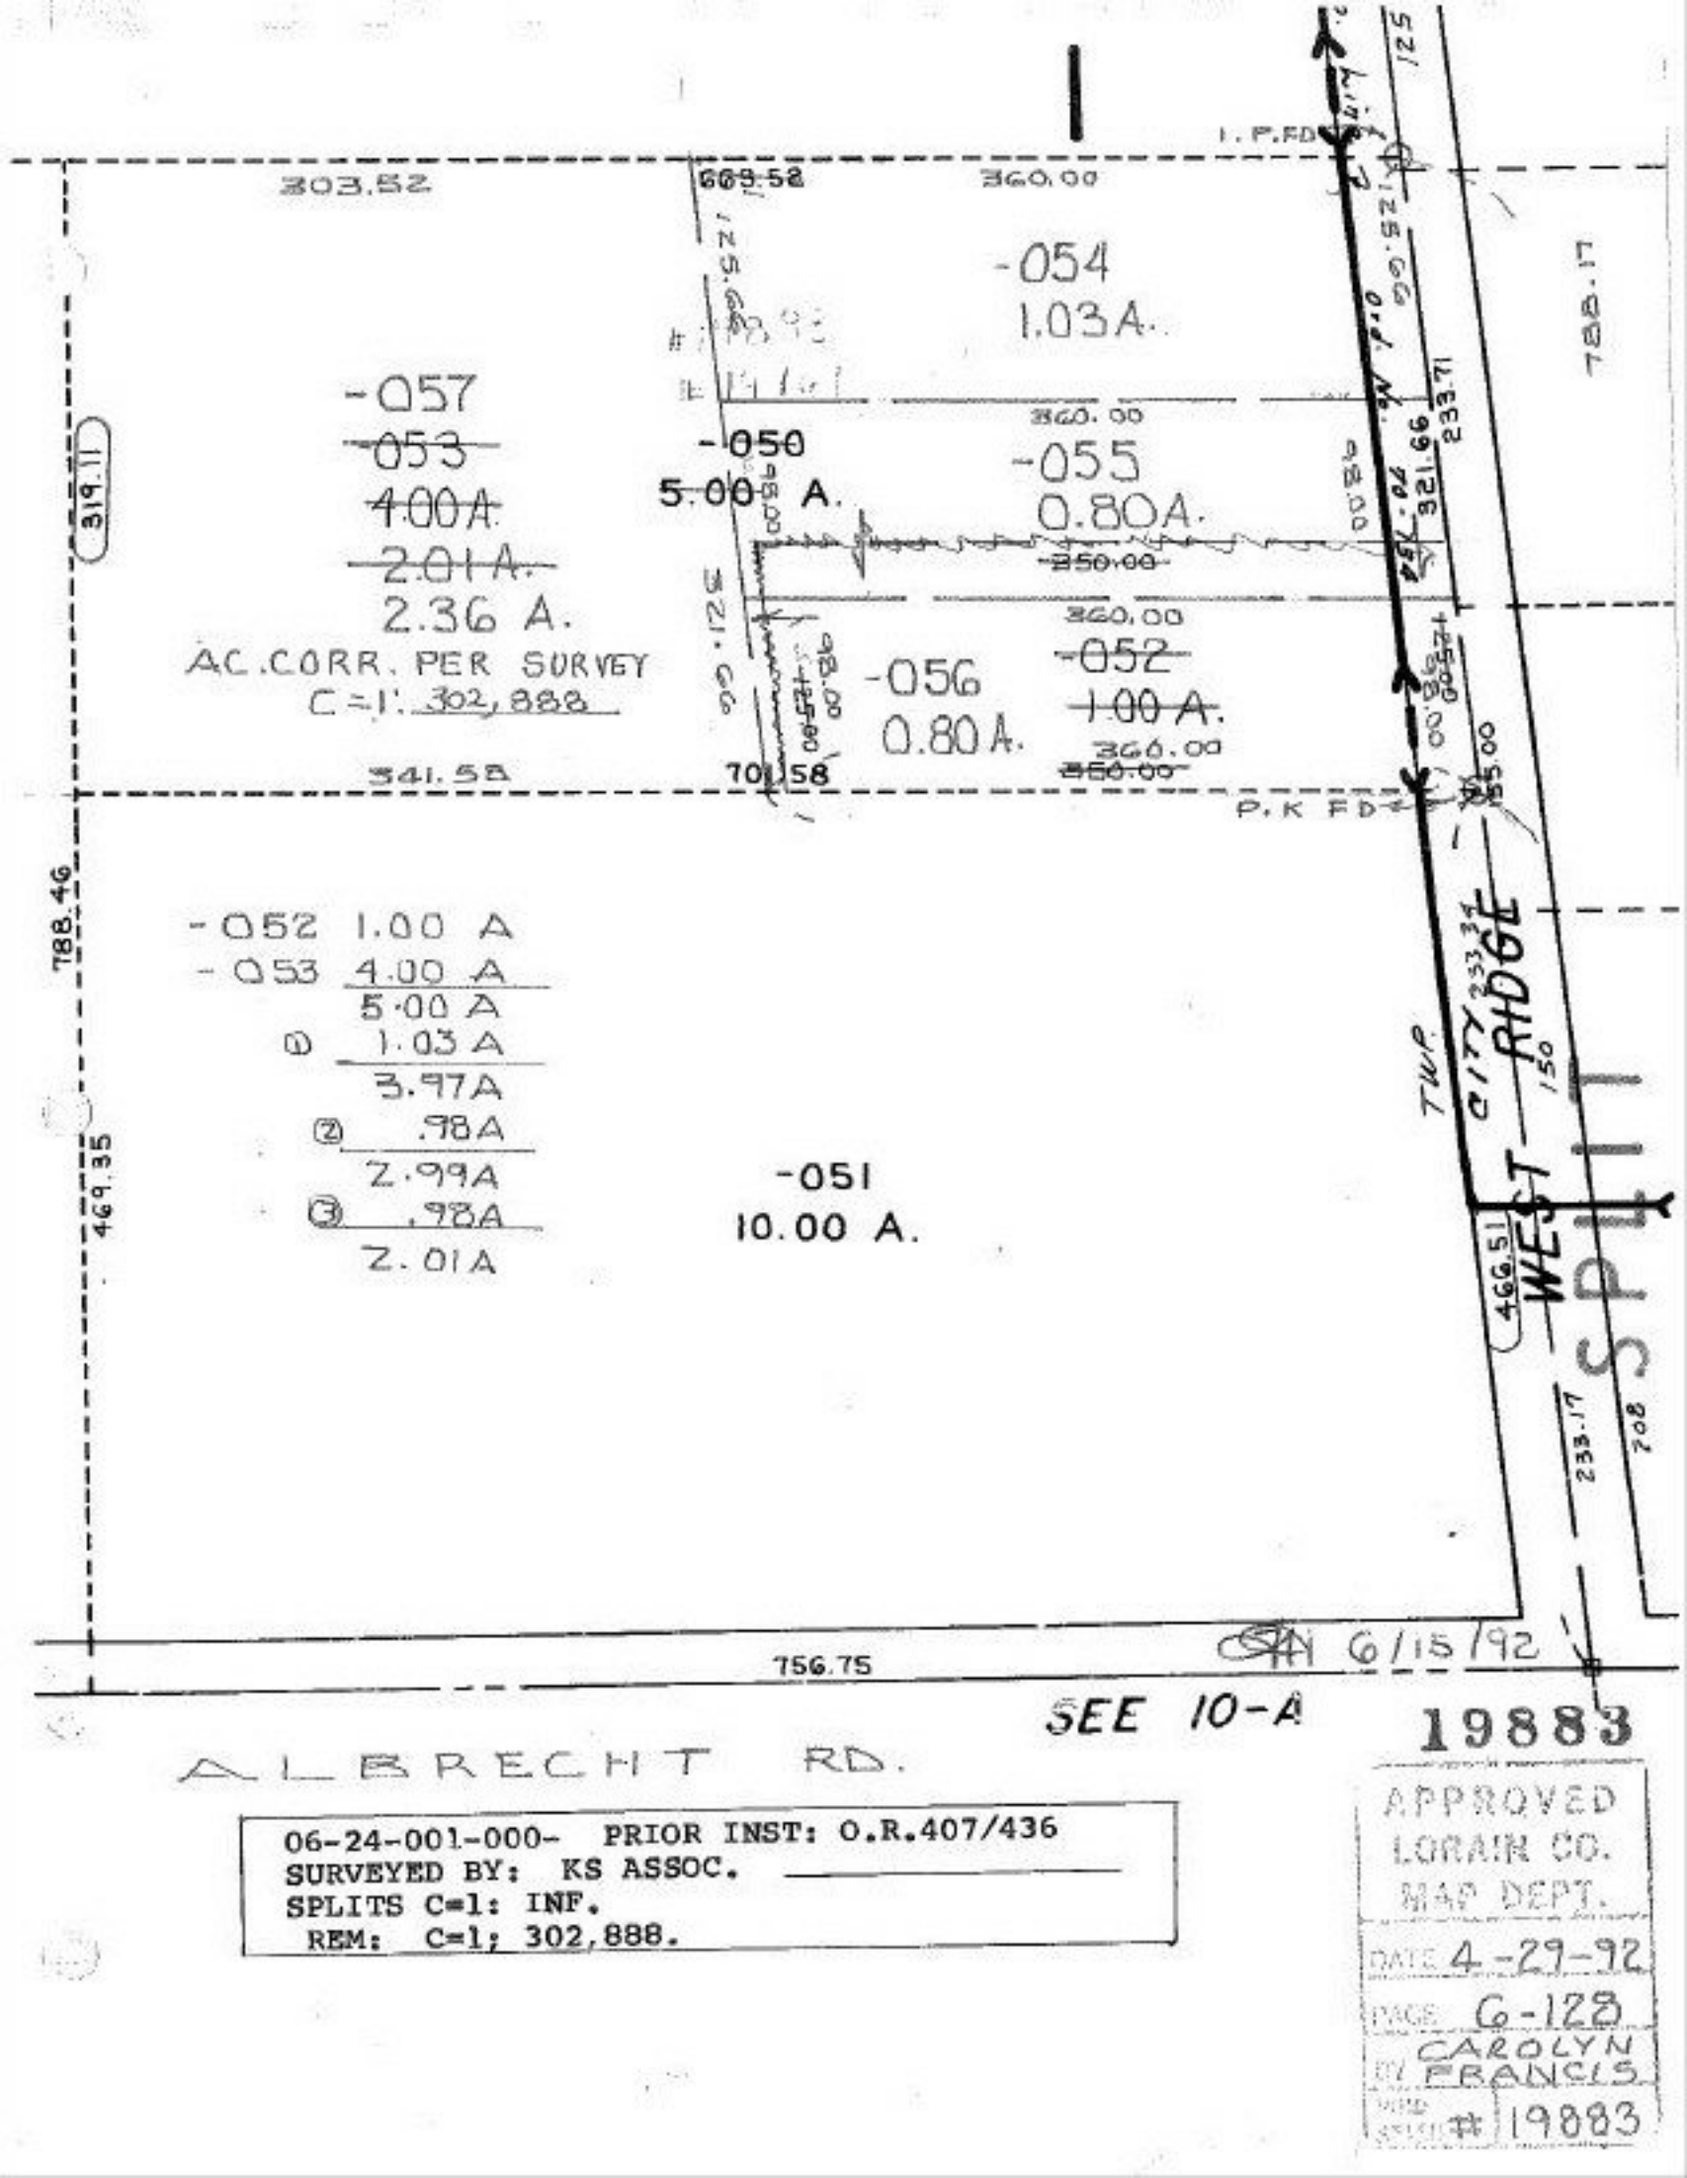

06-24-001-000- PRIOR INST: O.R.407/436
SURVEYED BY: KS ASSOC.
SPLITS C=1: INF.
REM: C=1; 302,888.

APPROVED
LORAIN CO.
MAP DEPT.
DATE 4-29-92
PAGE 6-128
BY CAROLYN FRANCIS
MAP REVISION # 19883