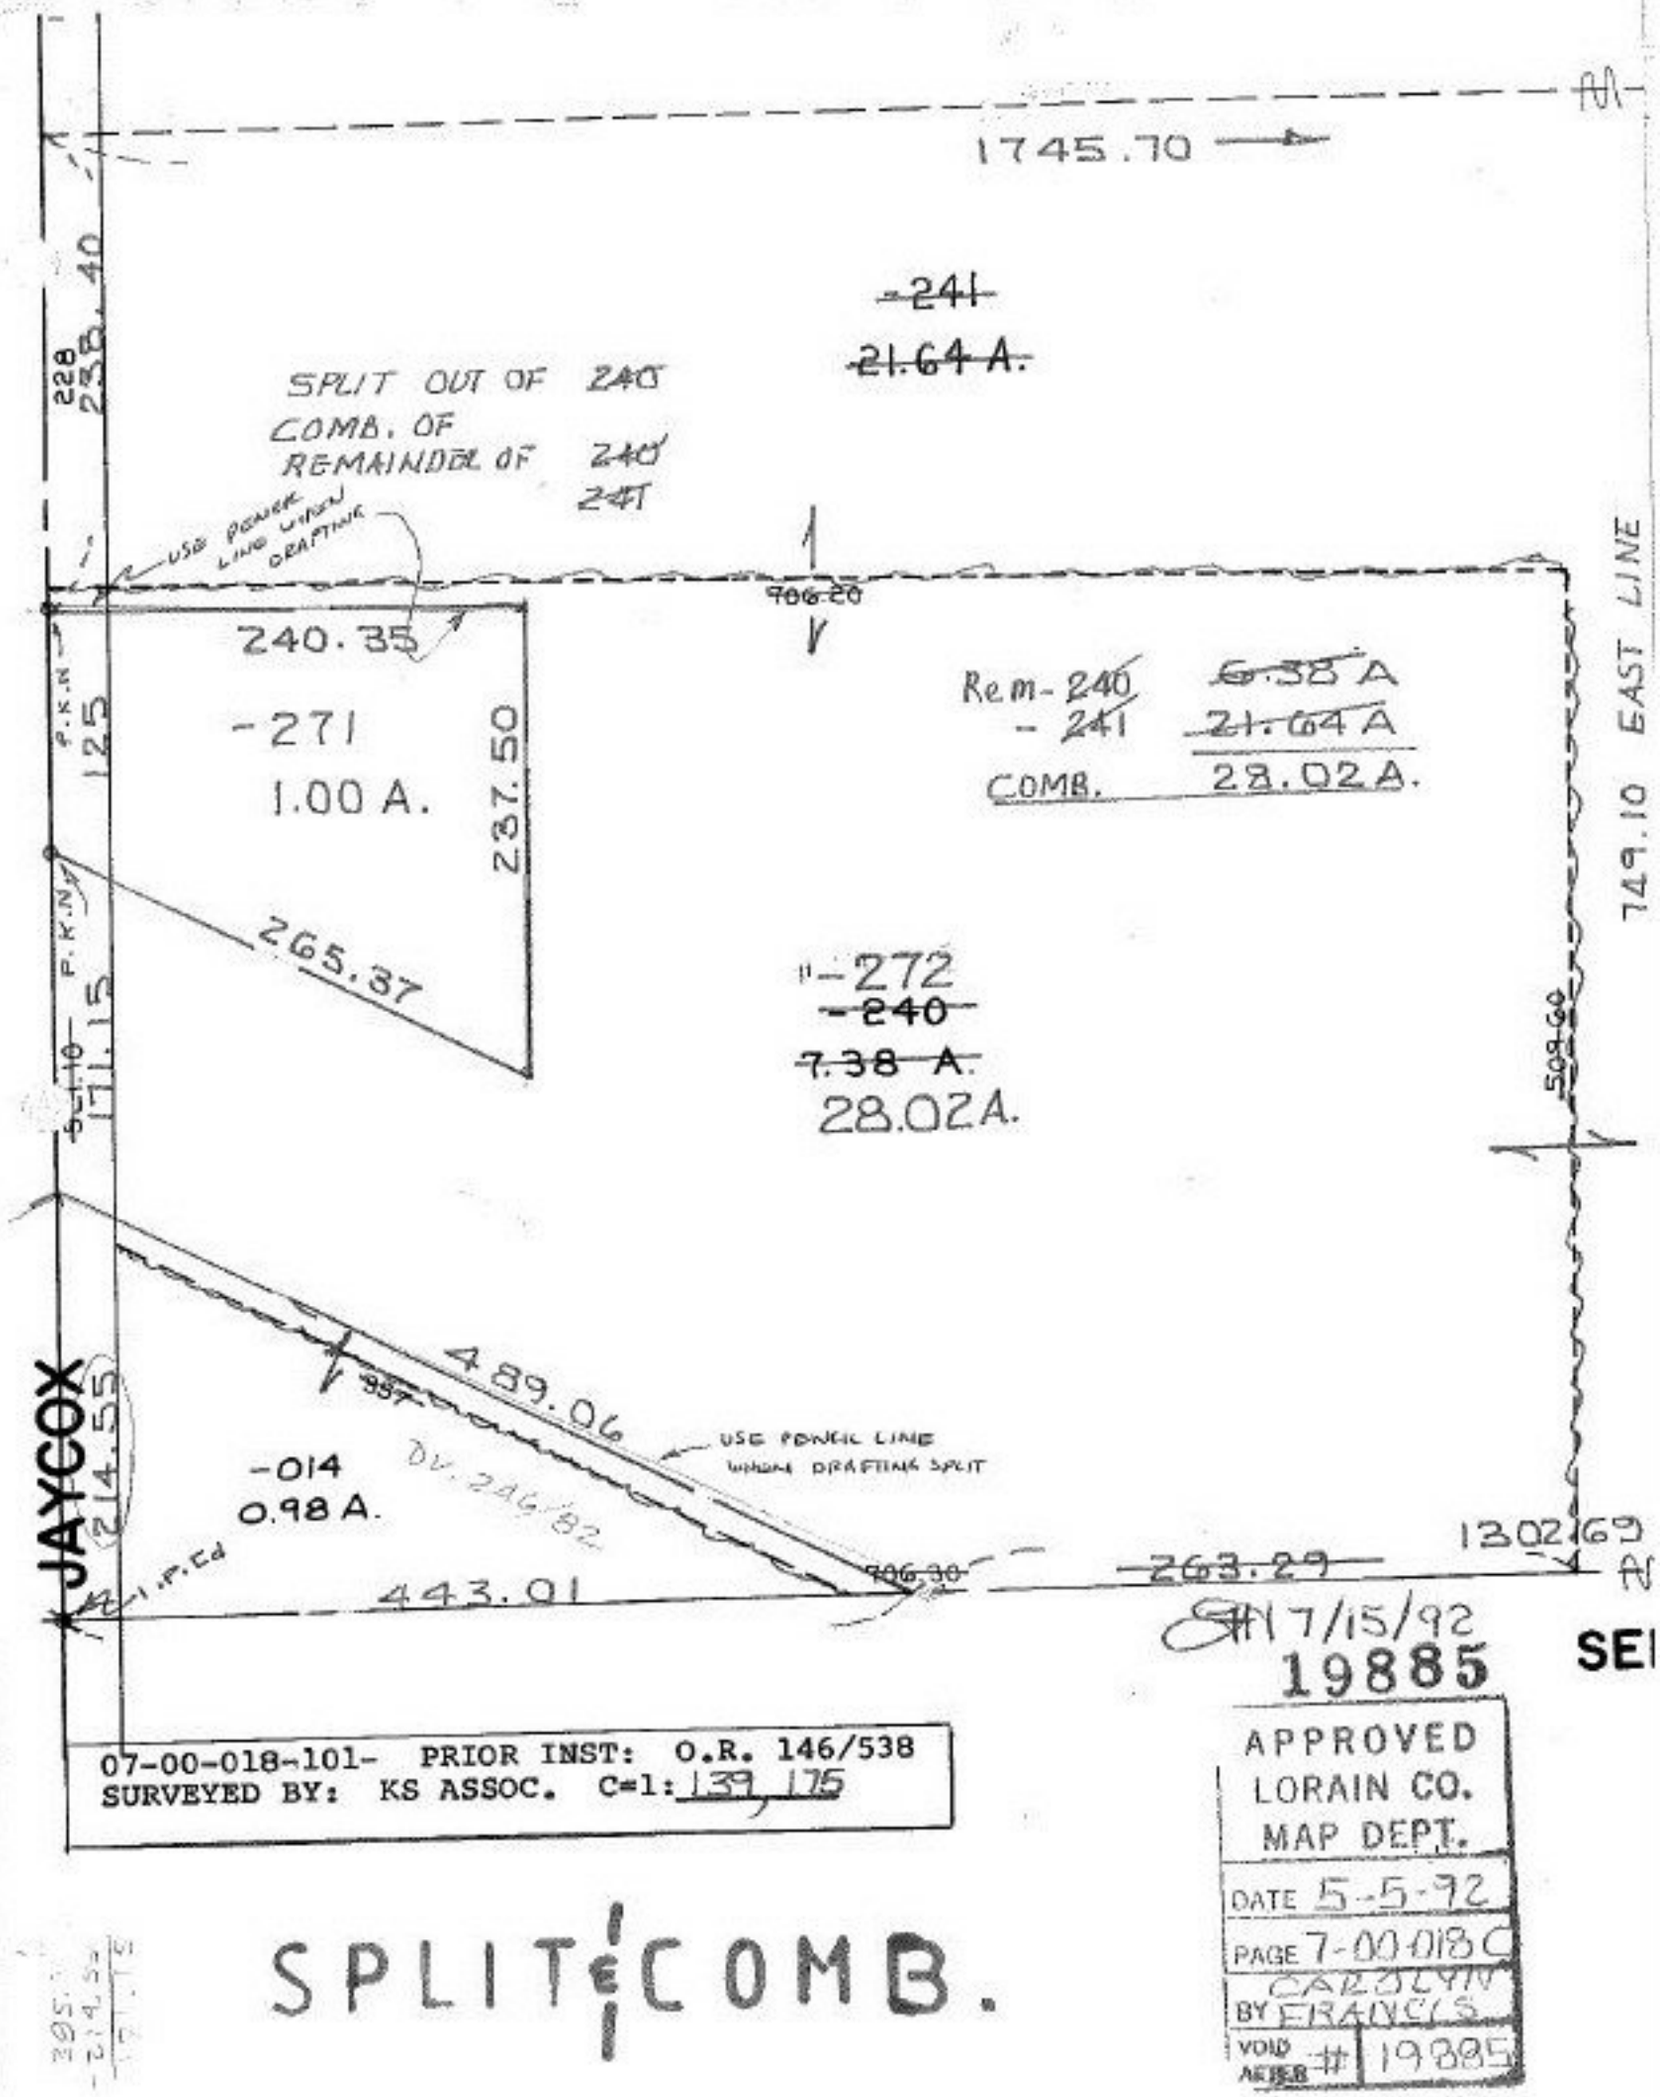
1745.70
-241
21.64 A.
SPLIT OUT OF 240
COMB. OF
REMAINDER OF 240
241
USE POWER LINE UNION DRAFTING
906.20
240.35
-271
1.00 A.
237.50
P.K.N.
125
Rem- 240 6.38 A
- 241 21.64 A
COMB. 28.02 A.
749.10 EAST LINE
265.37
-272
-240
7.38 A.
28.02A.
509.60
171.15
489.06
USE PENCIL LINE WHEN DRAFTING SPLIT
214.55
-014
0.98 A.
DV. 246/82
906.30
263.29
1302.69
443.01
JAYCOX
7/15/92
19885
APPROVED
LORAIN CO.
MAP DEPT.
DATE 5-5-92
PAGE 7-00018C
BY CAROLYN FRANCIS
VOID AFTER # 19885
07-00-018-101- PRIOR INST: O.R. 146/538
SURVEYED BY: KS ASSOC. C=1: 139, 175
SPLIT & COMB.