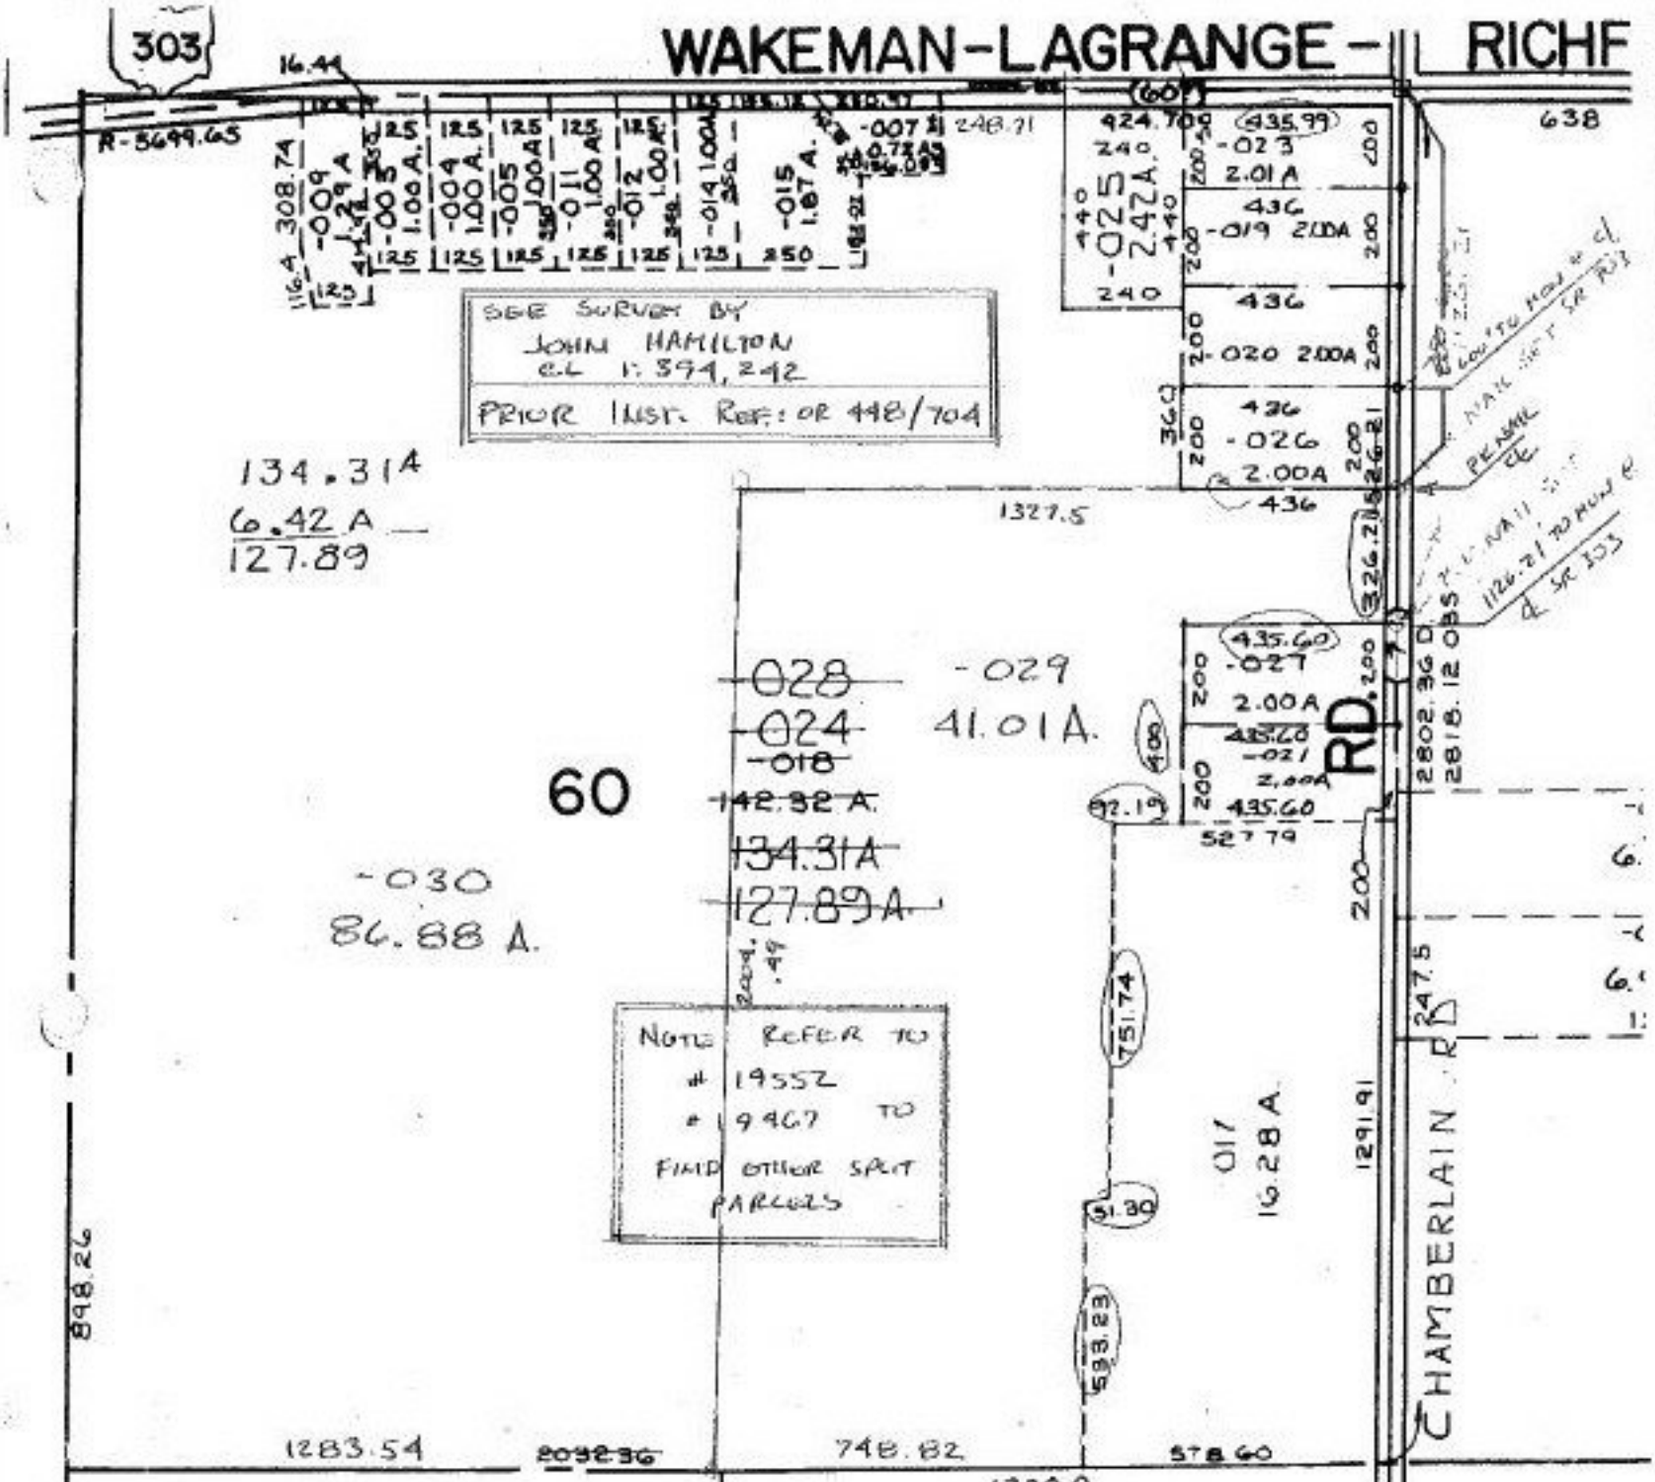

16-00-060-000- PRIOR INST. 146/52 C=1: INF. 1,2,3
SURVEYED BY: JOHN R. HAMILTON REG. SURVEYOR

APPROVED LORAIN CO. MAP DEPT.	APPROVED LORAIN CO. MAP DEPT.
DATE 5-4-92	DATE 10-24-91
PAGE 16-E	PAGE 16-E
BY T. McNair	BY CAROLYN FRANCIS
VOID AFTER 19889	VOID AFTER # 19624