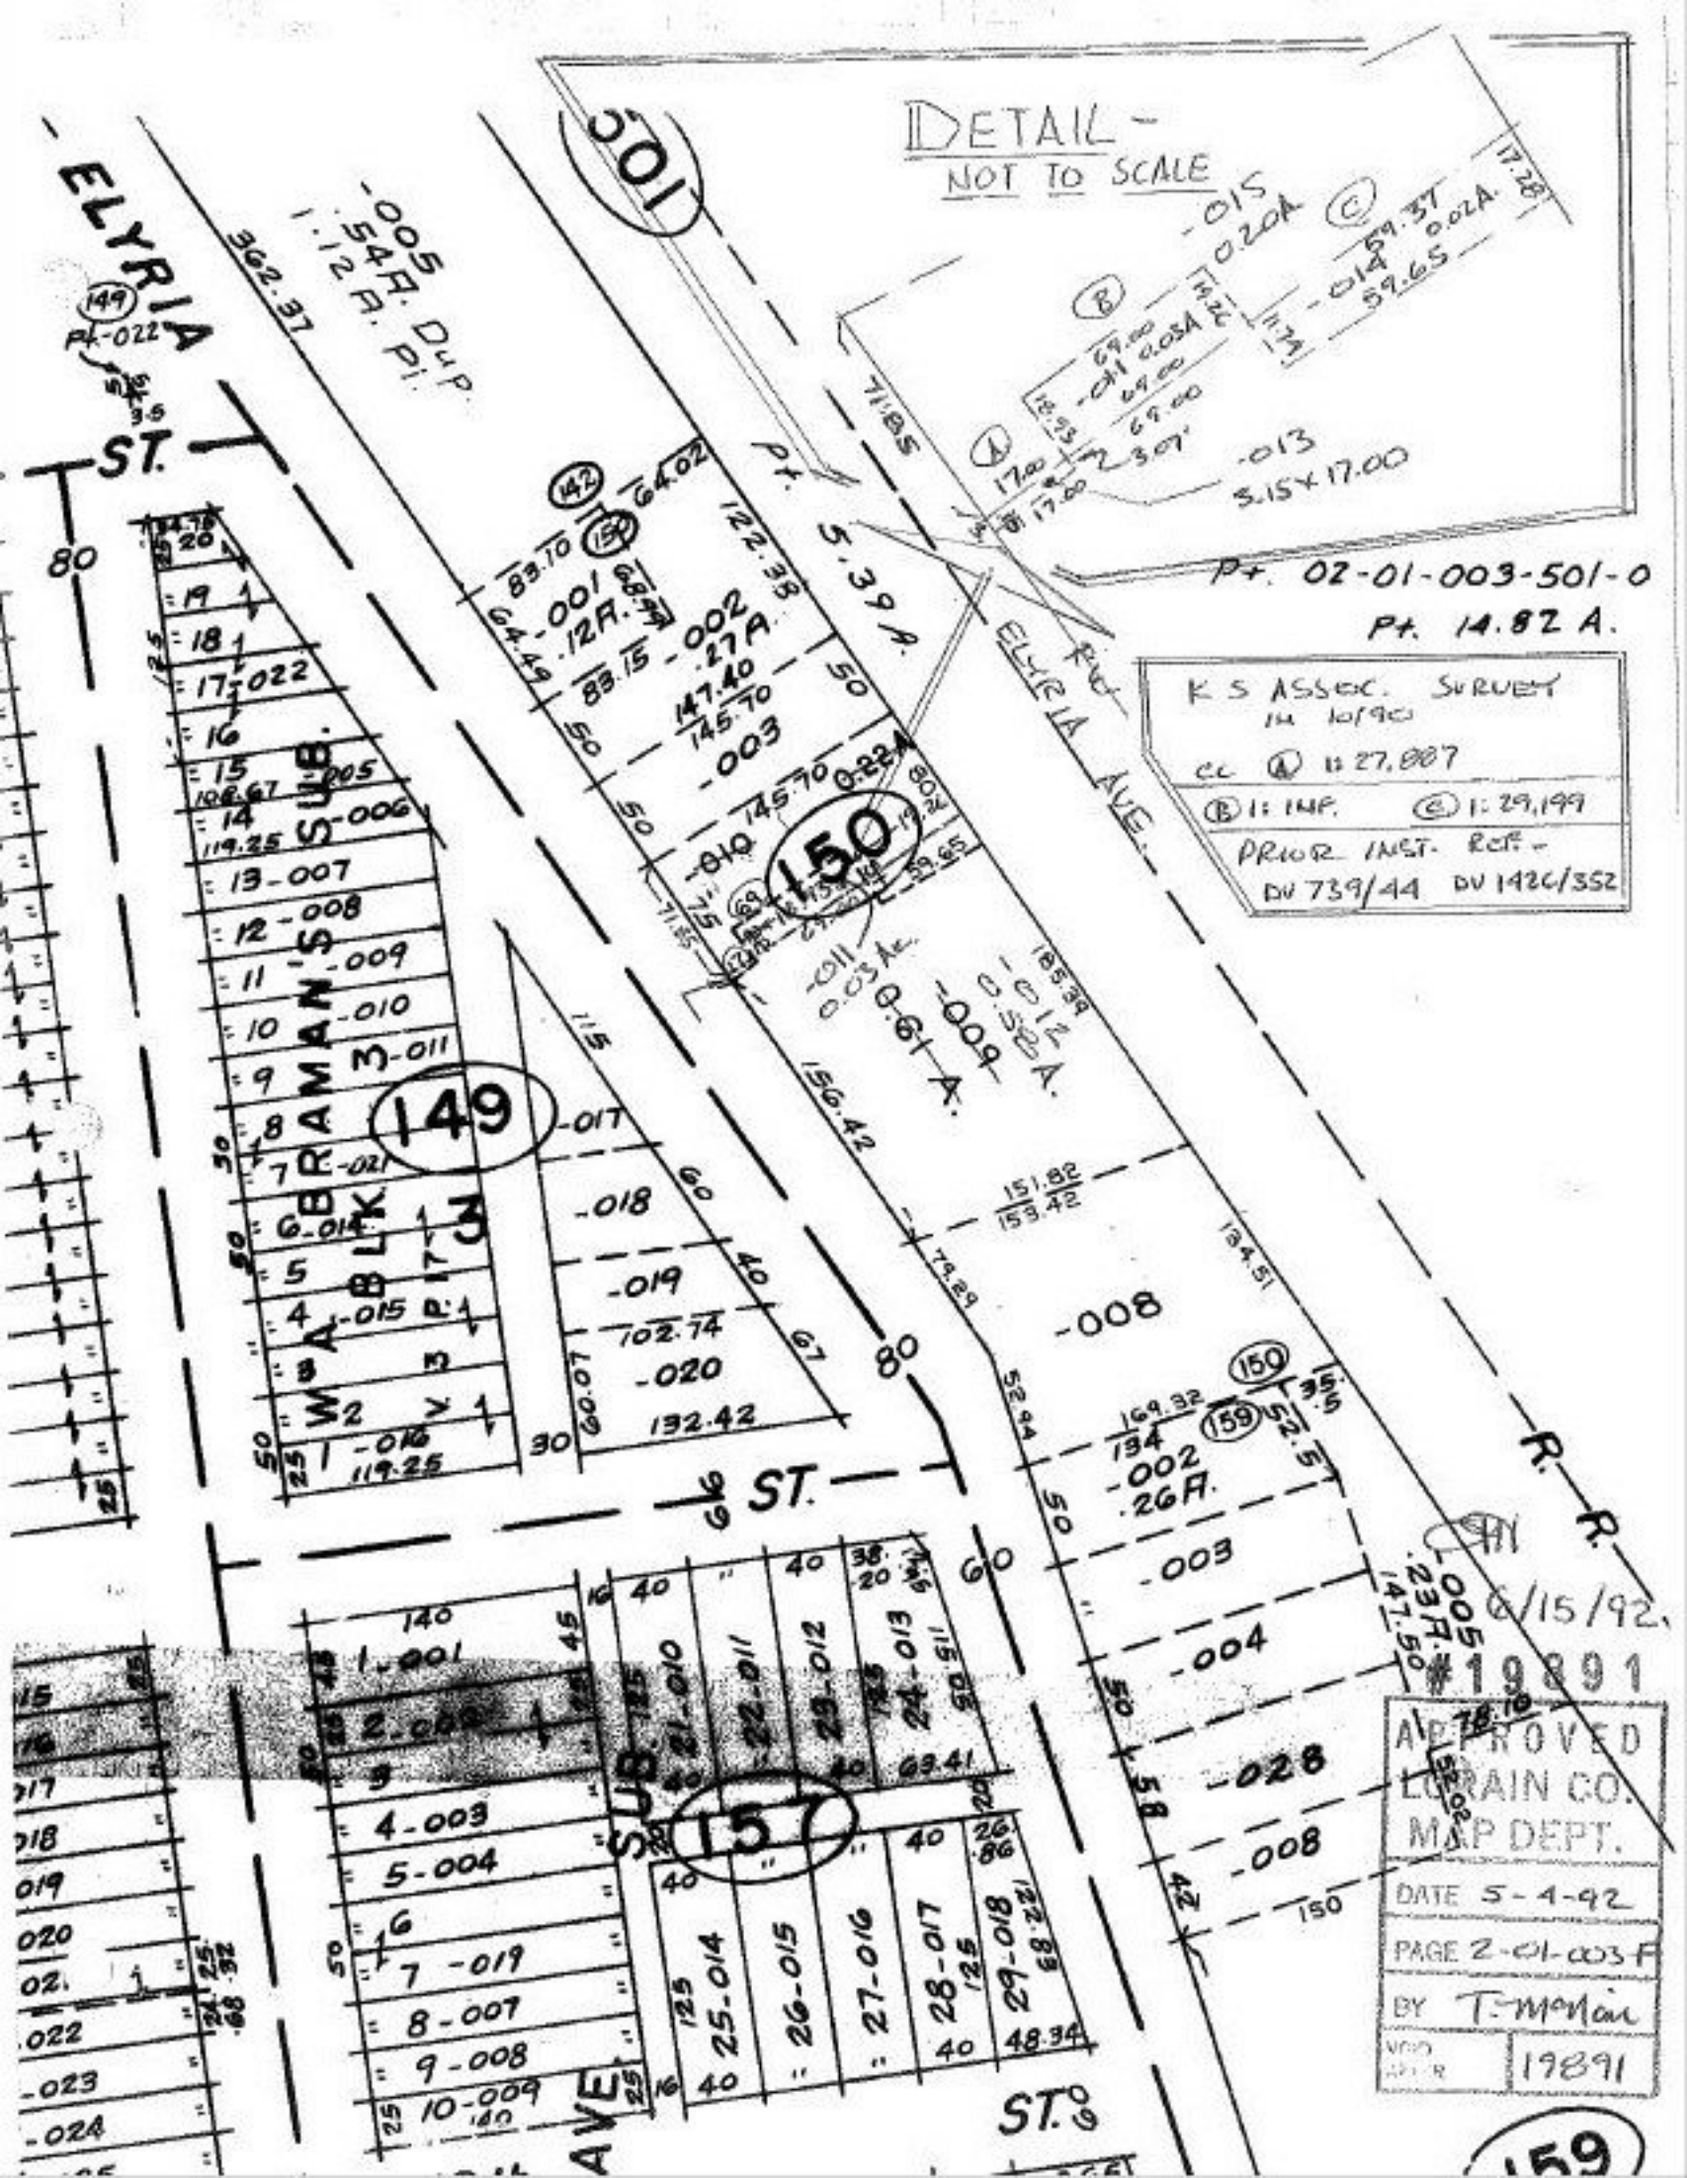
DETAIL -
NOT TO SCALE
ELYRIA
ST.
ELYRIA AVE.
R. R.
Pt. 5.39 A.
Pt. 02-01-003-501-0
Pt. 14.82 A.
K S ASSOC. SURVEY
IN 10/90
CC (A) 1: 27,887
(B) 1: INF. (C) 1: 29,199
PRIOR INST. REF. -
DV 739/44 DV 1426/352
WA BRAMAN'S SUB.
BLK 3
149
150
157
159
6/15/92
#19891
APPROVED
LORAIN CO.
MAP DEPT.
DATE 5-4-92
PAGE 2-01-003 F
BY T. McNair
VOID AFTER 19891