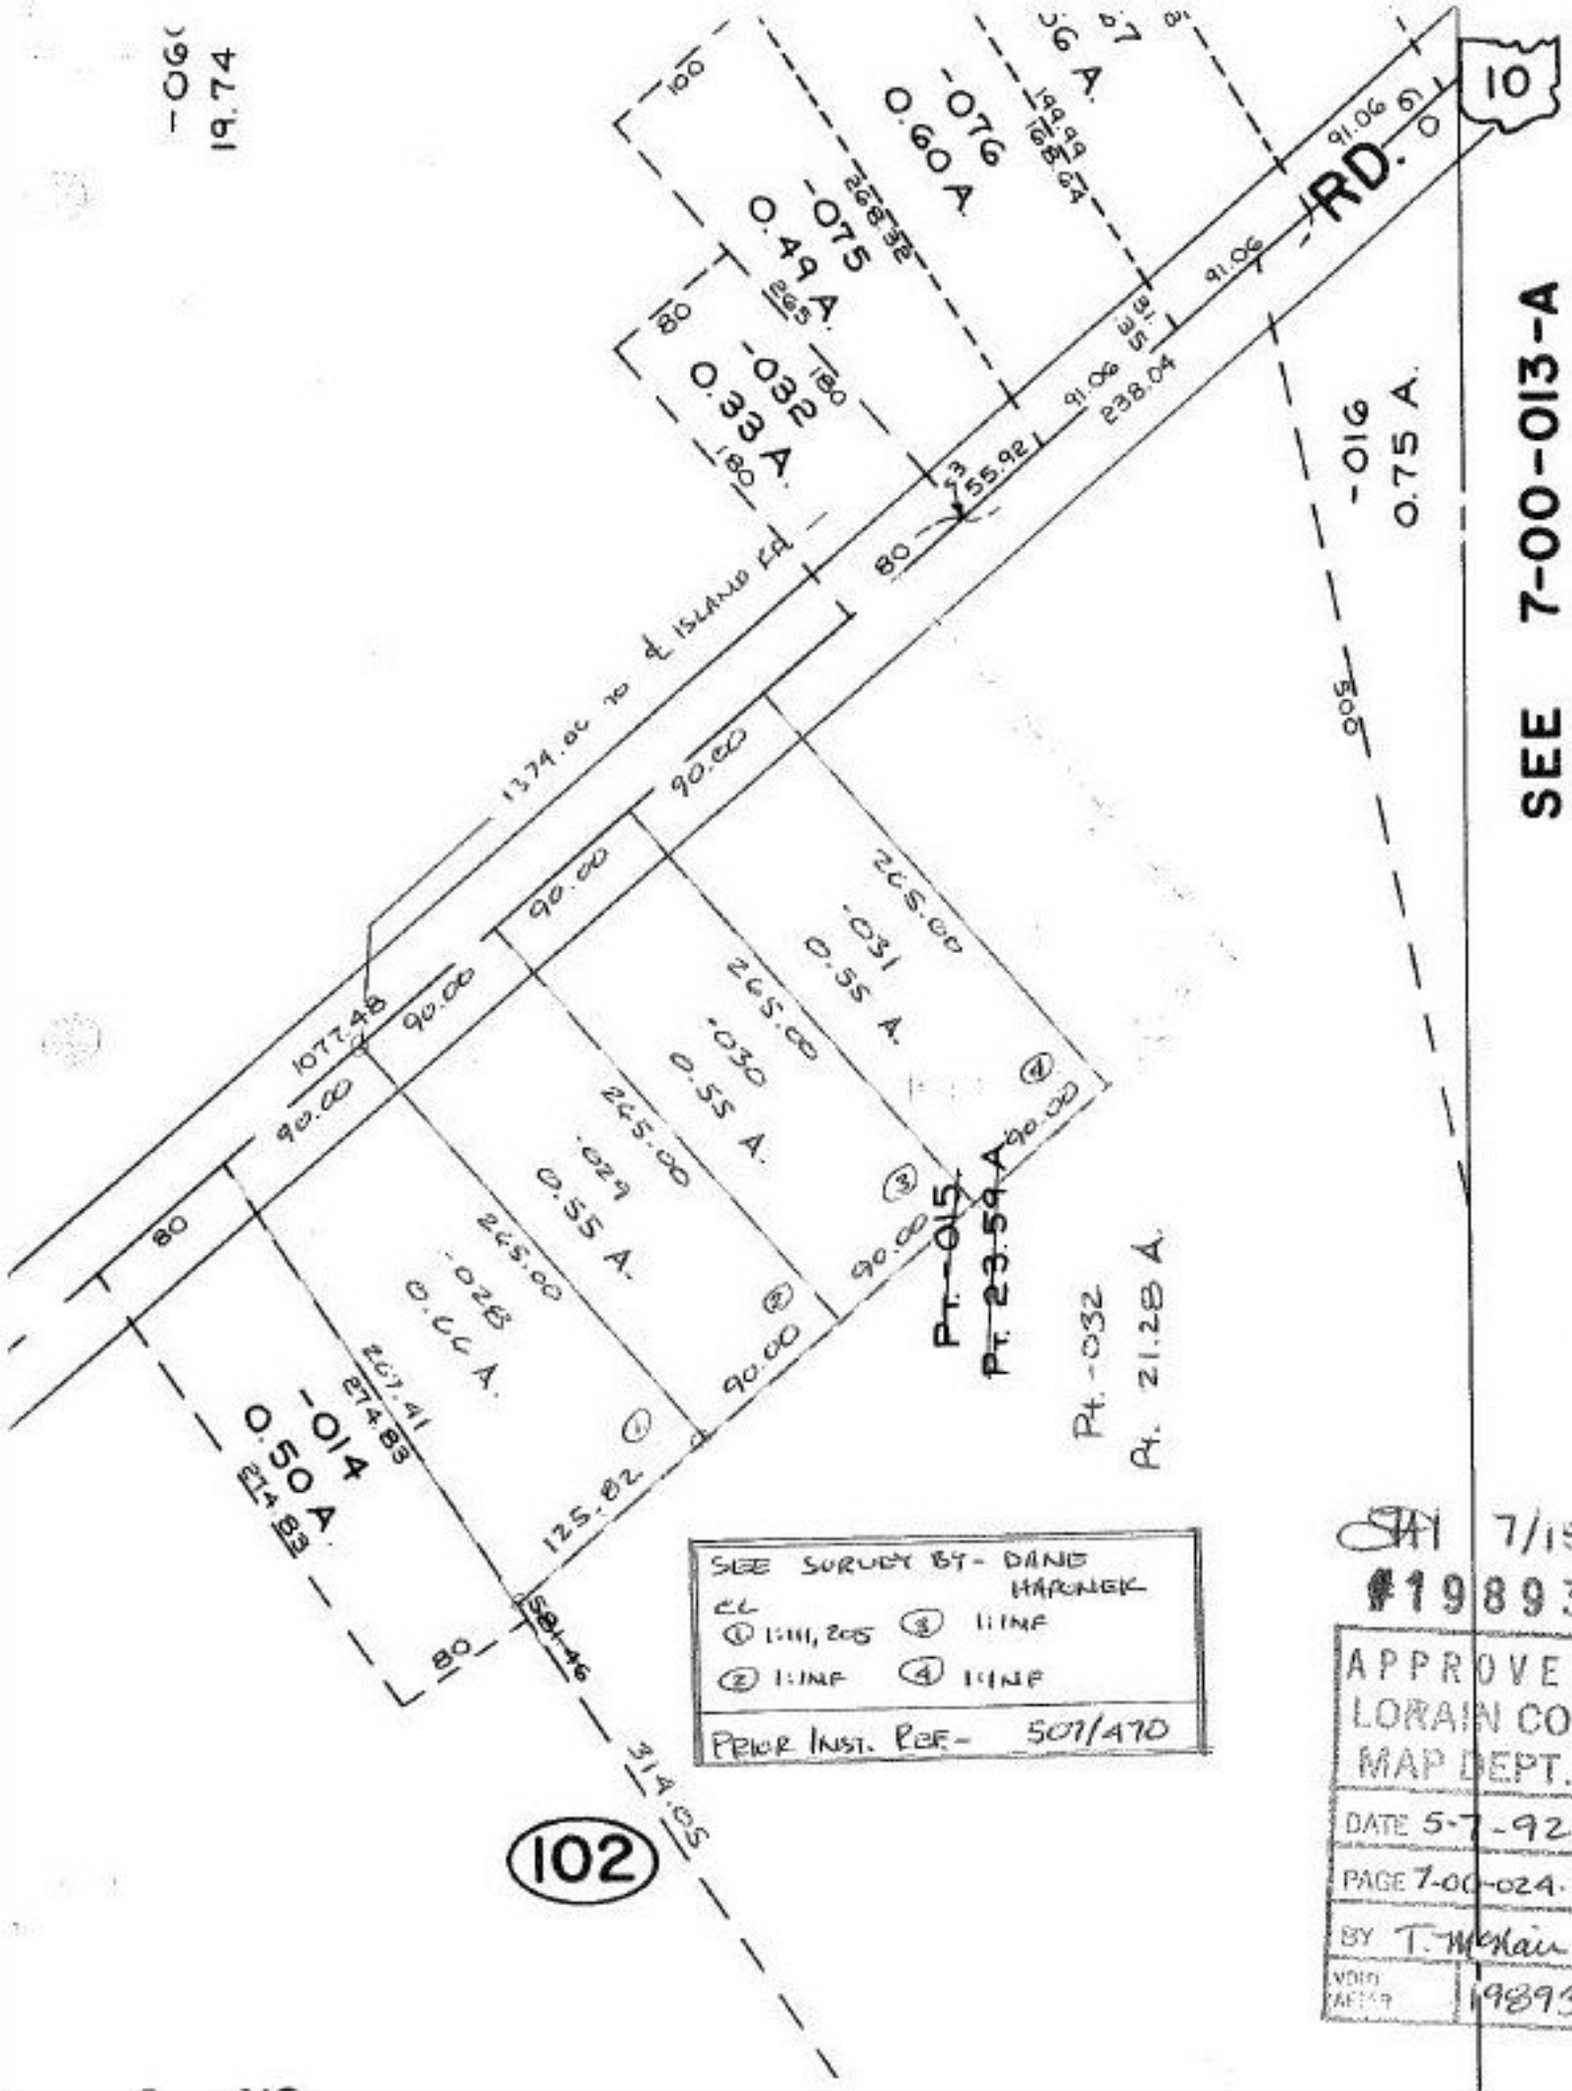

SHY 7/15/92

#19893

APPROVED
LORAIN CO.
MAP DEPT.

DATE 5-7-92

PAGE 7-00-024.B

BY T. McNair

VOID AFTER 19893