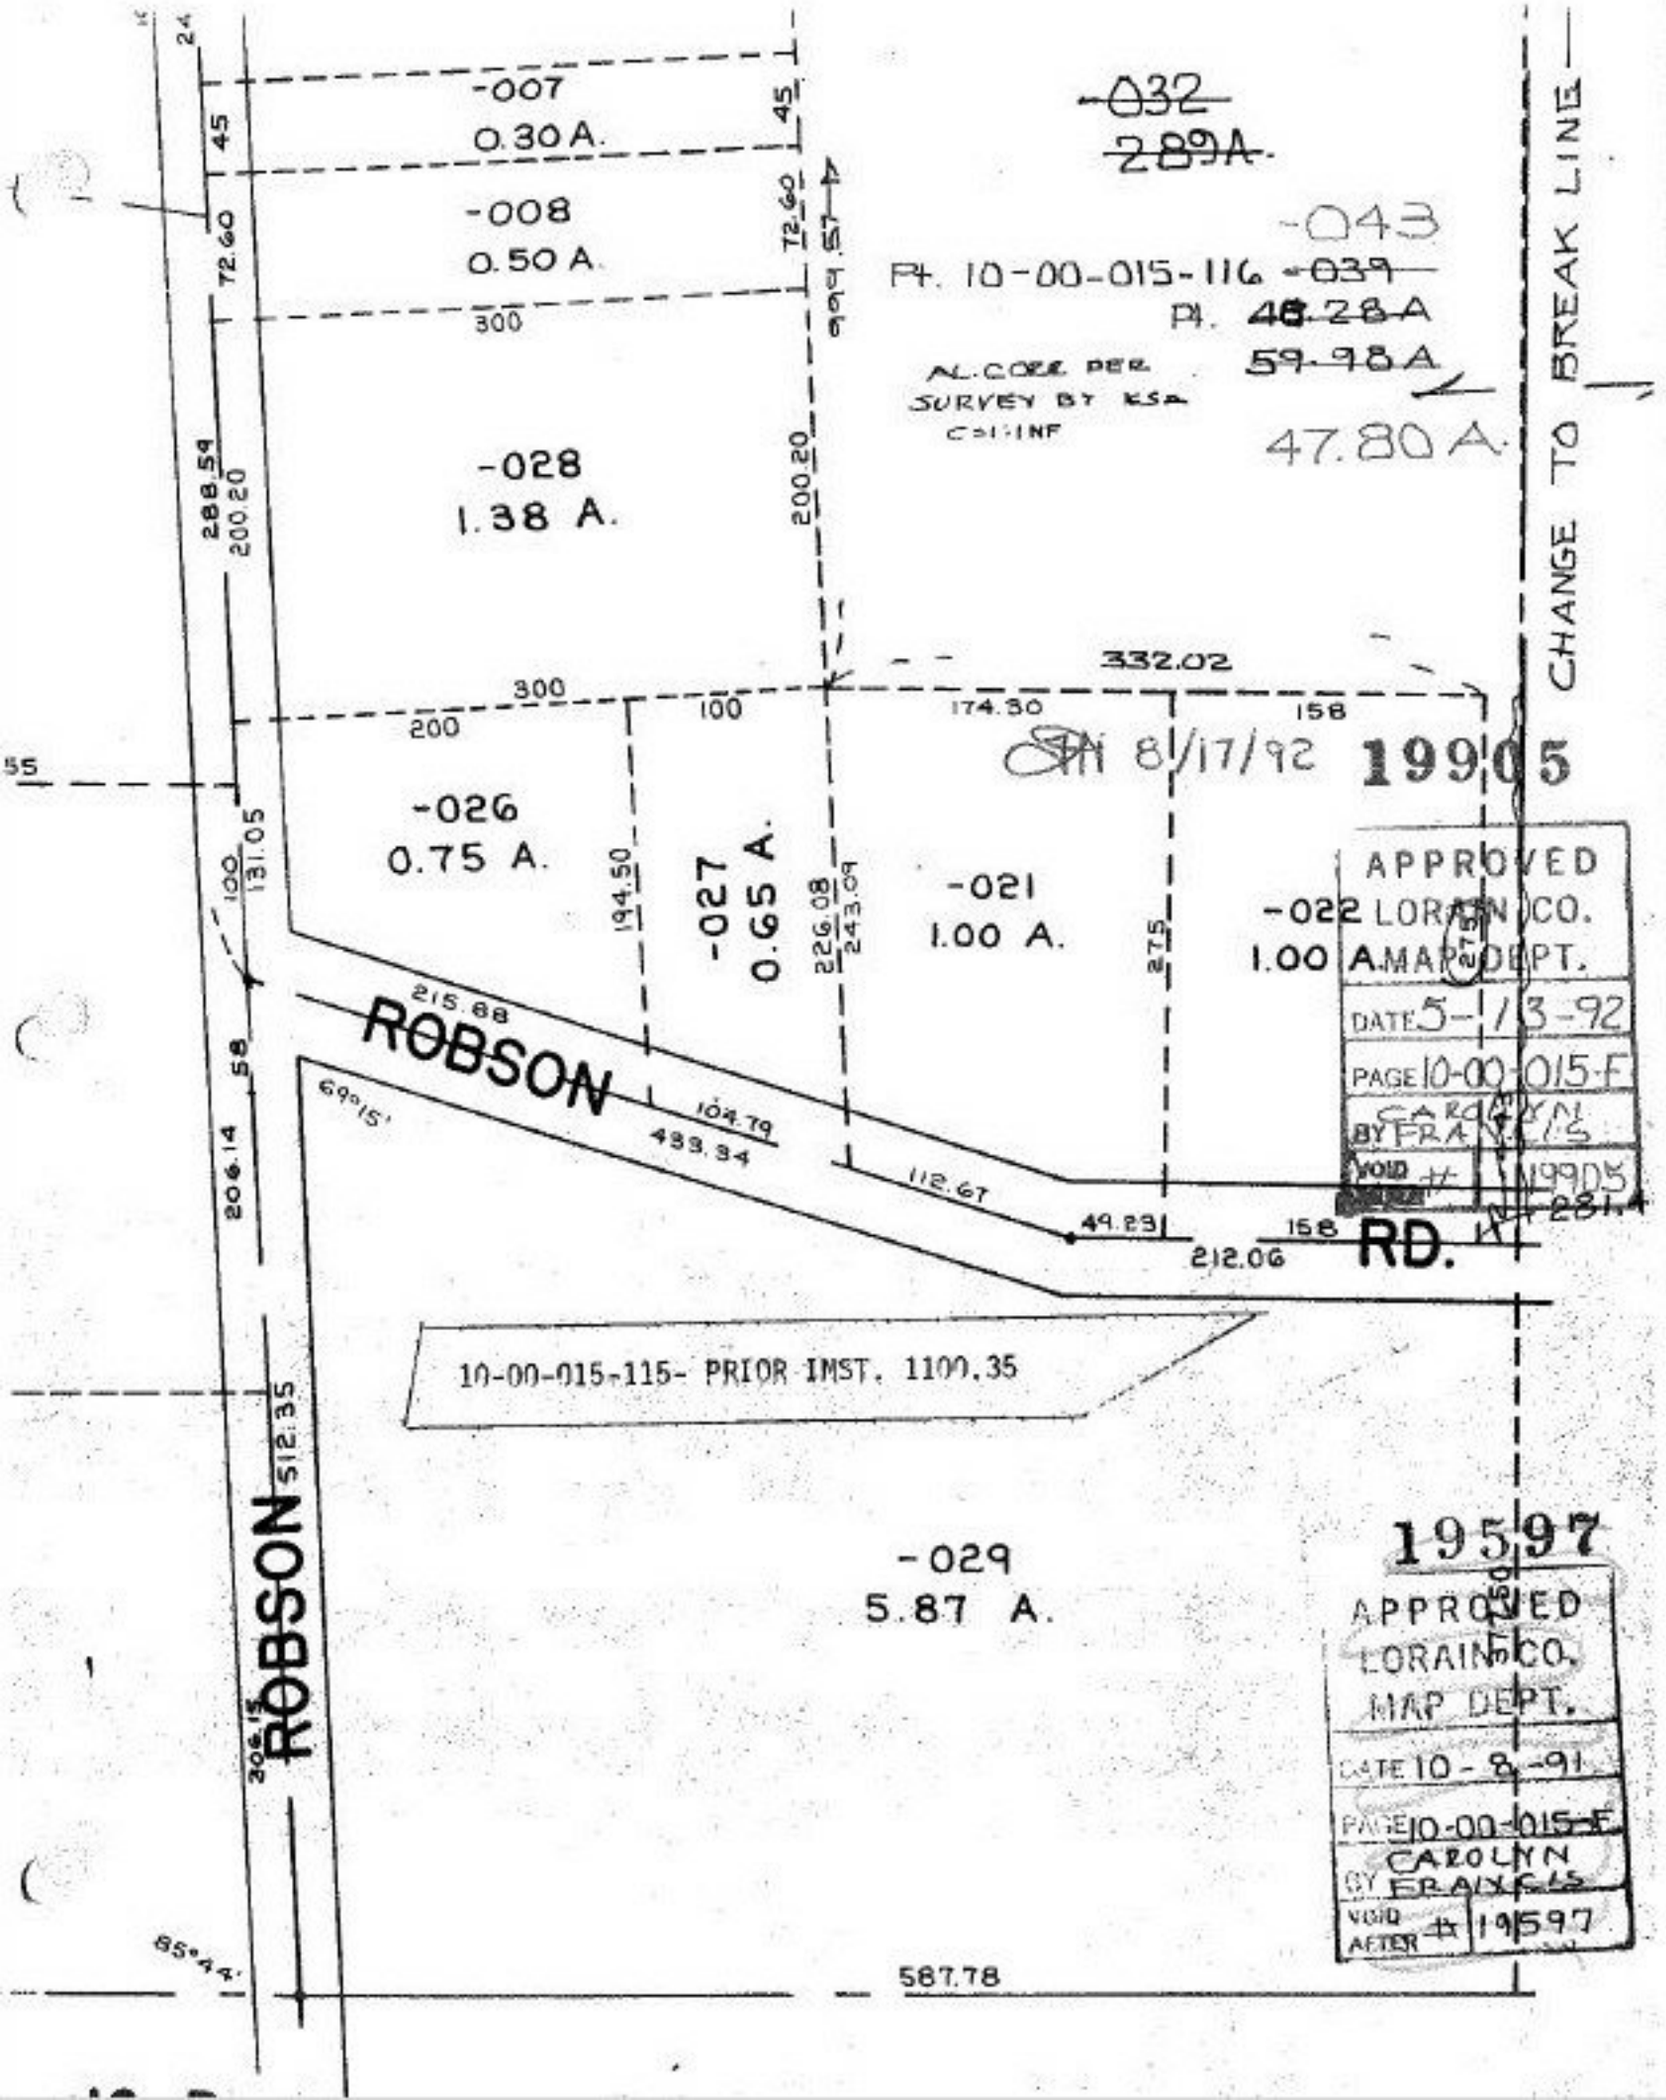


19905

8/17/92

19597