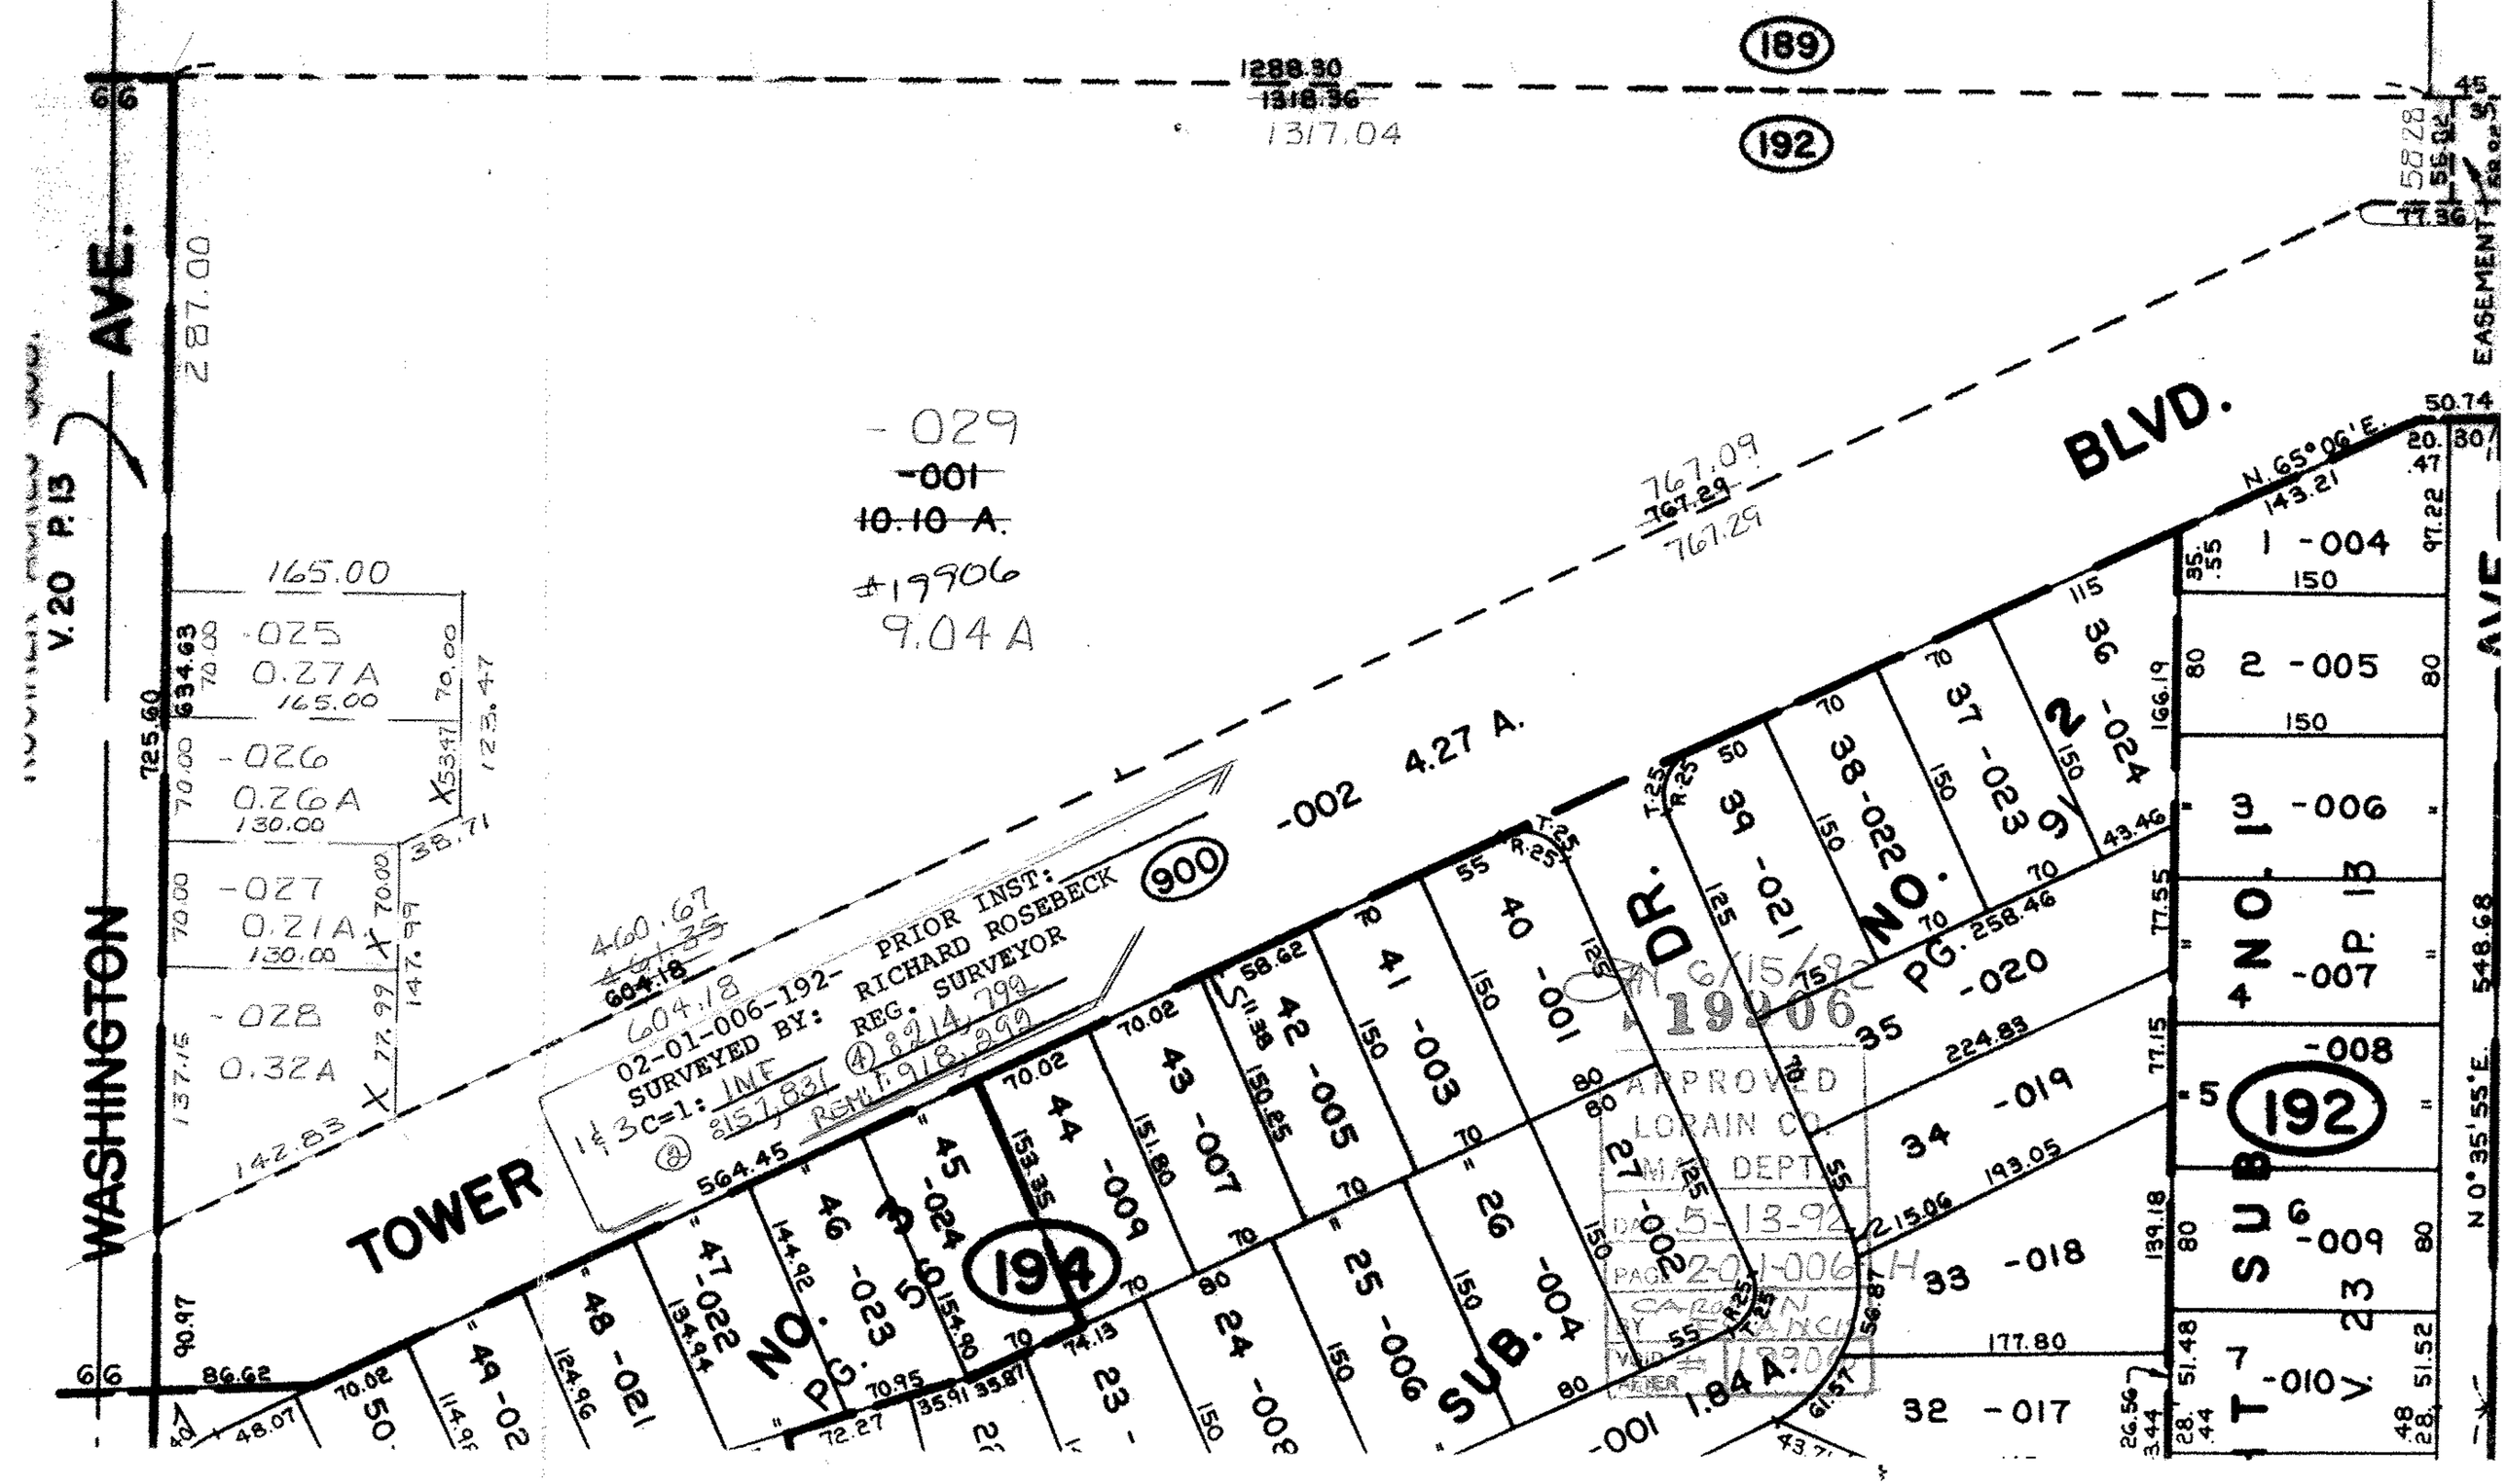
189
192
1288.30
1318.36
1317.04
66
AVE.
V. 20 P. 13
287.00
165.00
-025
0.27A
165.00
634.63
70.00
-026
0.26A
130.00
-027
0.21A
130.00
-028
0.32A
142.83
137.15
WASHINGTON
TOWER
-029
-001
10.10 A.
#19906
9.04 A
767.09
767.29
767.29
BLVD.
N.65°06'E.
143.21
50.74
20.47
97.22
EASEMENT
AVE
4.27 A.
-002
460.67
460.35
604.18
604.18
02-01-006-192- PRIOR INST:
SURVEYED BY: RICHARD ROSEBECK
1 & 3 C=1: INF REG. SURVEYOR
#15,831 #8214,799
REM. 918,299
900
564.45
DR.
PG. 258.46
NO.
SUB.
194
192
1.84 A.
APPROVED
LORAIN CO.
MAP DEPT
DATE 5-13-92
PAGE 2-01-006
CARD
BY
MAP #
OWNER
1-004
2-005
3-006
4-007
5-008
6-009
7-010
-020
-019
-018
-017
-021
-022
-023
-024
-027
-026
-025
-028
-001
-002
N 0°35'55"E.
548.68