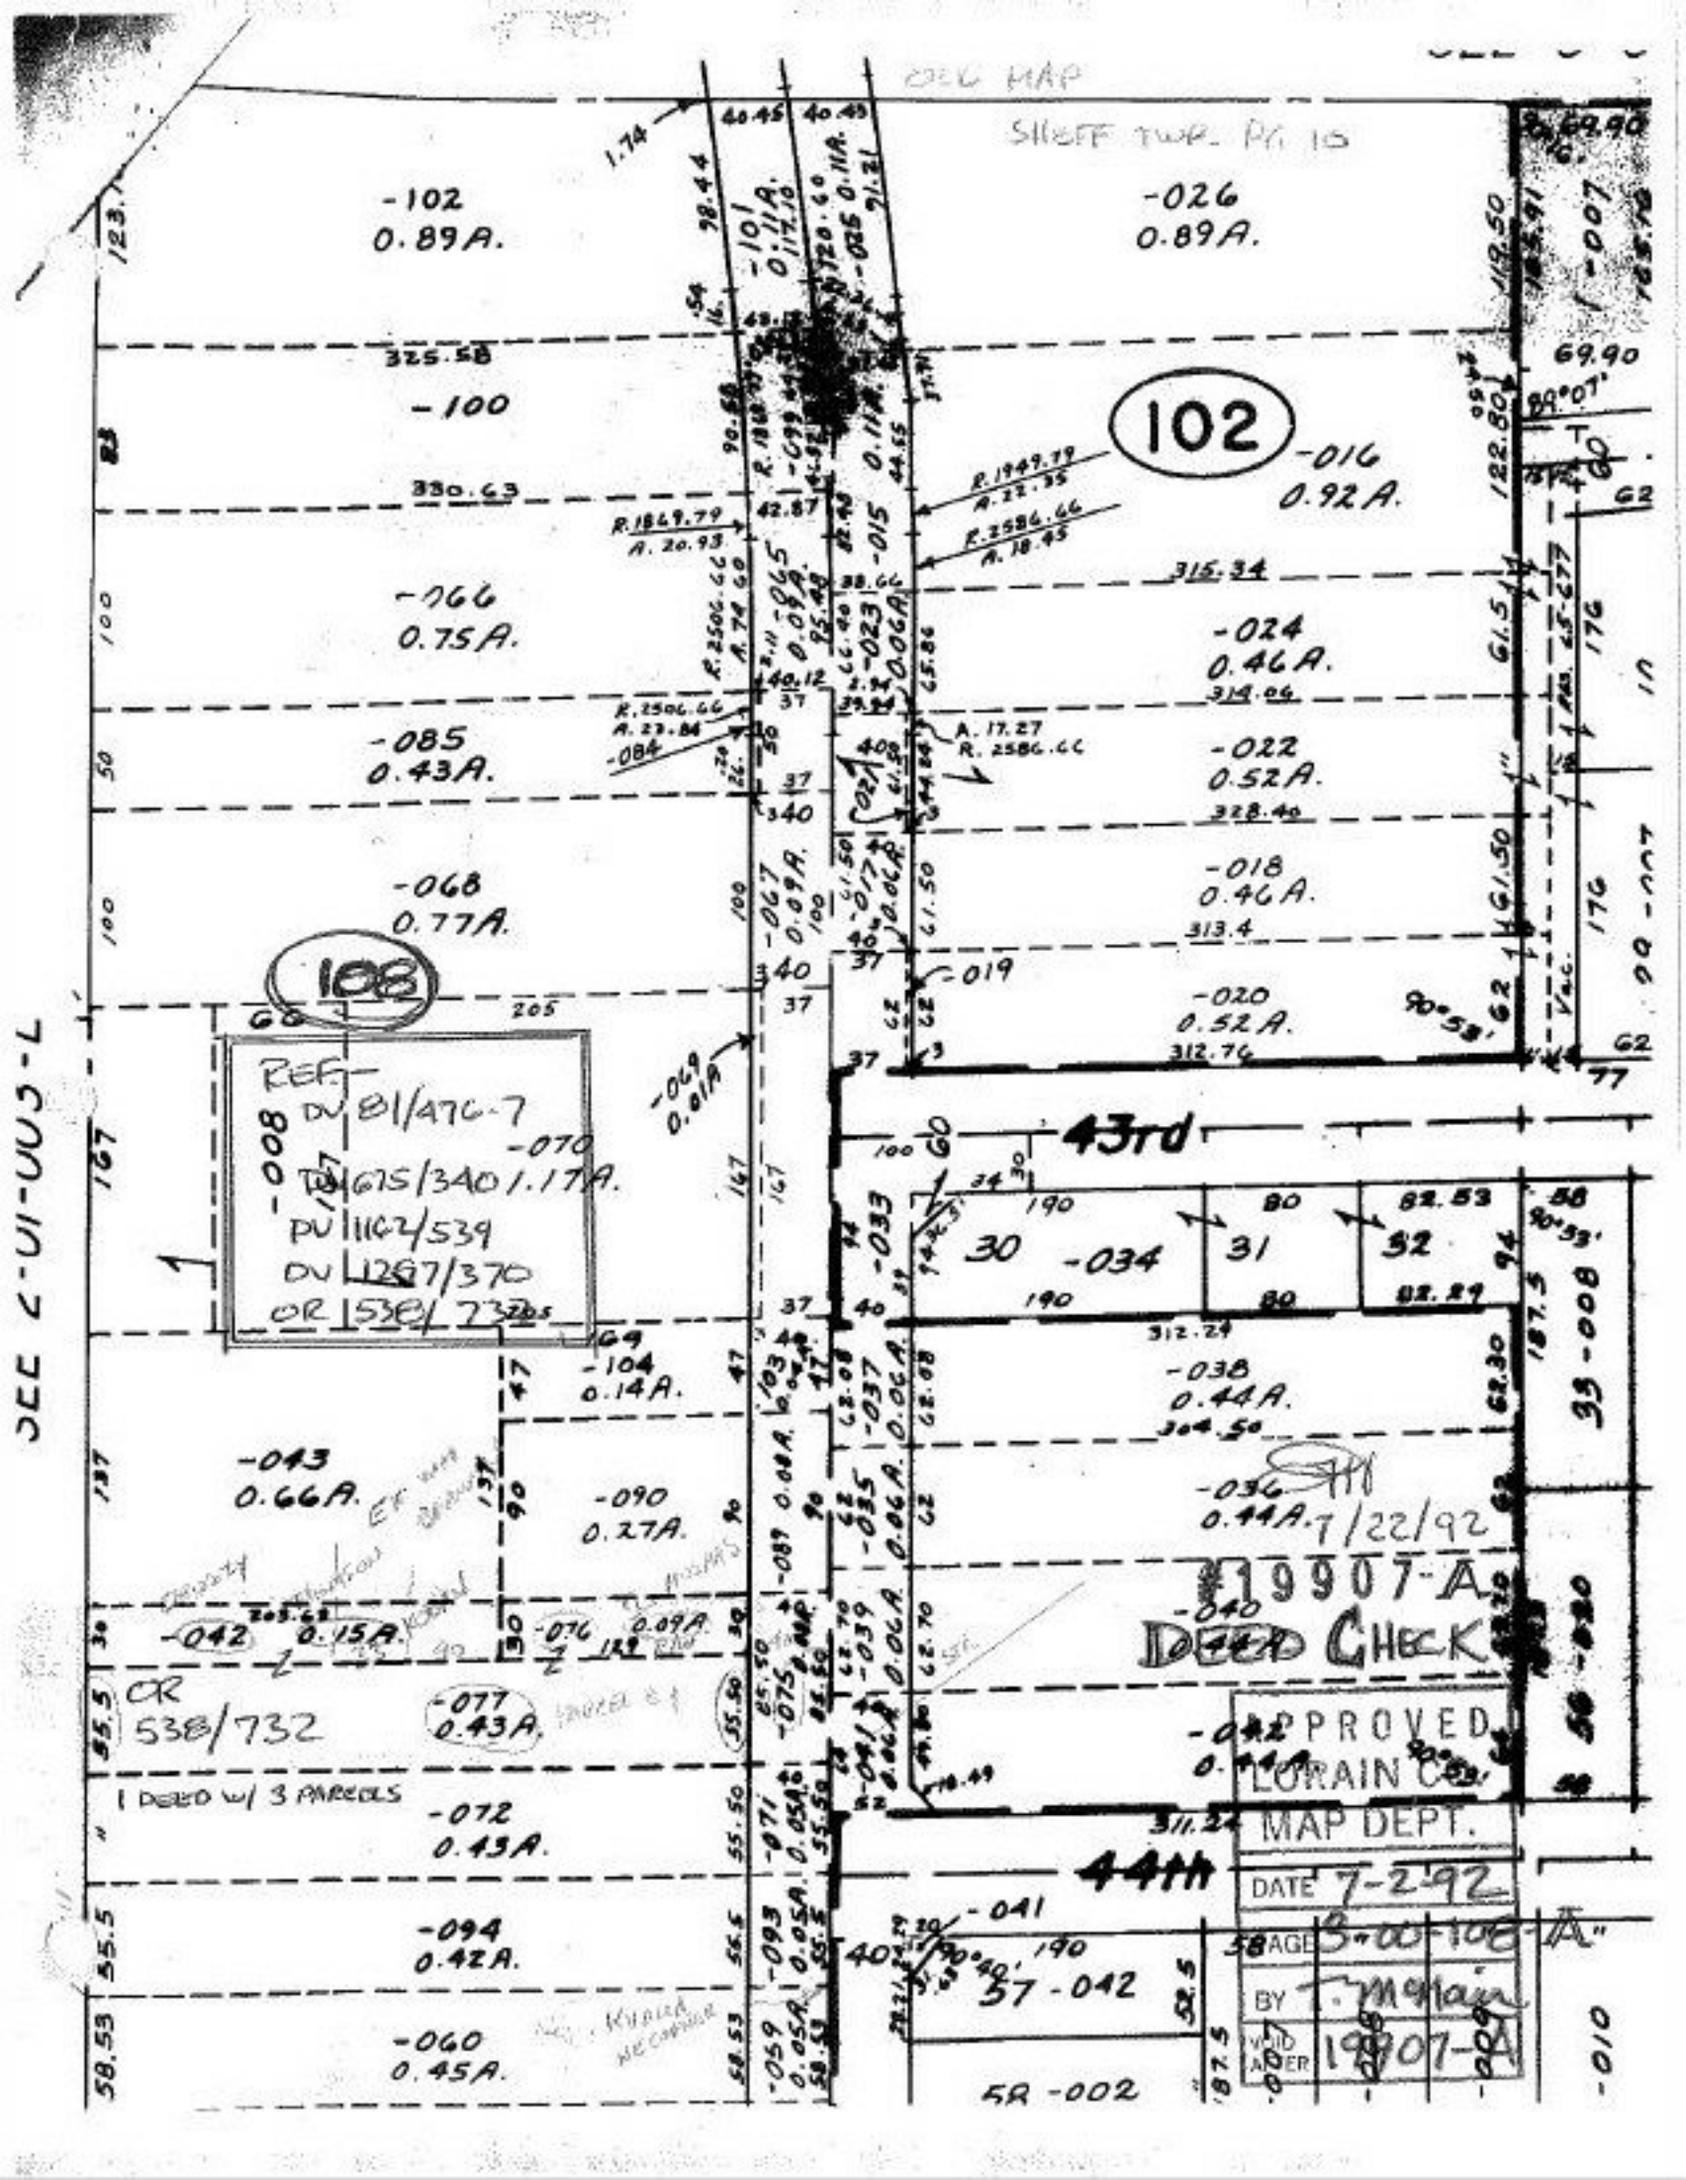
OLD MAP
SHEFF TWP. PG. 15
-102
0.89A.
-101
0.11A.
-026
0.89A.
325.58
-100
102
-016
0.92A.
330.63
-066
0.75A.
-015
0.09A.
-024
0.46A.
-085
0.43A.
-084
-023
0.06A.
-022
0.52A.
-068
0.77A.
-067
0.09A.
-018
0.46A.
108
-019
-020
0.52A.
REF:
DV 81/476-7
-070
675/340 1.17A.
PU 1162/539
DV 1267/370
OR 538/732
-069
0.01A.
43rd
-008
-104
0.14A.
30
-034
31
32
-033
-038
0.44A.
-043
0.66A.
-090
0.27A.
-036
0.44A.
7/22/92
19907-A
DEED CHECK
-042
0.15A.
-076
0.09A.
-040
-077
0.43A.
OR
538/732
APPROVED
LORAIN CO.
MAP DEPT.
DATE 7-2-92
PAGE 3-00-10E-A"
BY T. McMain
VOID AFTER 19907-A
1 DEED w/ 3 PARCELS
-072
0.43A.
-071
0.05A.
-041
0.44A.
44th
-094
0.42A.
-093
0.05A.
37-042
-060
0.45A.
-059
0.05A.
5R-002
-010
SEC 2-UI-UU3-L