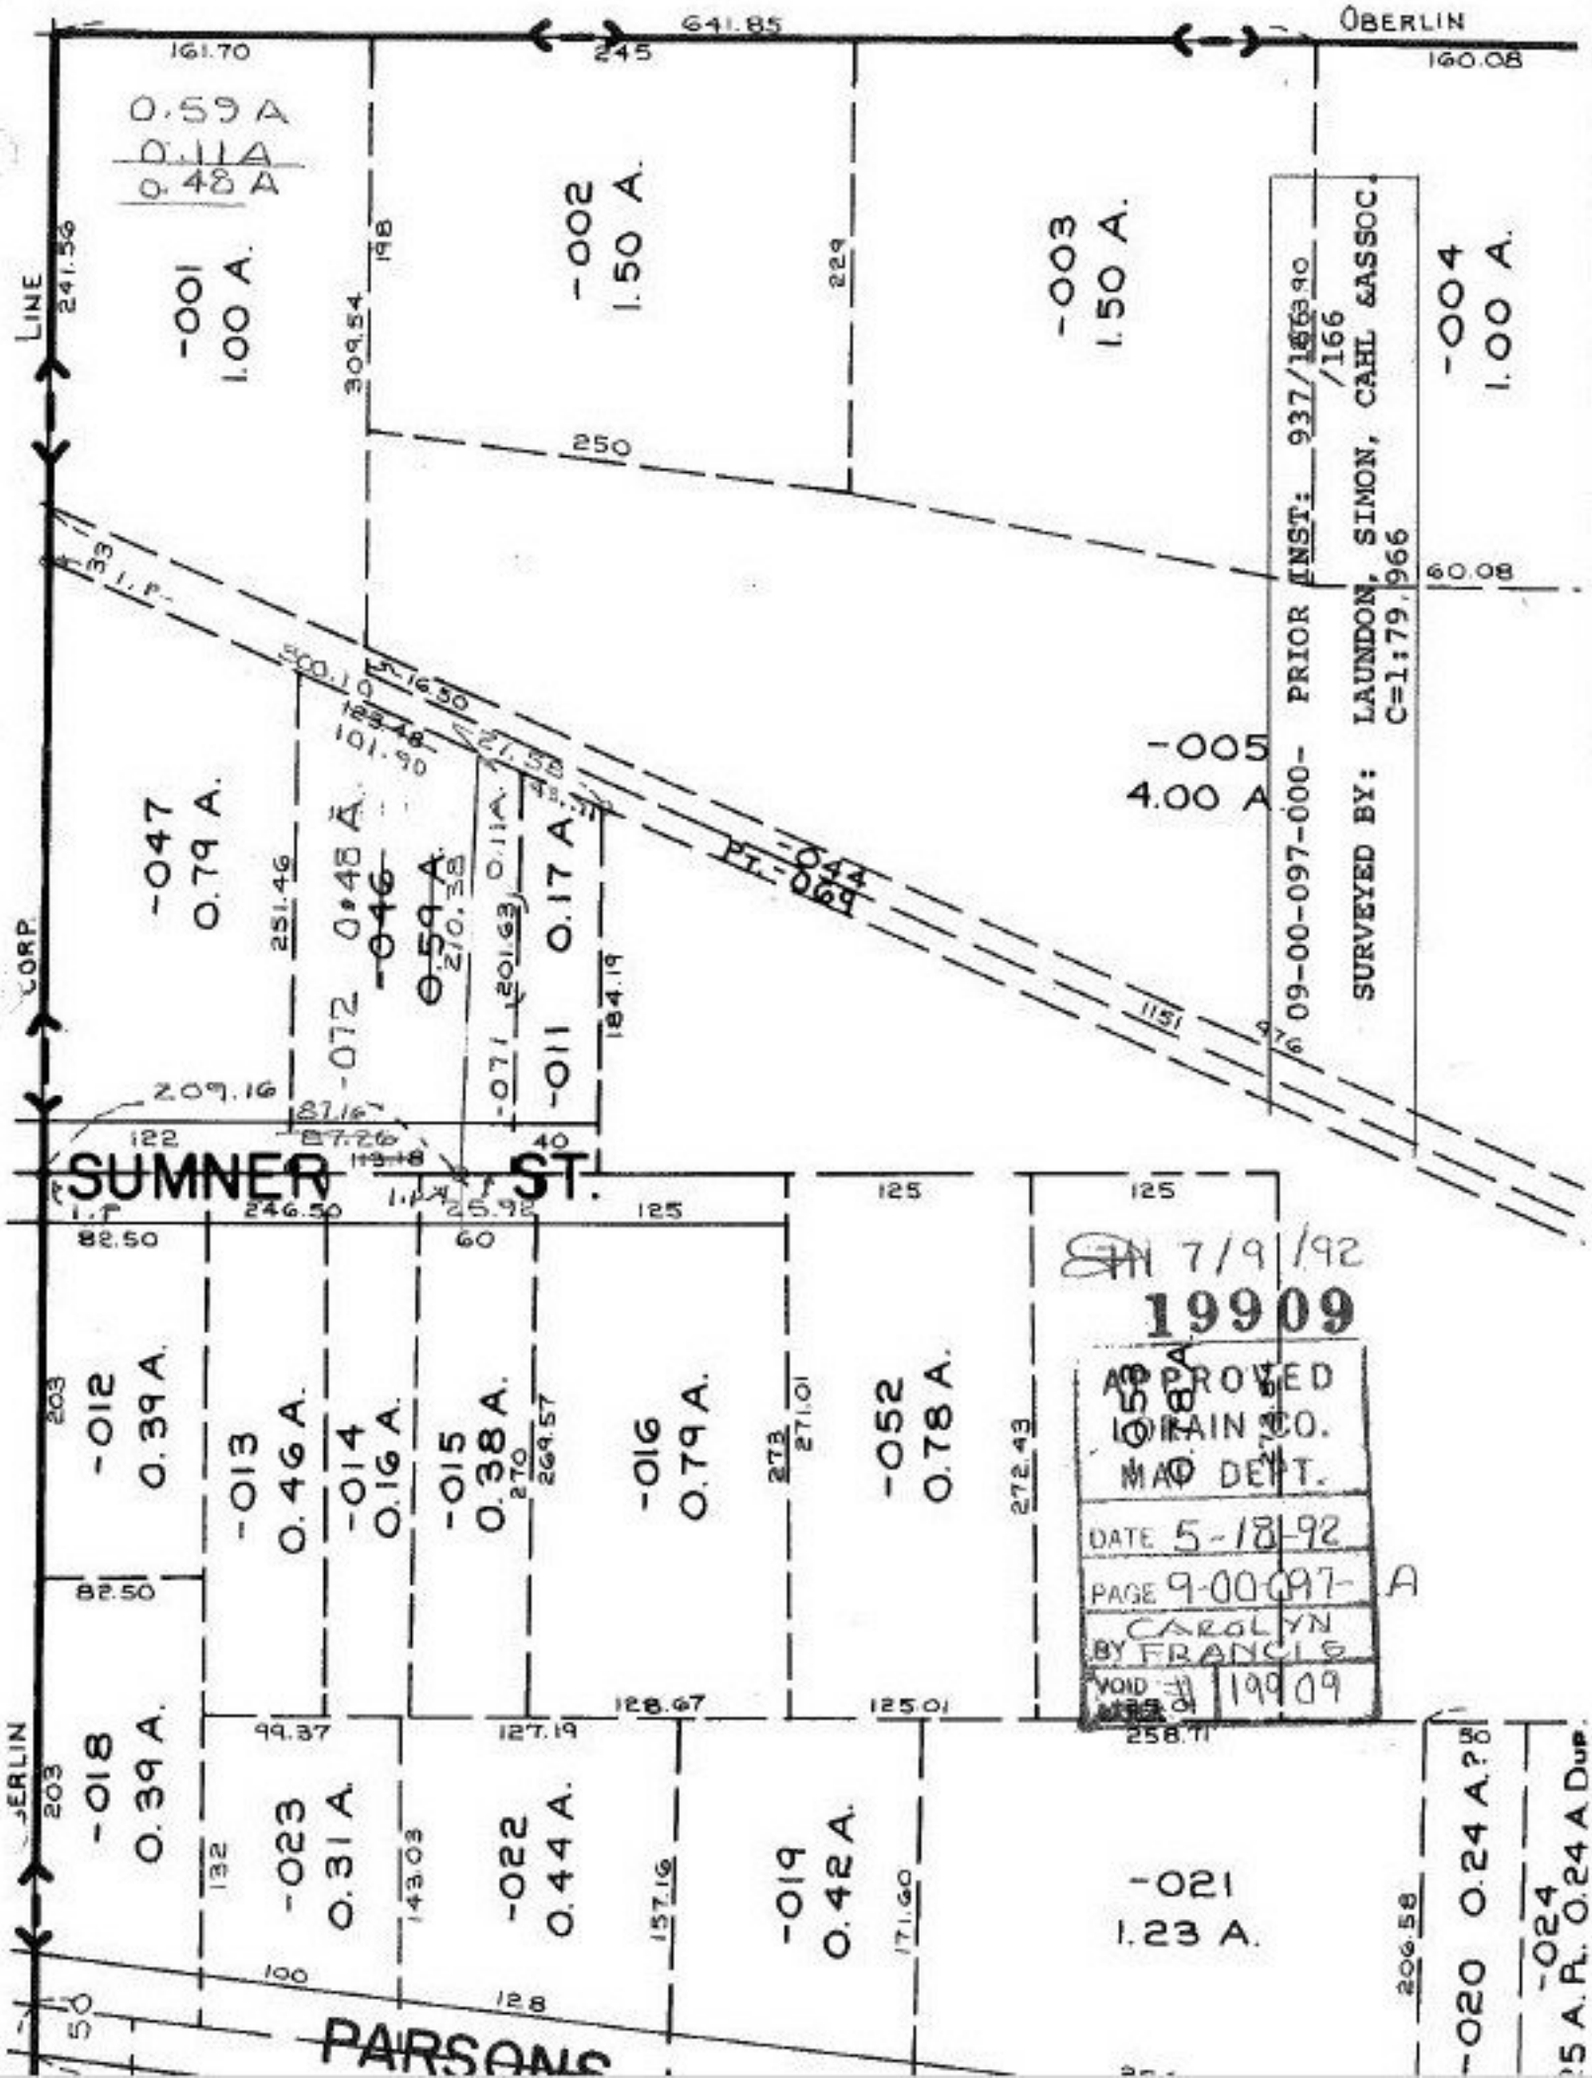

OBERLIN
641.85
161.70
245
160.08
0.59 A
0.11 A
0.48 A
-001
1.00 A.
-002
1.50 A.
-003
1.50 A.
-004
1.00 A.
LINE
241.56
309.54
198
229
250
60.08
PRIOR INST: 937/166
/166
09-00-097-000-
SURVEYED BY: LAUNDON, SIMON, CAHL &ASSOC.
C=1:79,966
-005
4.00 A
-047
0.79 A.
-072
0.48 A.
-046
0.59 A.
-011
0.17 A.
-044
PT. -069
CORP.
251.46
210.38
201.63
184.19
209.16
87.16
87.26
122
40
SUMNER ST.
82.50
246.50
25.92
60
125
125
125
7/9/92
19909
APPROVED
LORAIN CO.
MAP DEPT.
DATE 5-18-92
PAGE 9-00-097-A
CAROLYN
BY FRANCIS
VOID
19909
-012
0.39 A.
-013
0.46 A.
-014
0.16 A.
-015
0.38 A.
-016
0.79 A.
-052
0.78 A.
203
270
269.57
273
271.01
272.43
82.50
128.67
125.01
258.71
99.37
127.19
-018
0.39 A.
-023
0.31 A.
-022
0.44 A.
-019
0.42 A.
-021
1.23 A.
132
143.03
157.16
171.60
206.58
50
-020
0.24 A.?
-024
0.24 A Dup.
100
128
PARSONS