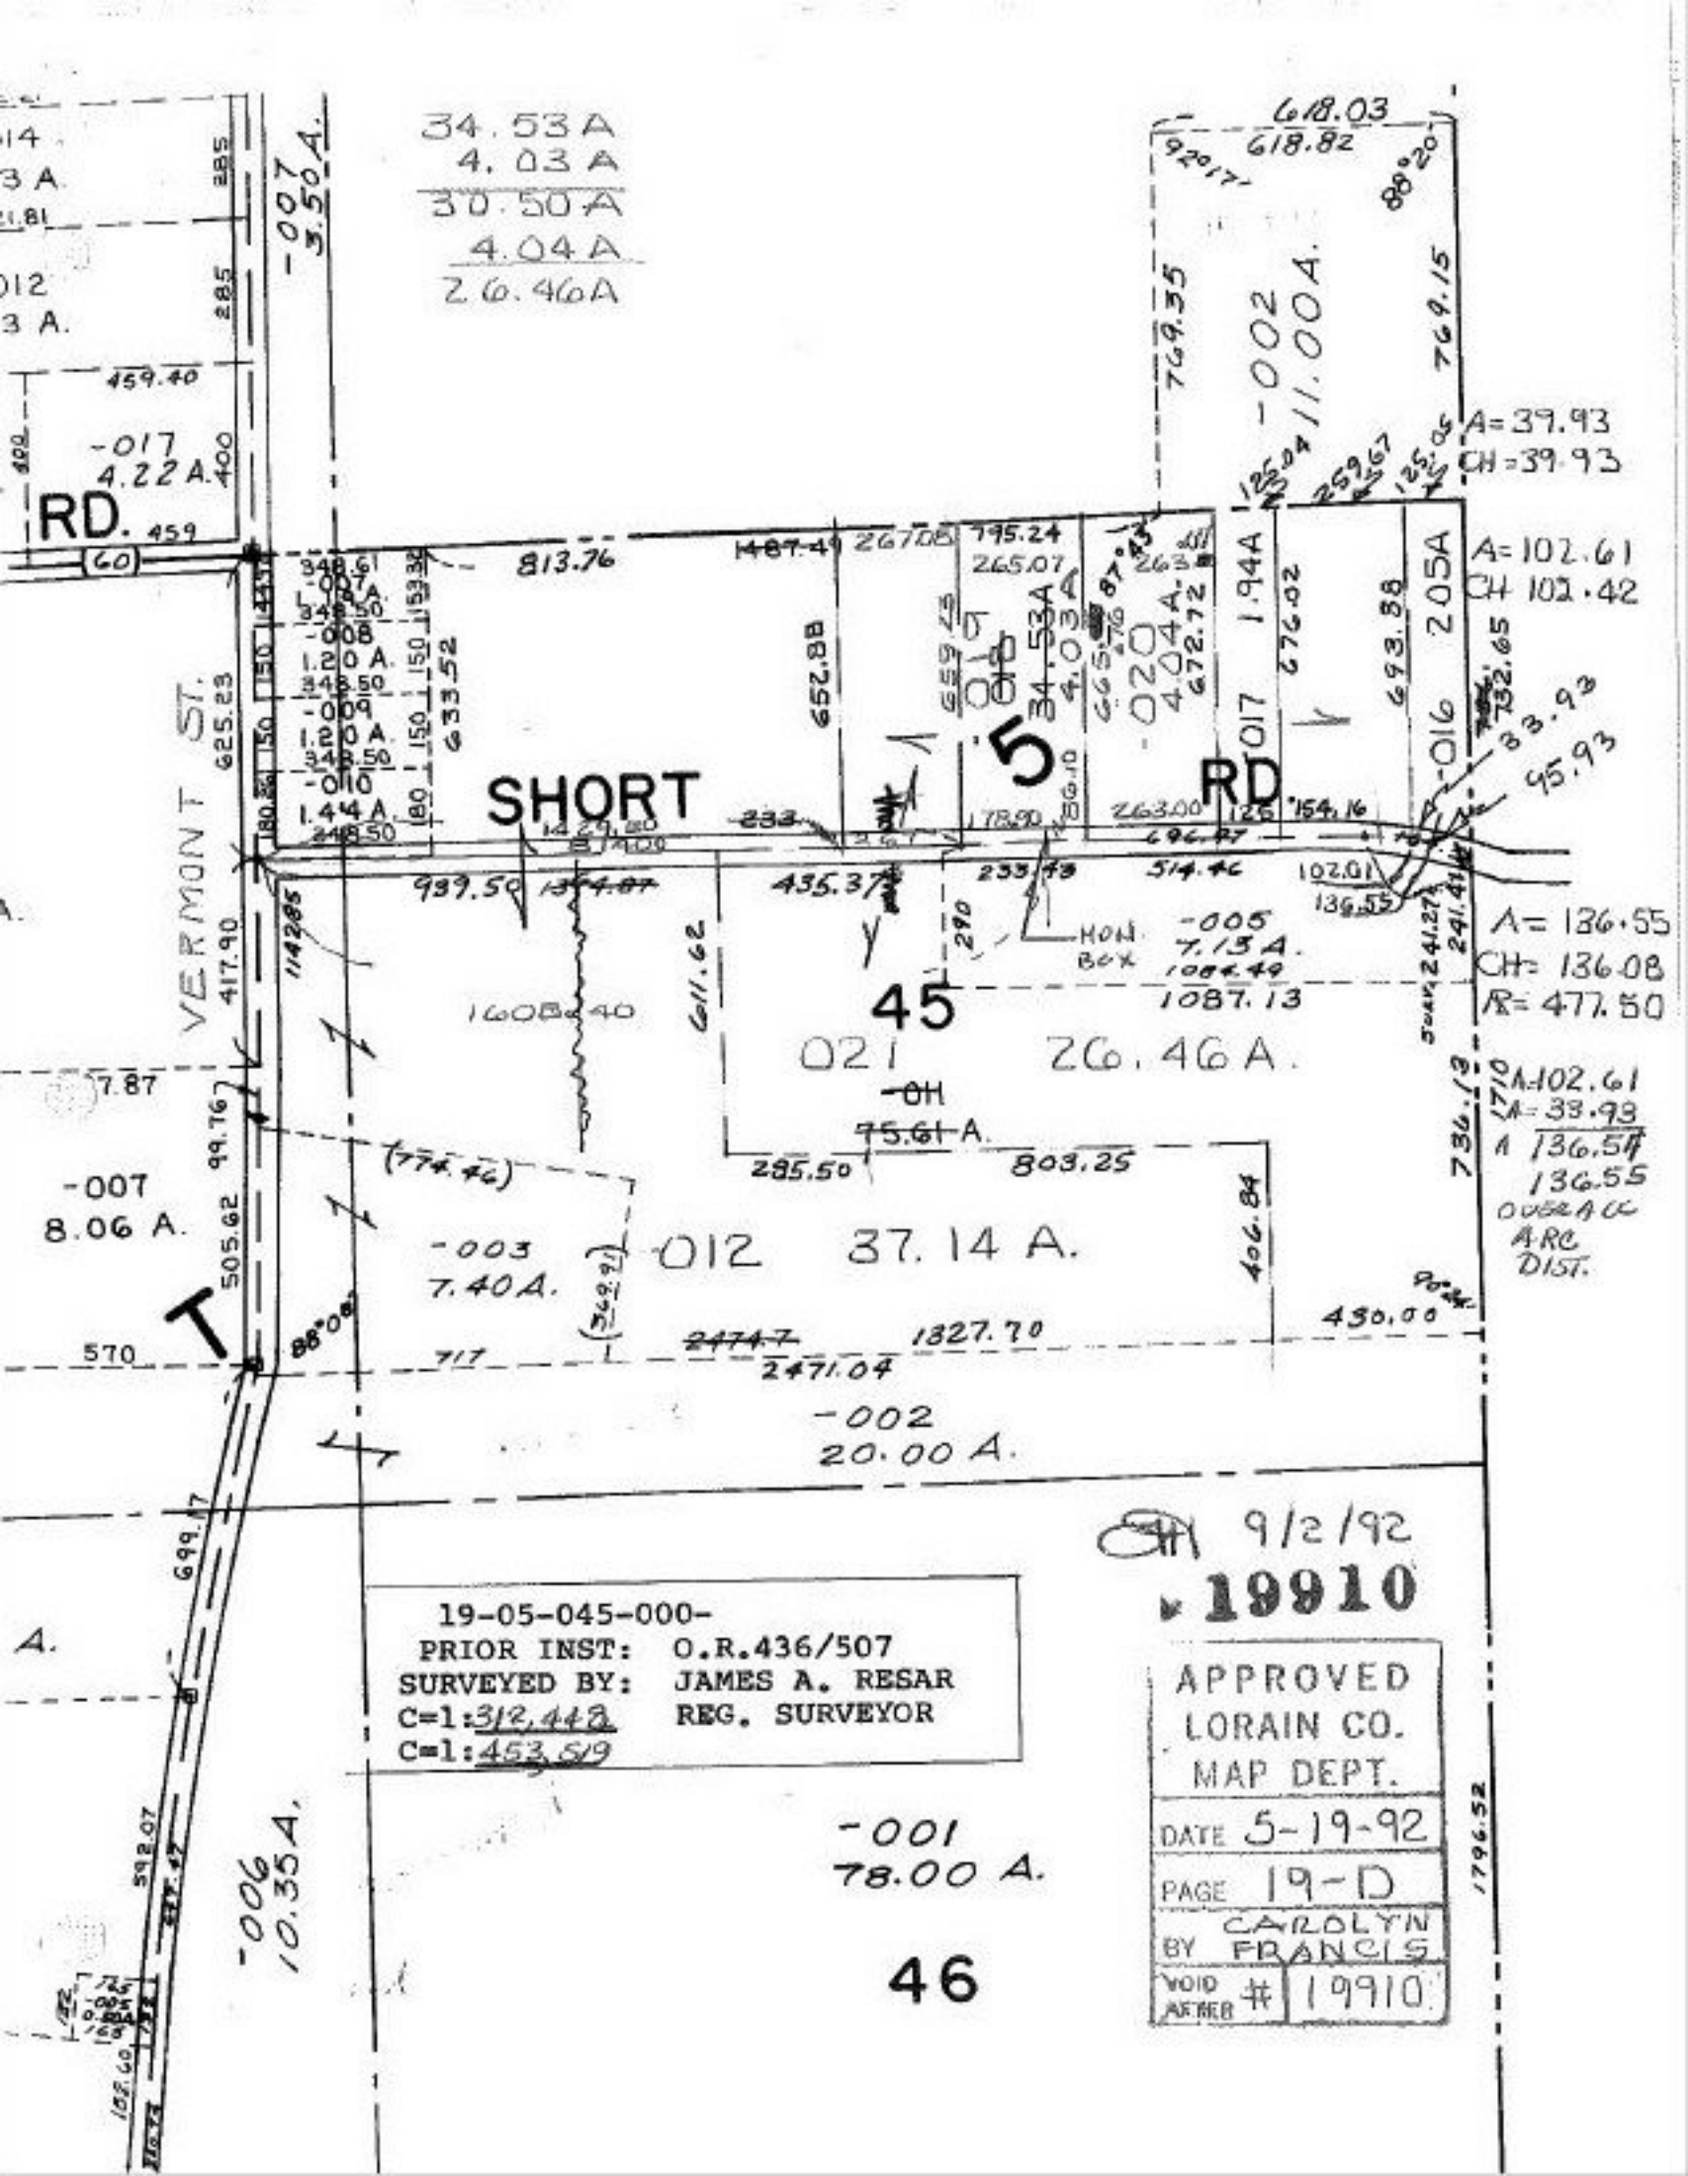

19-05-045-000-
PRIOR INST: O.R.436/507
SURVEYED BY: JAMES A. RESAR
C=1:312.448 REG. SURVEYOR
C=1:453.59

9/2/92

19910

APPROVED
LORAIN CO.
MAP DEPT.
DATE 5-19-92
PAGE 19-D
BY CAROLYN FRANCIS
VOID AFTER # 19910