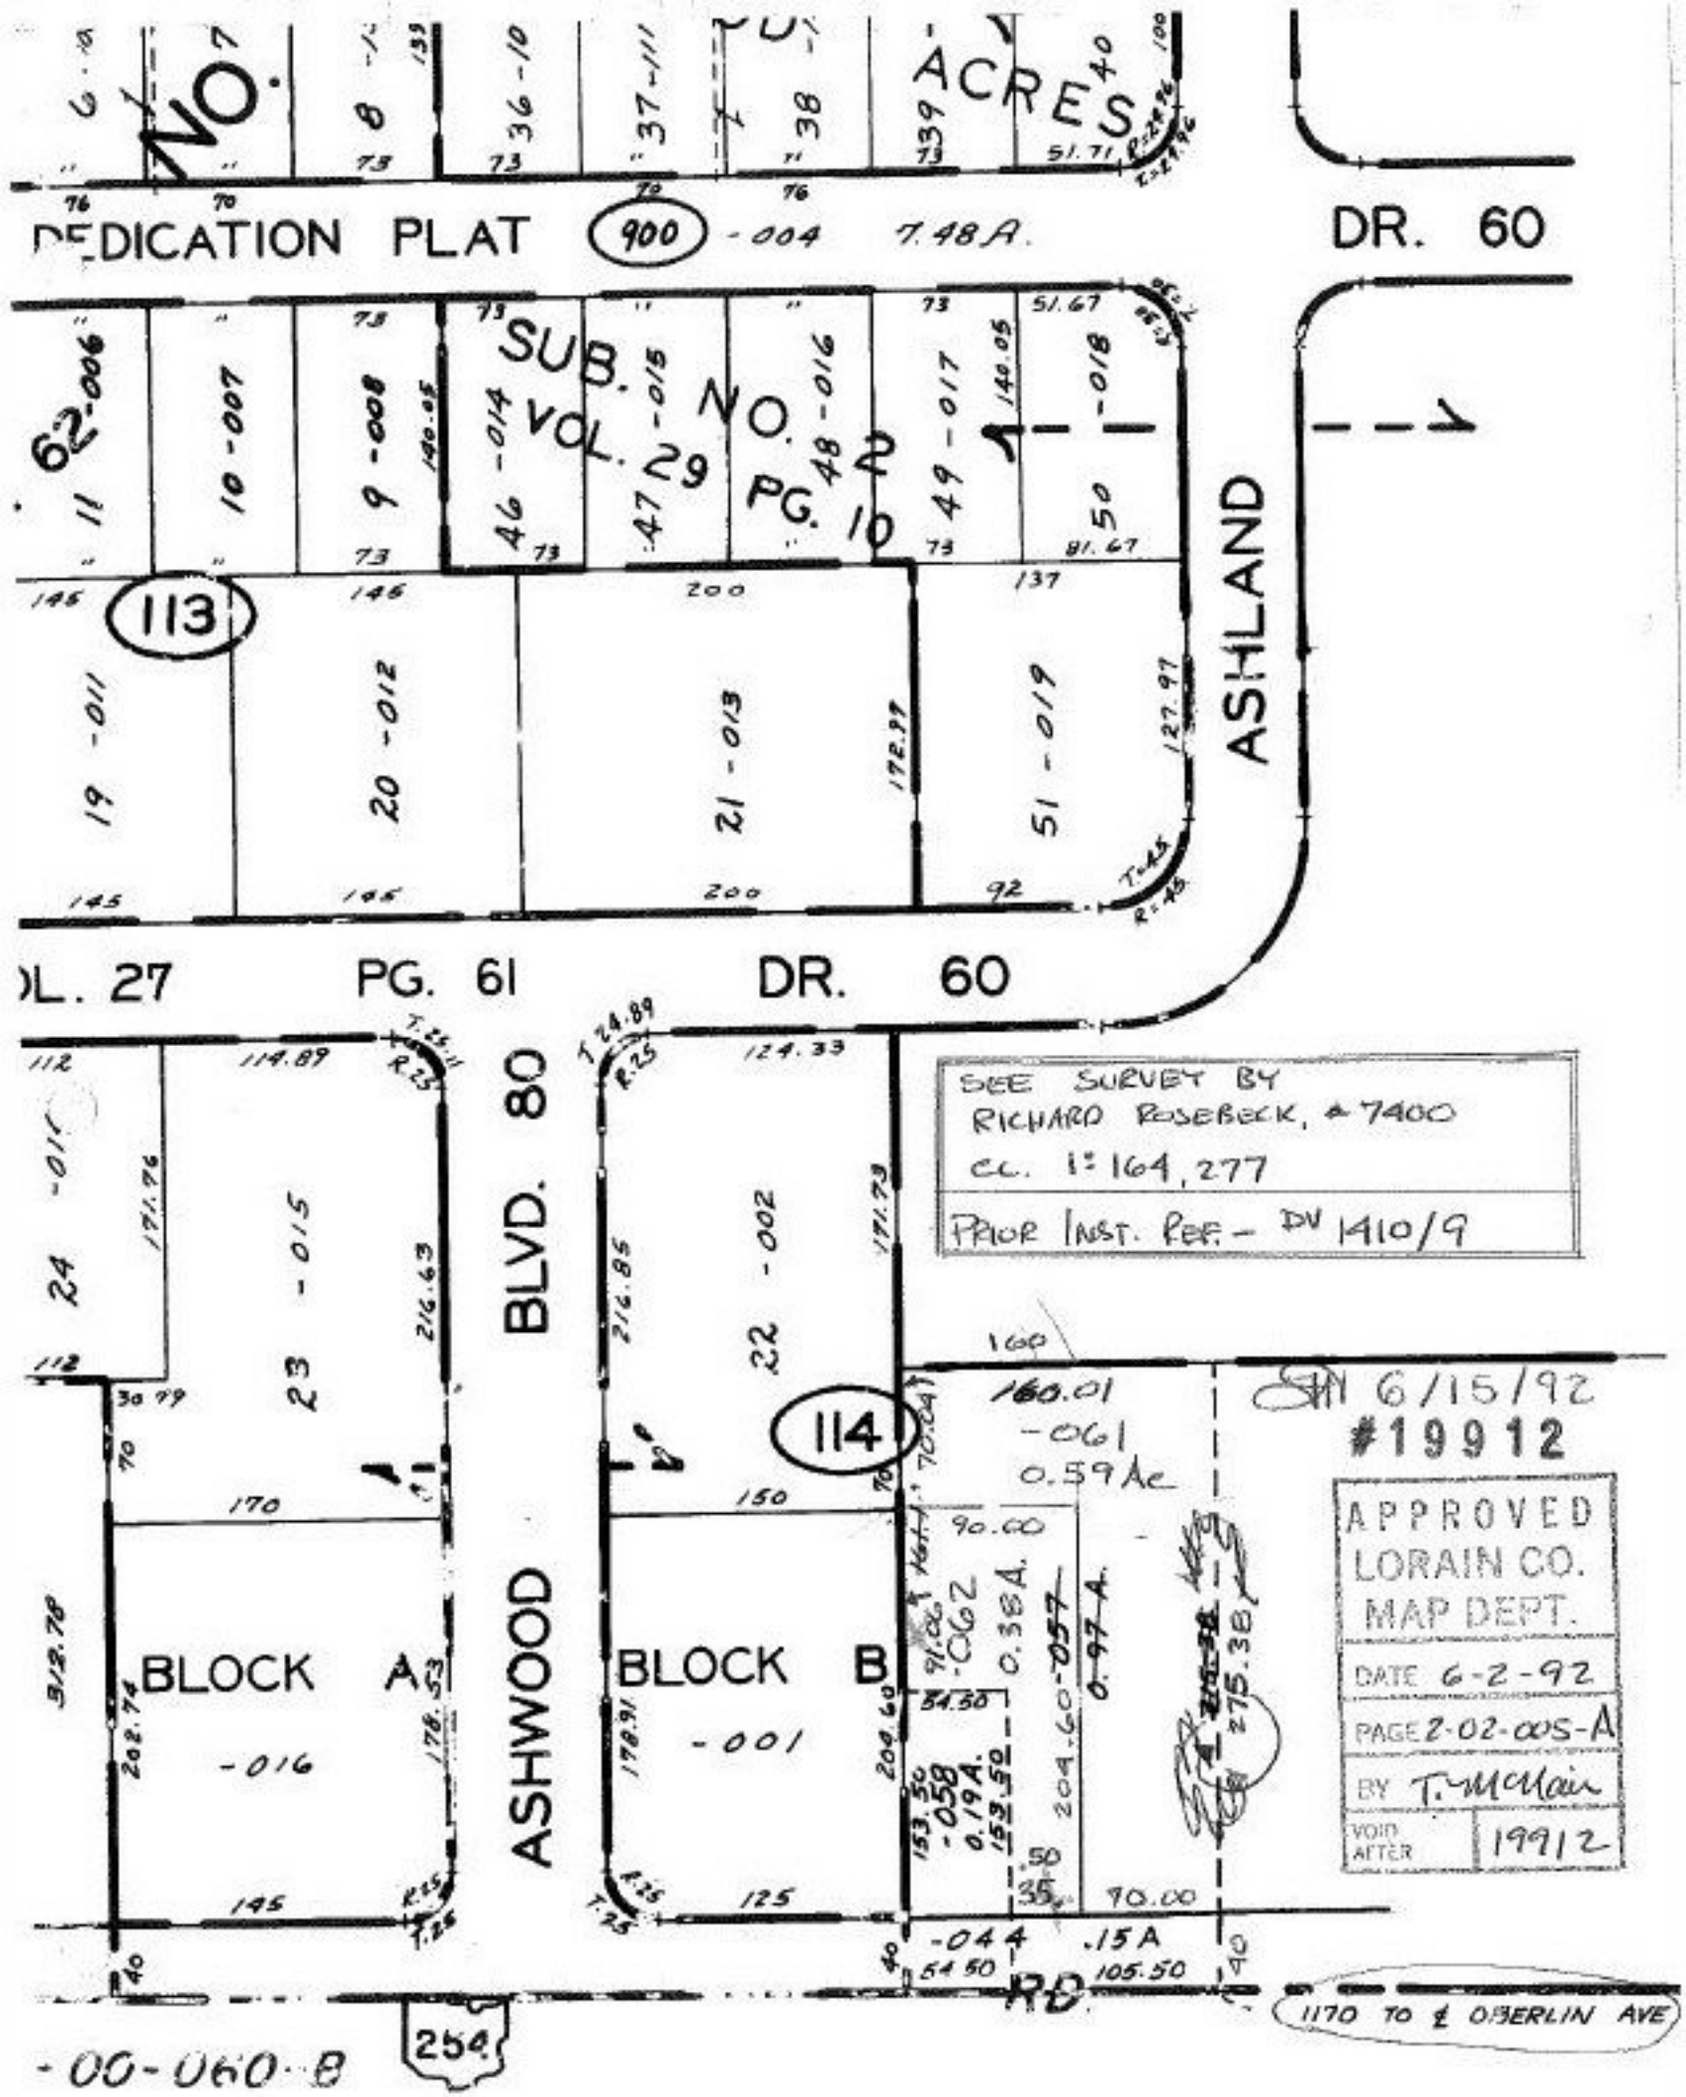
DEDICATION PLAT
900
-004
7.48A.
DR. 60
SUB. VOL. 29 PG. 10
ASHLAND
113
114
VOL. 27
PG. 61
DR. 60
BLVD. 80
ASHWOOD
BLOCK A
-016
BLOCK B
-001
-062
0.38A.
-057
0.97A.
-058
0.19A.
-044
.15A
160.01
-061
0.59Ac
SEE SURVEY BY
RICHARD ROSEBECK, # 7400
cc. 1: 164,277
PRIOR INST. REF. - DV 1410/9
SM 6/15/92
#19912
APPROVED
LORAIN CO.
MAP DEPT.
DATE 6-2-92
PAGE 2-02-005-A
BY T. McClain
VOID AFTER 19912
1170 TO ℄ OBERLIN AVE
254
-00-060-B