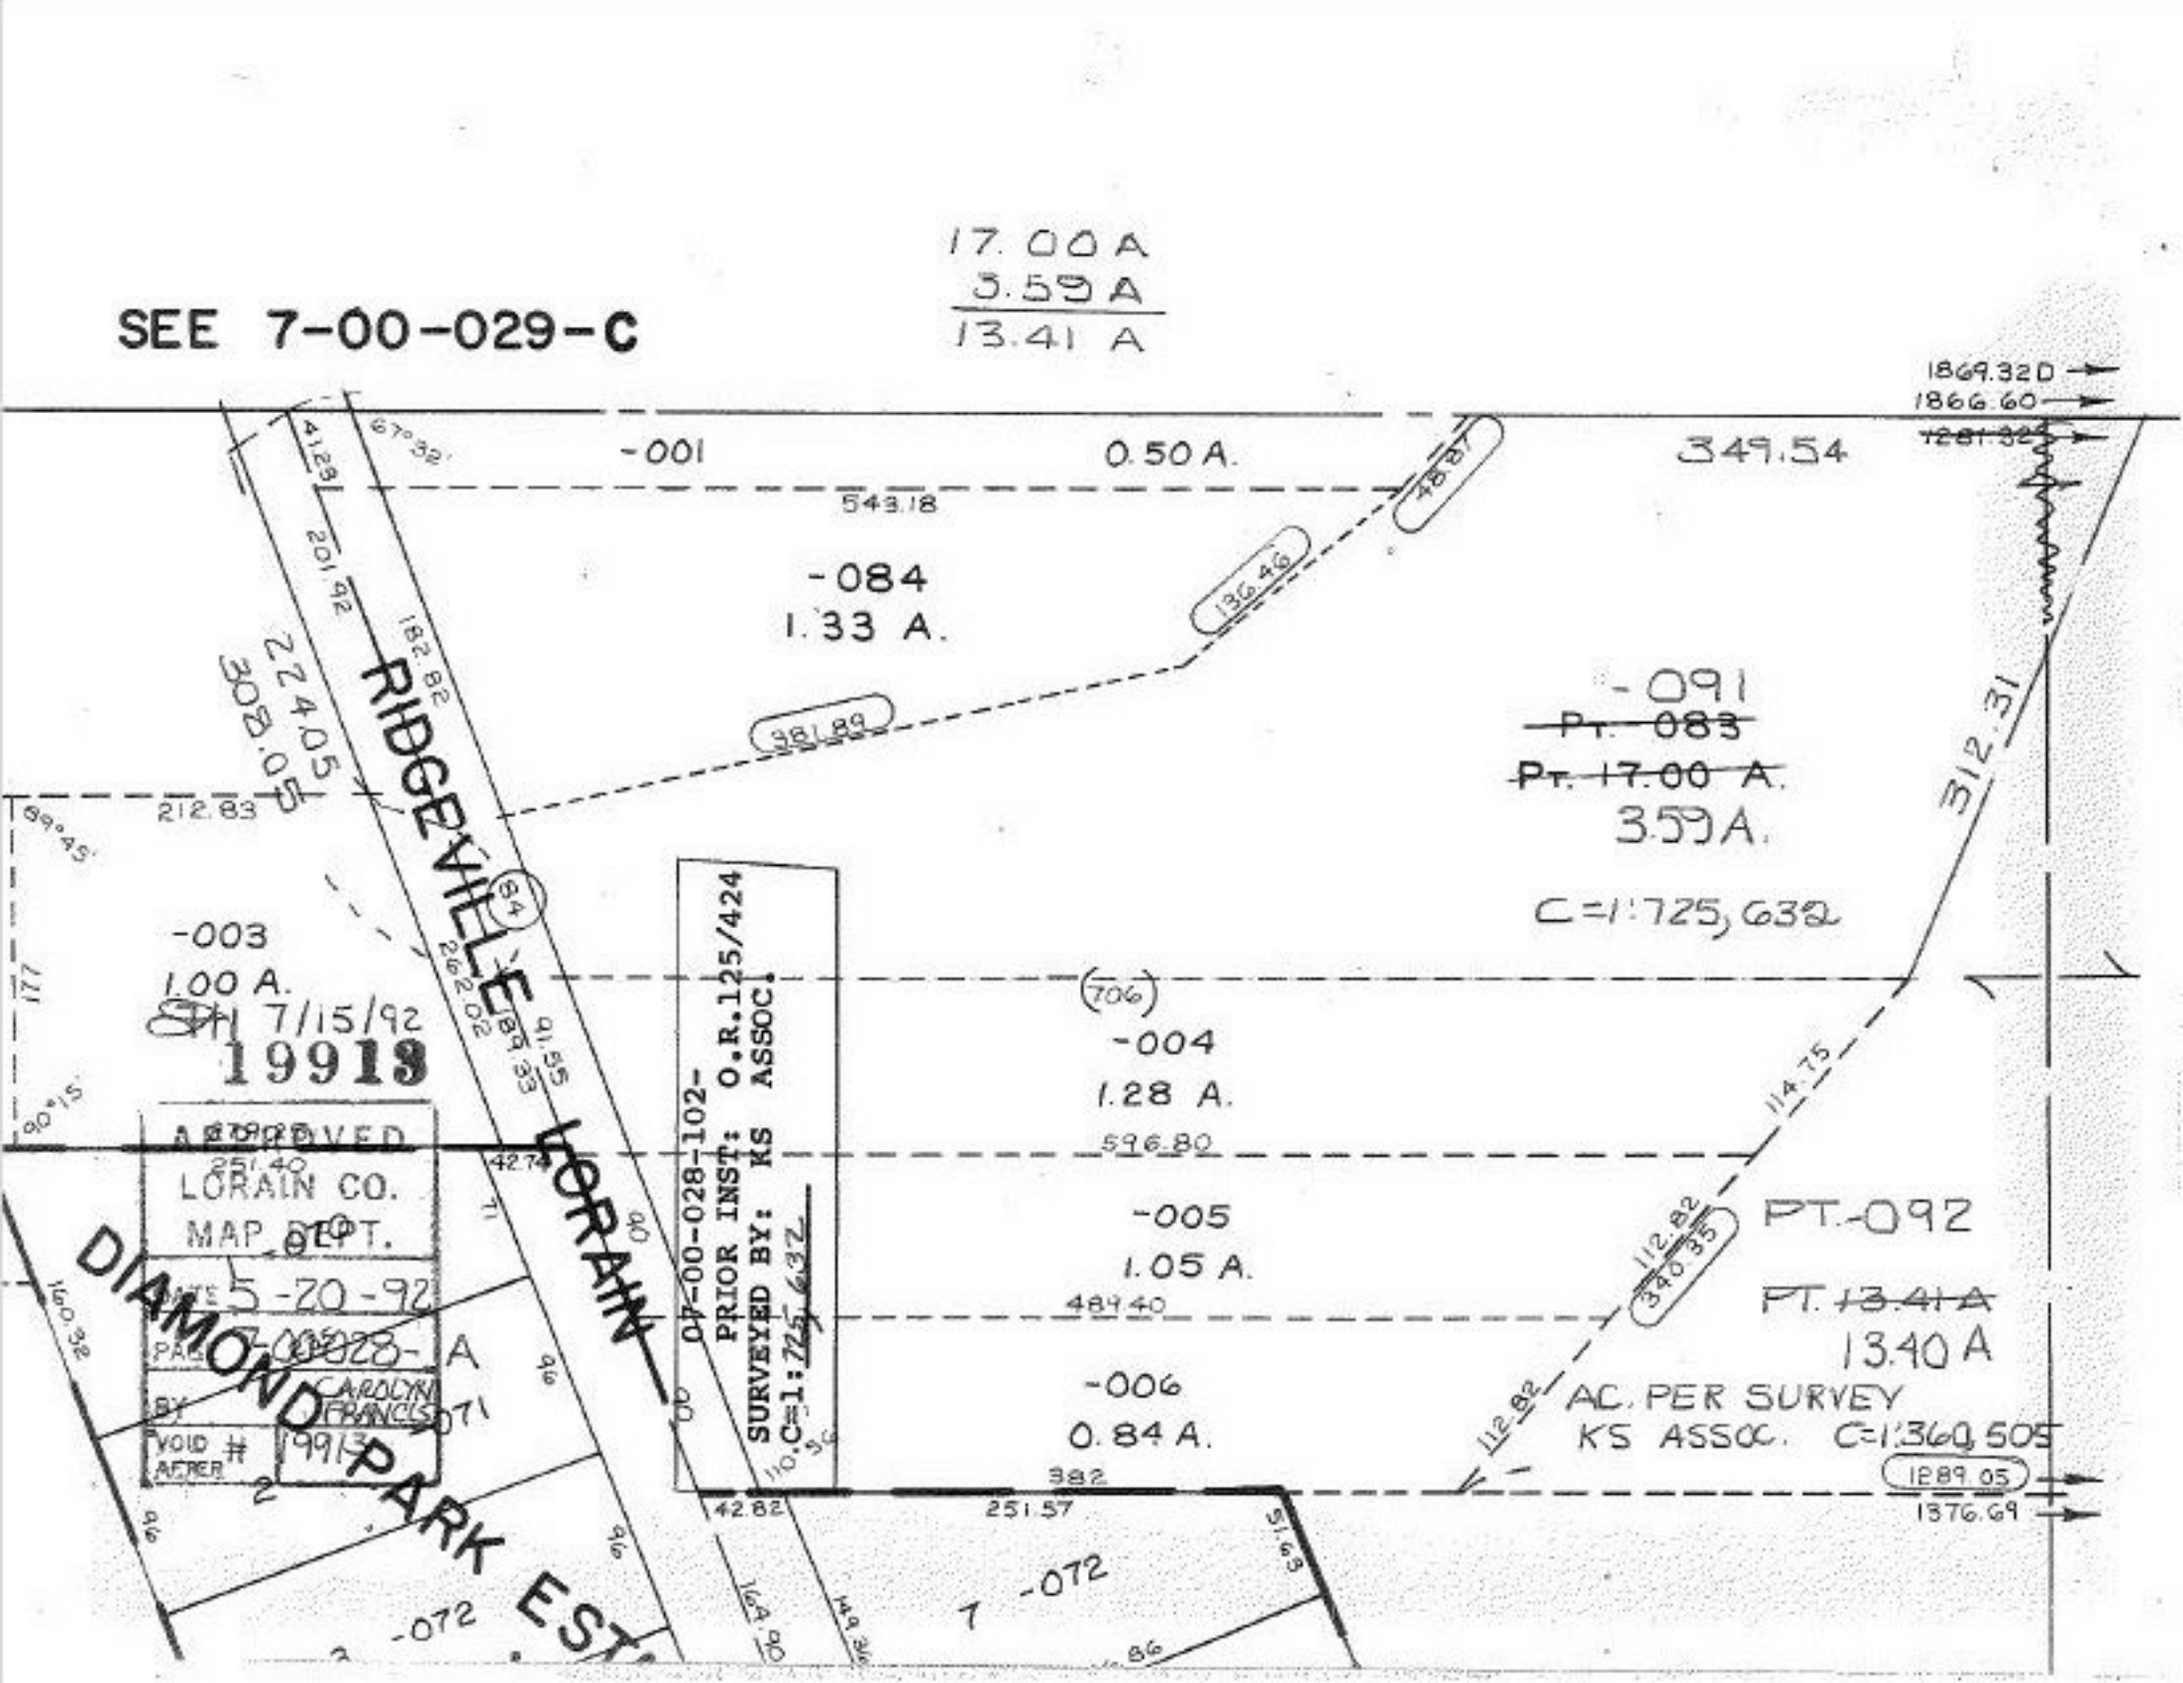
SEE 7-00-029-C
17.00 A
3.59 A
13.41 A
-001
0.50 A.
543.18
349.54
-084
1.33 A.
-091
Pt. 083
Pt. 17.00 A.
3.59 A.
C=1:725,632
-003
1.00 A.
7/15/92
19913
-004
1.28 A.
596.80
-005
1.05 A.
489.40
-006
0.84 A.
PT.-092
Pt. 13.41 A
13.40 A
AC. PER SURVEY
KS ASSOC. C=1:360,505
RIDGEVILLE
LORAIN
DIAMOND PARK EST
07-00-028-102-
PRIOR INST: O.R.125/424
SURVEYED BY: KS ASSOC.
APPROVED
LORAIN CO.
MAP DEPT.
DATE 5-20-92
PARCEL 7-00028-
BY CAROLYN FRANCIS
VOID # 19913
ALTER
-072
1869.32
1866.60
1281.32
1289.05
1376.69