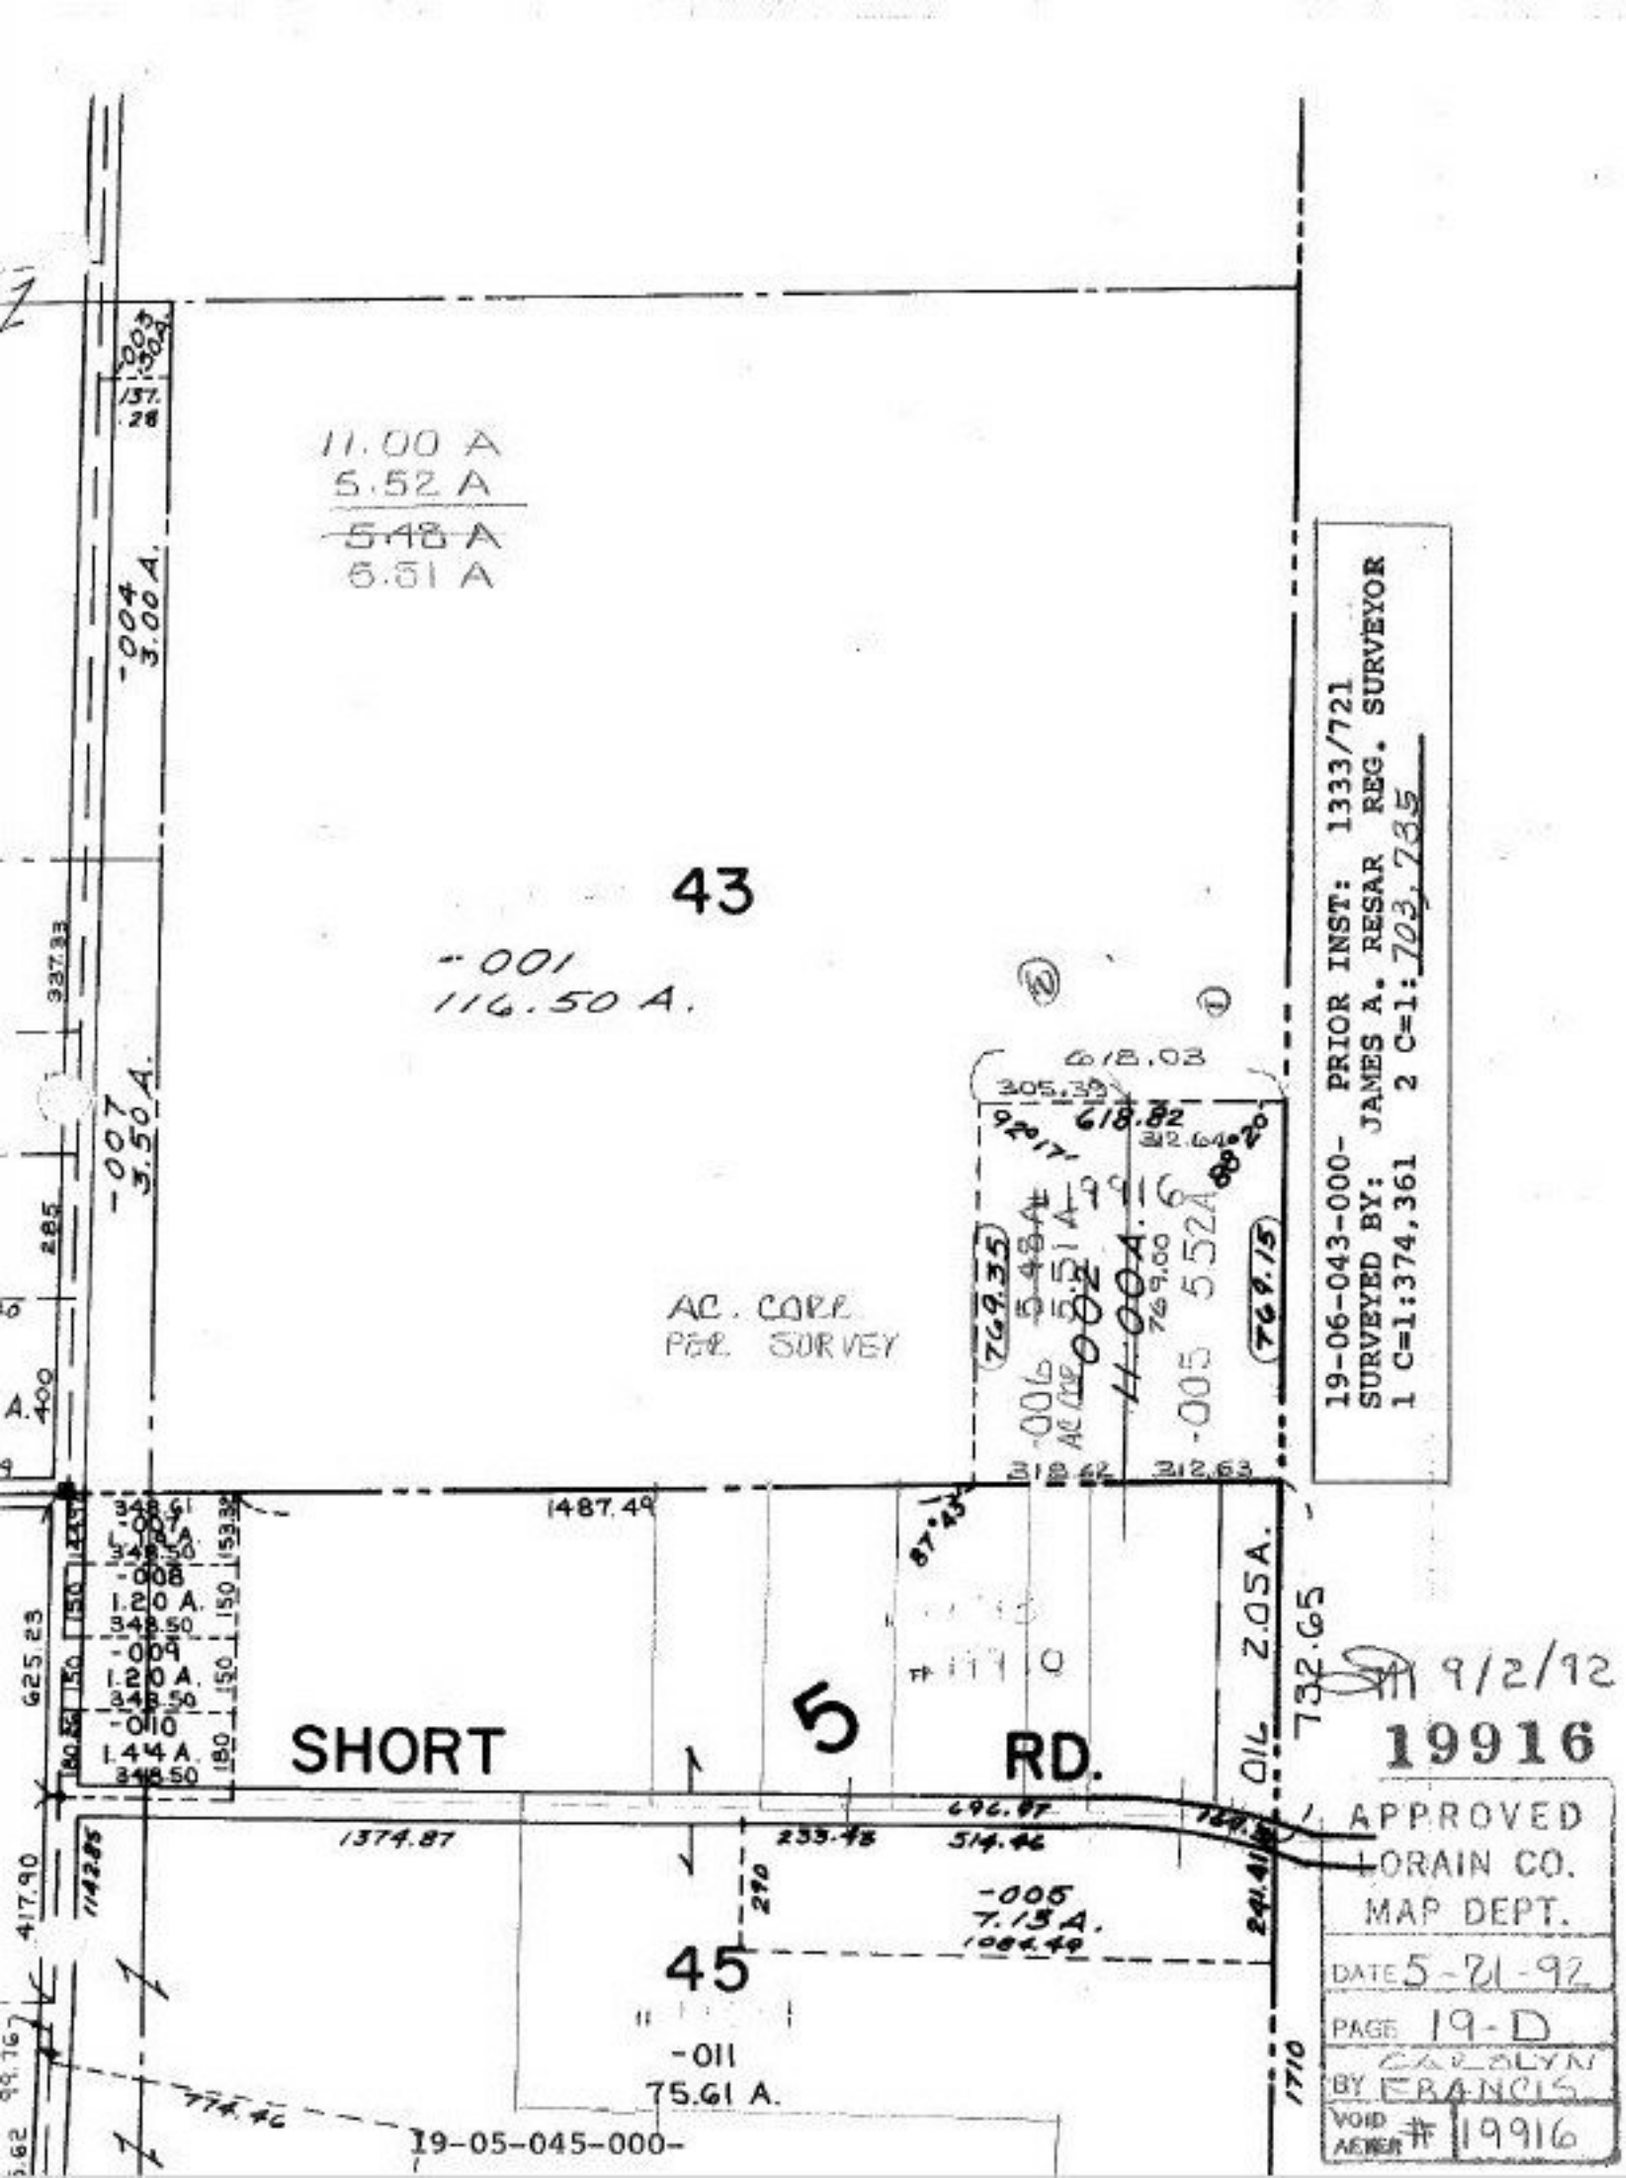
11.00 A
5.52 A
5.48 A
5.51 A
-004
3.00 A.
-007
3.50 A.
43
-001
116.50 A.
AC. CORR.
P&R. SURVEY
-006
AC. CORR.
-004
11.00 A.
-005
5.52 A.
769.00
769.35
768.15
618.82
618.03
305.39
212.63
212.64
80.20
92.17
1487.49
87.43
-008
1.20 A.
348.50
-009
1.20 A.
348.50
-010
1.44 A.
348.50
625.23
417.90
SHORT
5
RD.
732.65
2.05 A.
1374.87
233.48
514.46
696.87
-005
7.13 A.
108.49
45
-011
75.61 A.
774.46
19-05-045-000-
1710
19-06-043-000- PRIOR INST: 1333/721
SURVEYED BY: JAMES A. RESAR REG. SURVEYOR
1 C=1:374,361 2 C=1: 703, 735
9/2/92
19916
APPROVED
ORAIN CO.
MAP DEPT.
DATE 5-21-92
PAGE 19-D
BY CAROLYN FRANCIS
VOID AENER # 19916