


RD. 12-1-87

ANDERSON

(60)

(60)

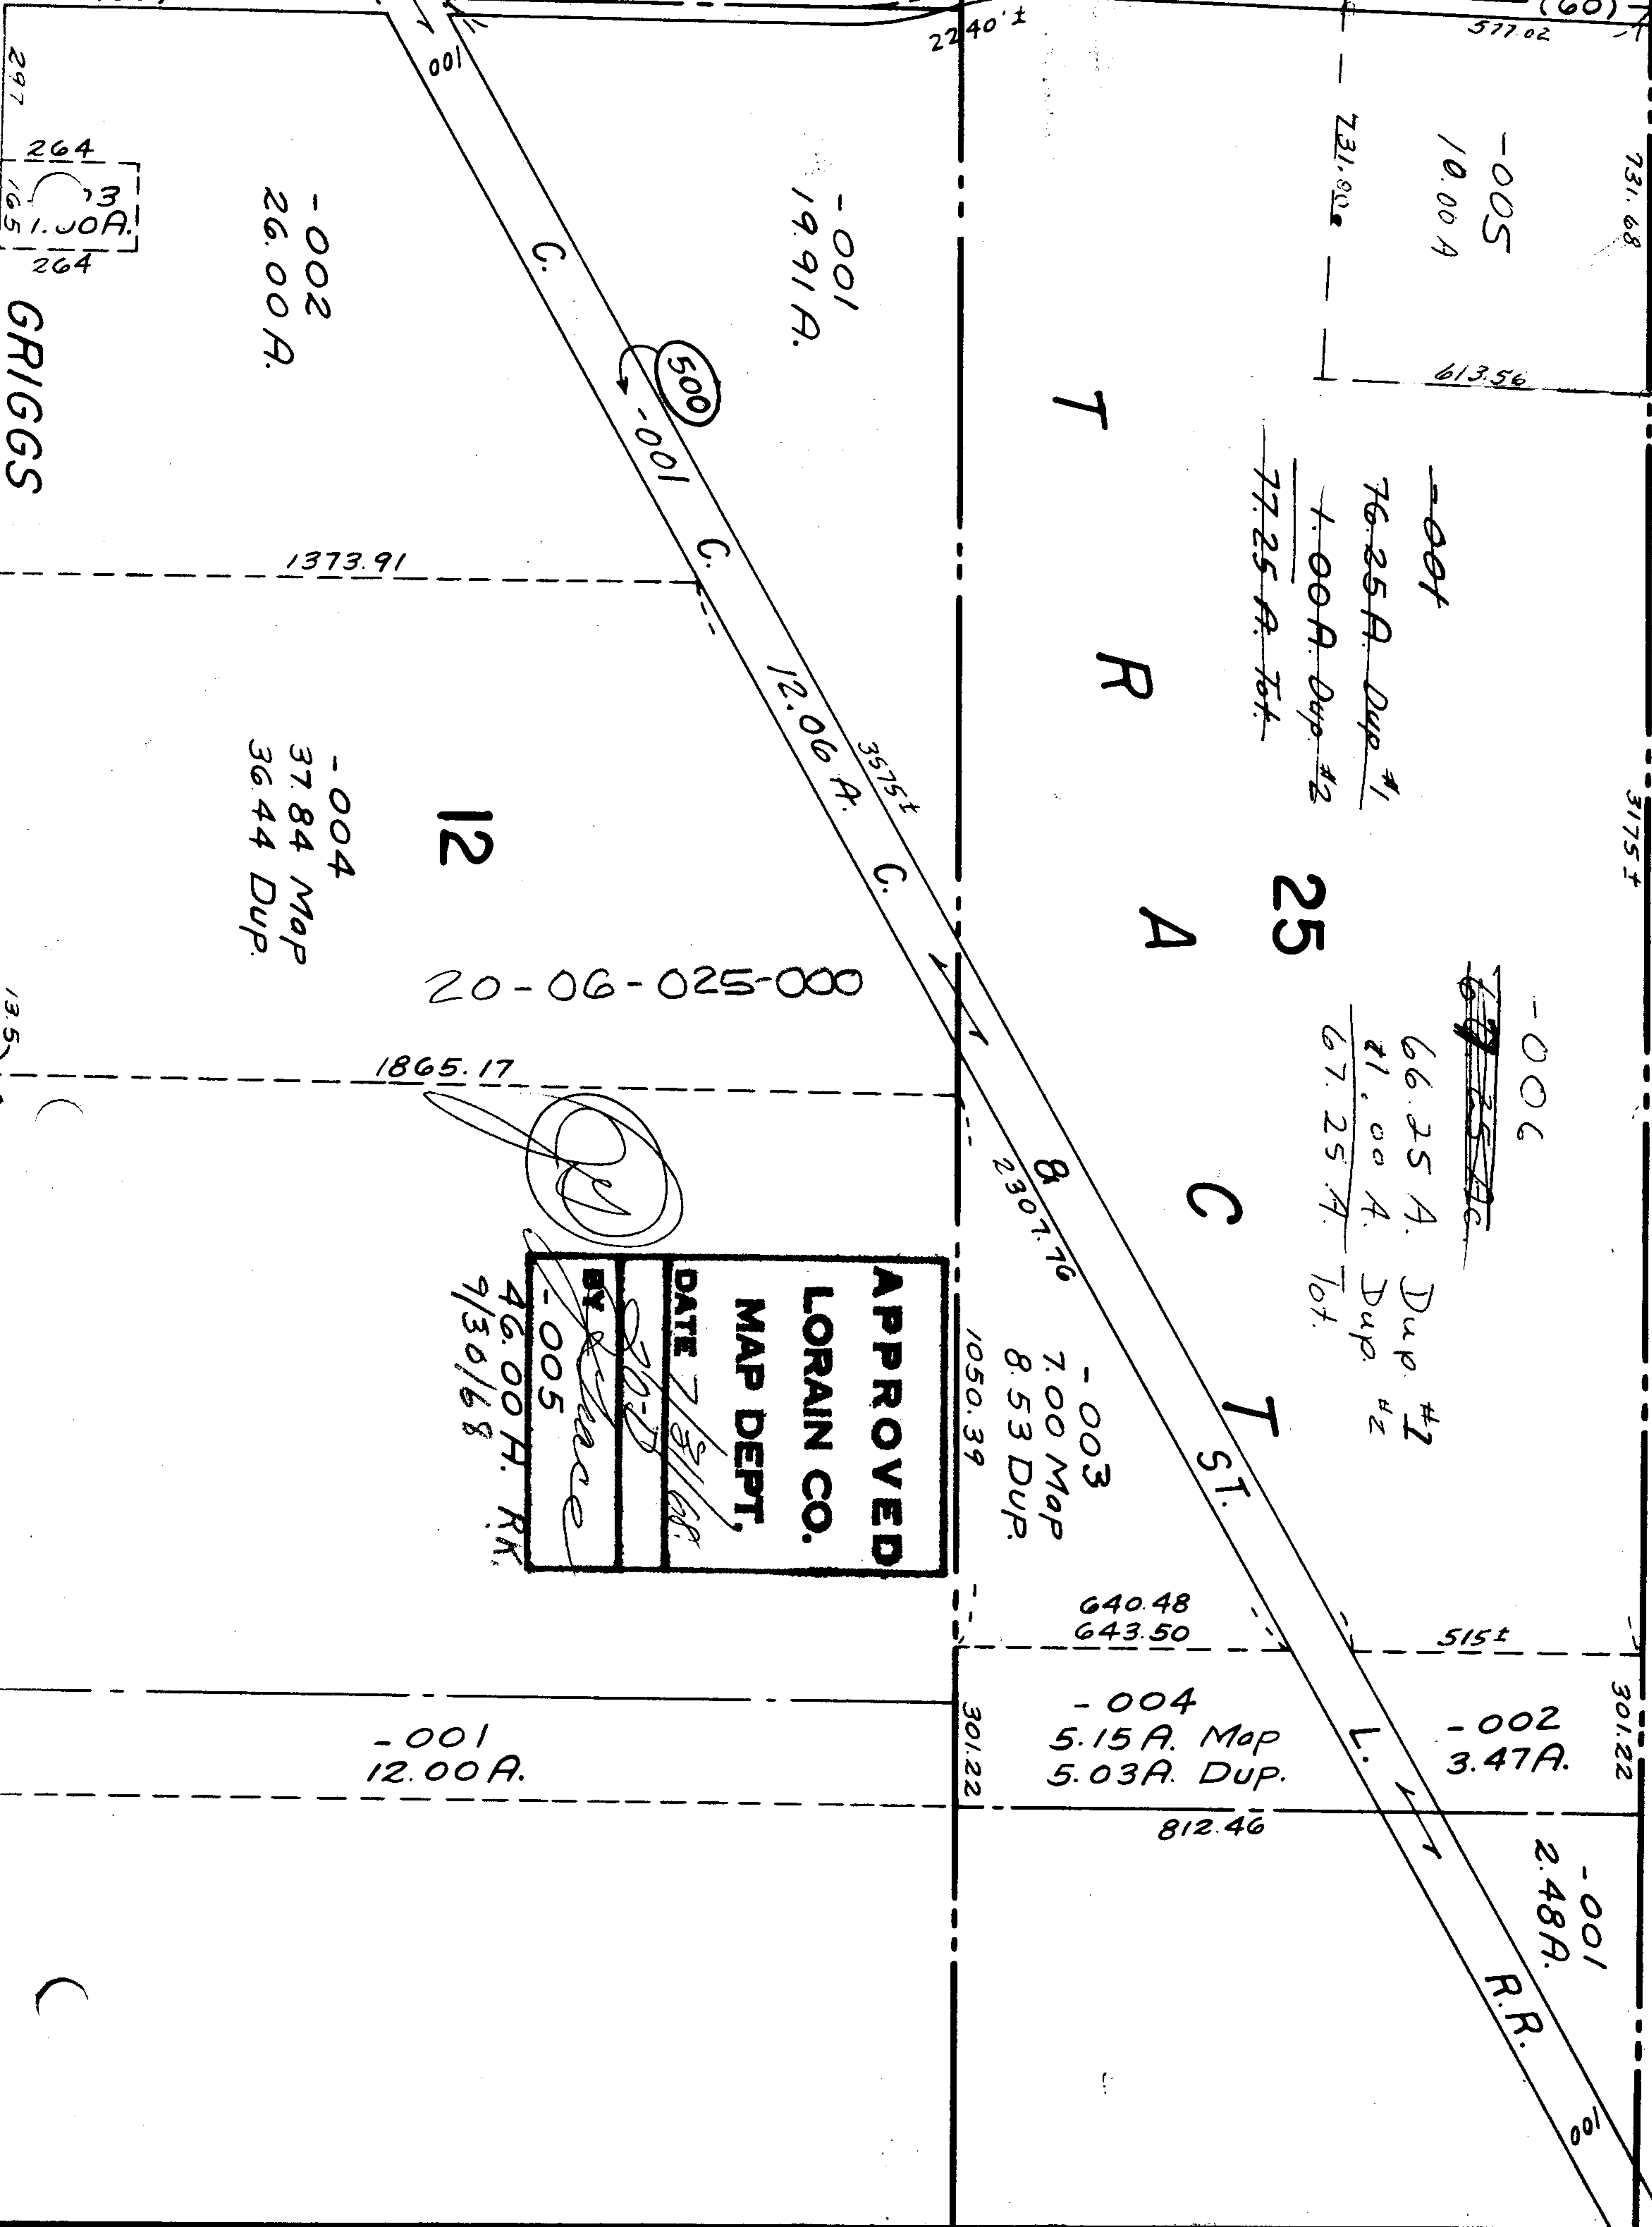

297
264
165
1.00 A.
264

GRIGGS

-002
26.00 A.

-001
19.91 A.

-005
10.00 A

231.00

613.56

1373.91

-004
37.84 Map
36.44 Dup.

12

20-06-025-000

1865.17

(Signature)

APPROVED
LORAIN CO.
MAP DEPT.
DATE 7/31/68
BY *(Signature)*
-005
46.00 H. R.K.
9/30/68

8
2301.76

-003
7.00 Map
8.53 Dup.

1050.39

640.48
643.50

-004
5.15 A. Map
5.03 A. Dup.

301.22

812.46

-001
12.00 A.

515

-002
3.47 A.

301.22

-001
2.48 A.

R.R.

100

1992