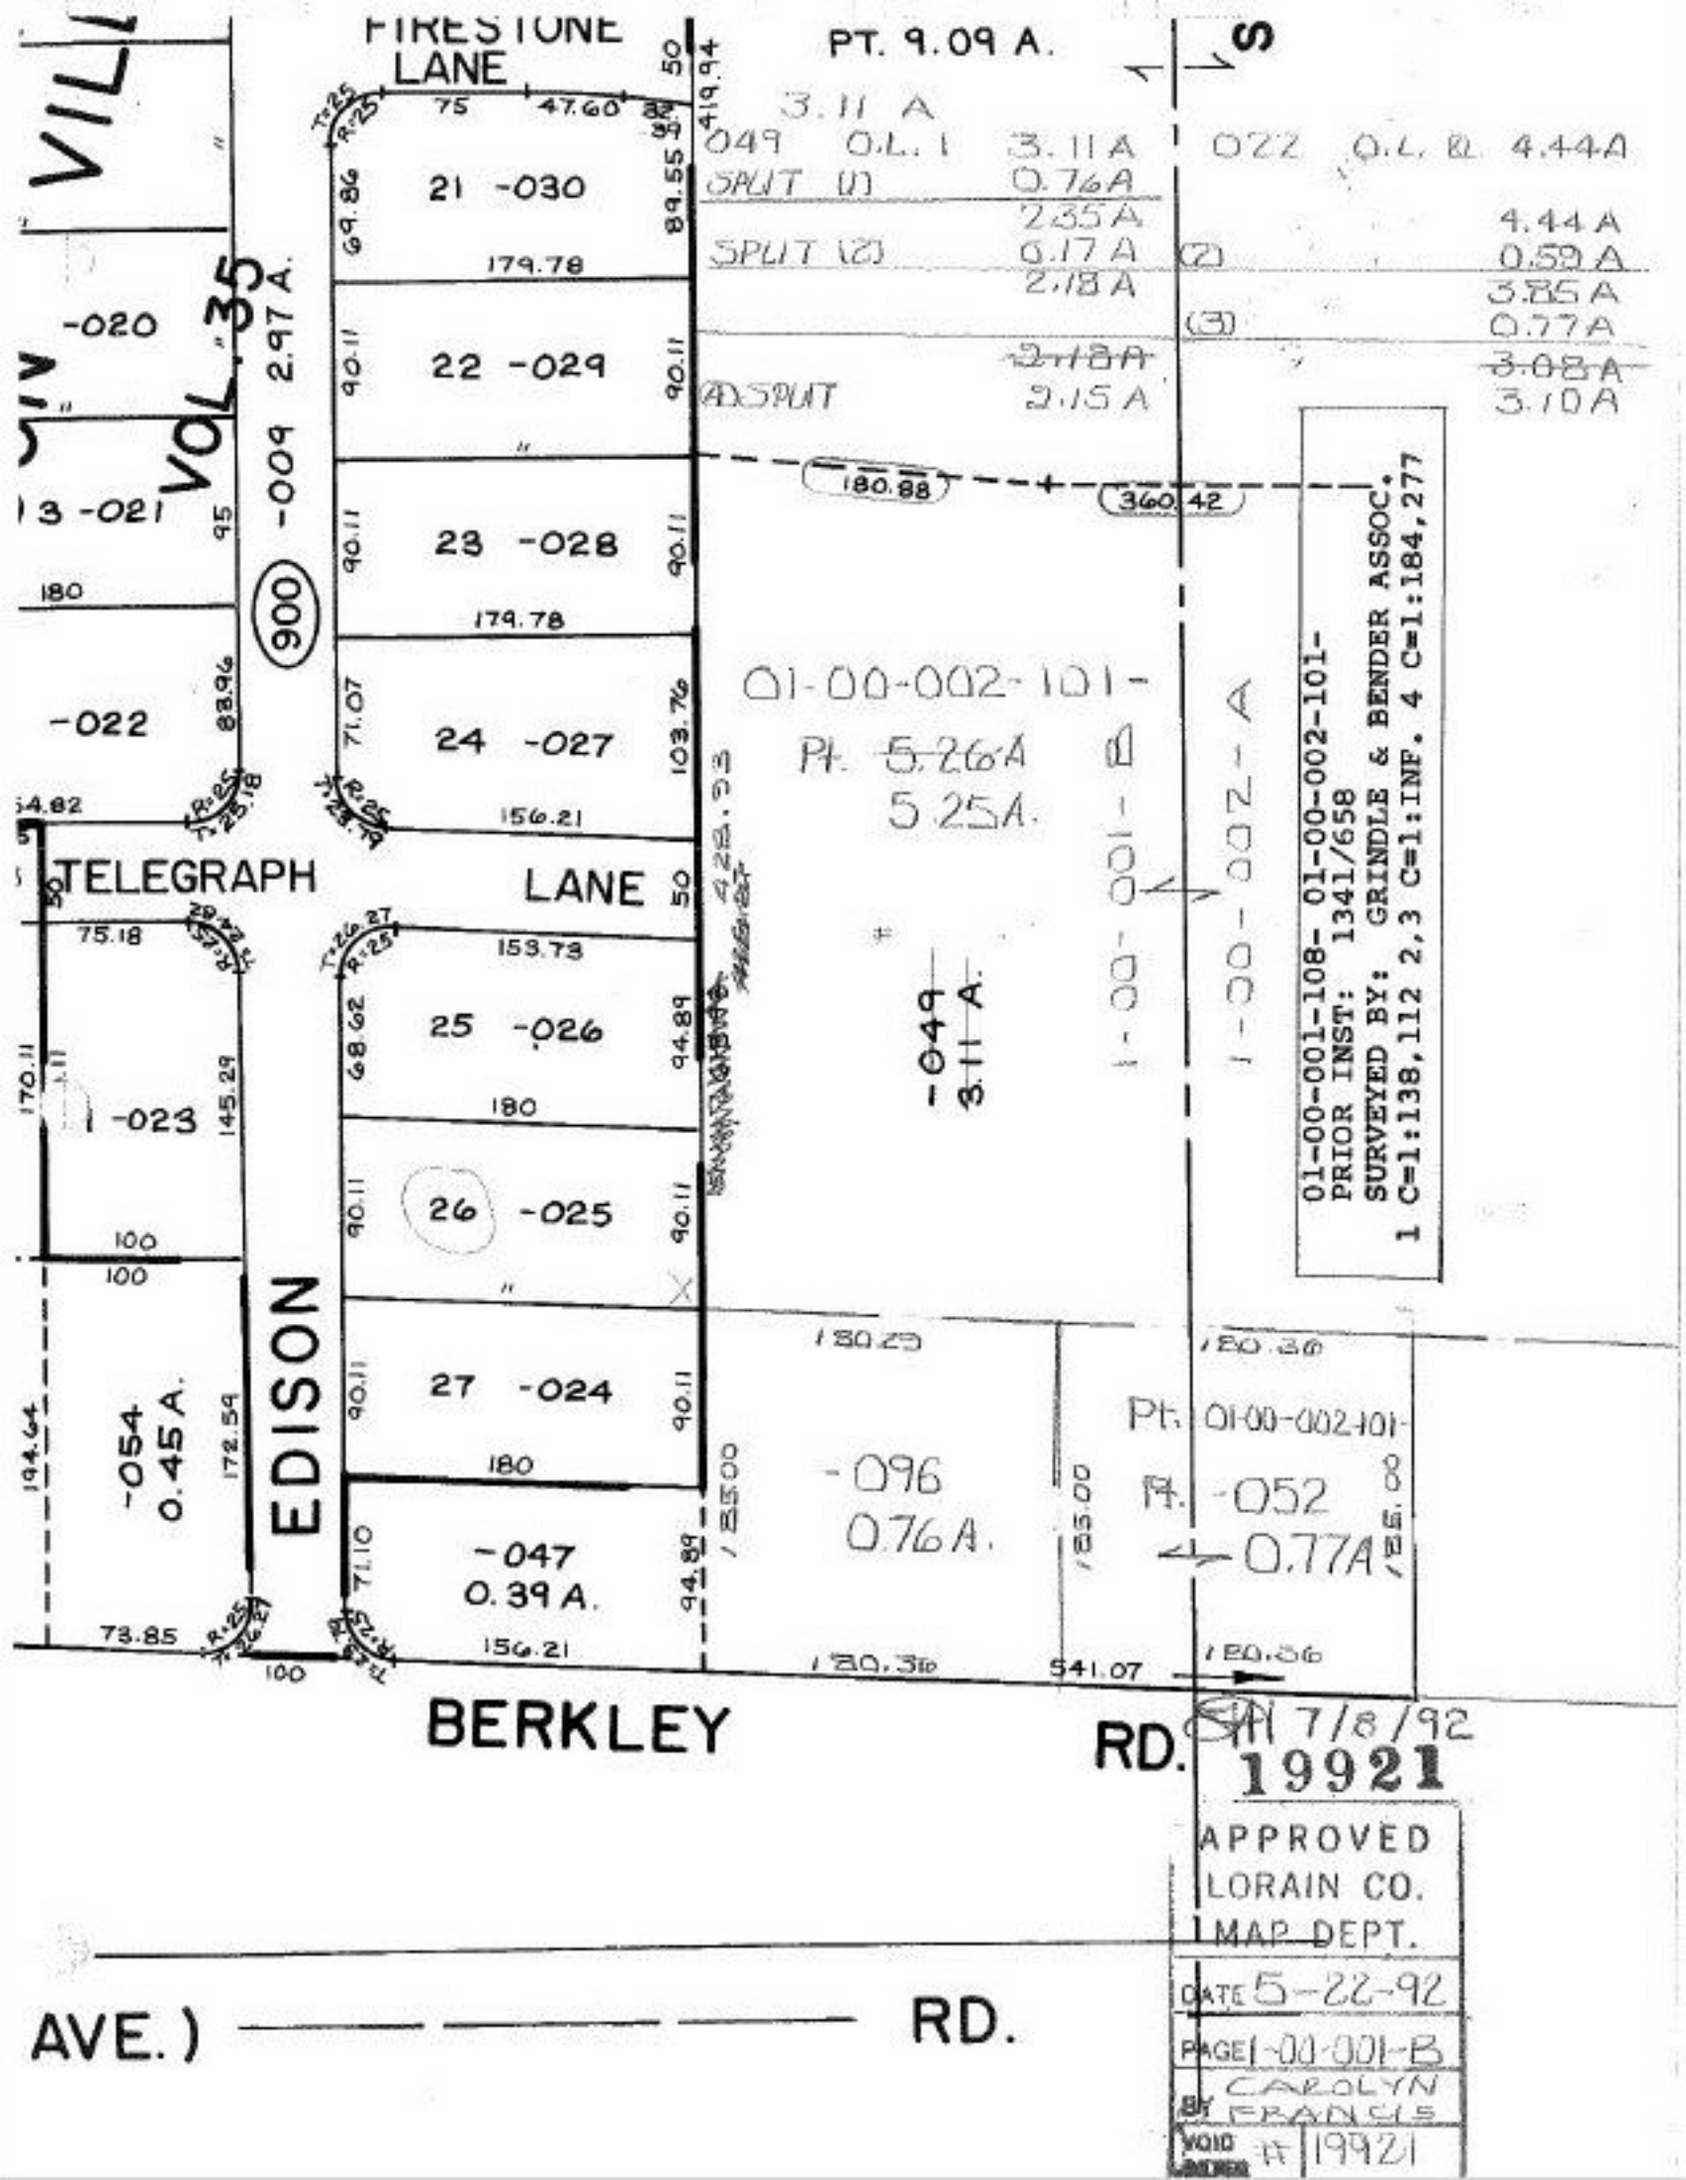
FIRESTONE LANE
PT. 9.09 A.
3.11 A
049 O.L. 1 3.11 A
SPLIT (1) 0.76A
2.35A
SPLIT (2) 0.17A
2.18A
ADSPLIT 2.15A
022 O.L. 2 4.44A
4.44A
(2) 0.59A
3.85A
(3) 0.77A
3.08A
3.10A
VOL. 35
2.97 A.
-020
-021
-022
-009
900
21 -030
22 -029
23 -028
24 -027
25 -026
26 -025
27 -024
-047
0.39 A.
-023
-054
0.45 A.
-049
3.11 A.
-096
0.76A.
01-00-002-101-
Pt. 5.26A
5.25A.
1-00-001-A
1-00-002-A
01-00-001-108- 01-00-002-101-
PRIOR INST: 1341/658
SURVEYED BY: GRINDLE & BENDER ASSOC.
1 C=1:138,112 2,3 C=1:INF. 4 C=1:184,277
Pt. 01-00-002-101-
Pt. -052
0.77A
TELEGRAPH LANE
EDISON
BERKLEY RD.
AVE.)
RD.
7/8/92
19921
APPROVED
LORAIN CO.
MAP DEPT.
DATE 5-22-92
PAGE 1-00-001-B
BY CAROLYN FRANCIS
VOID # 19921