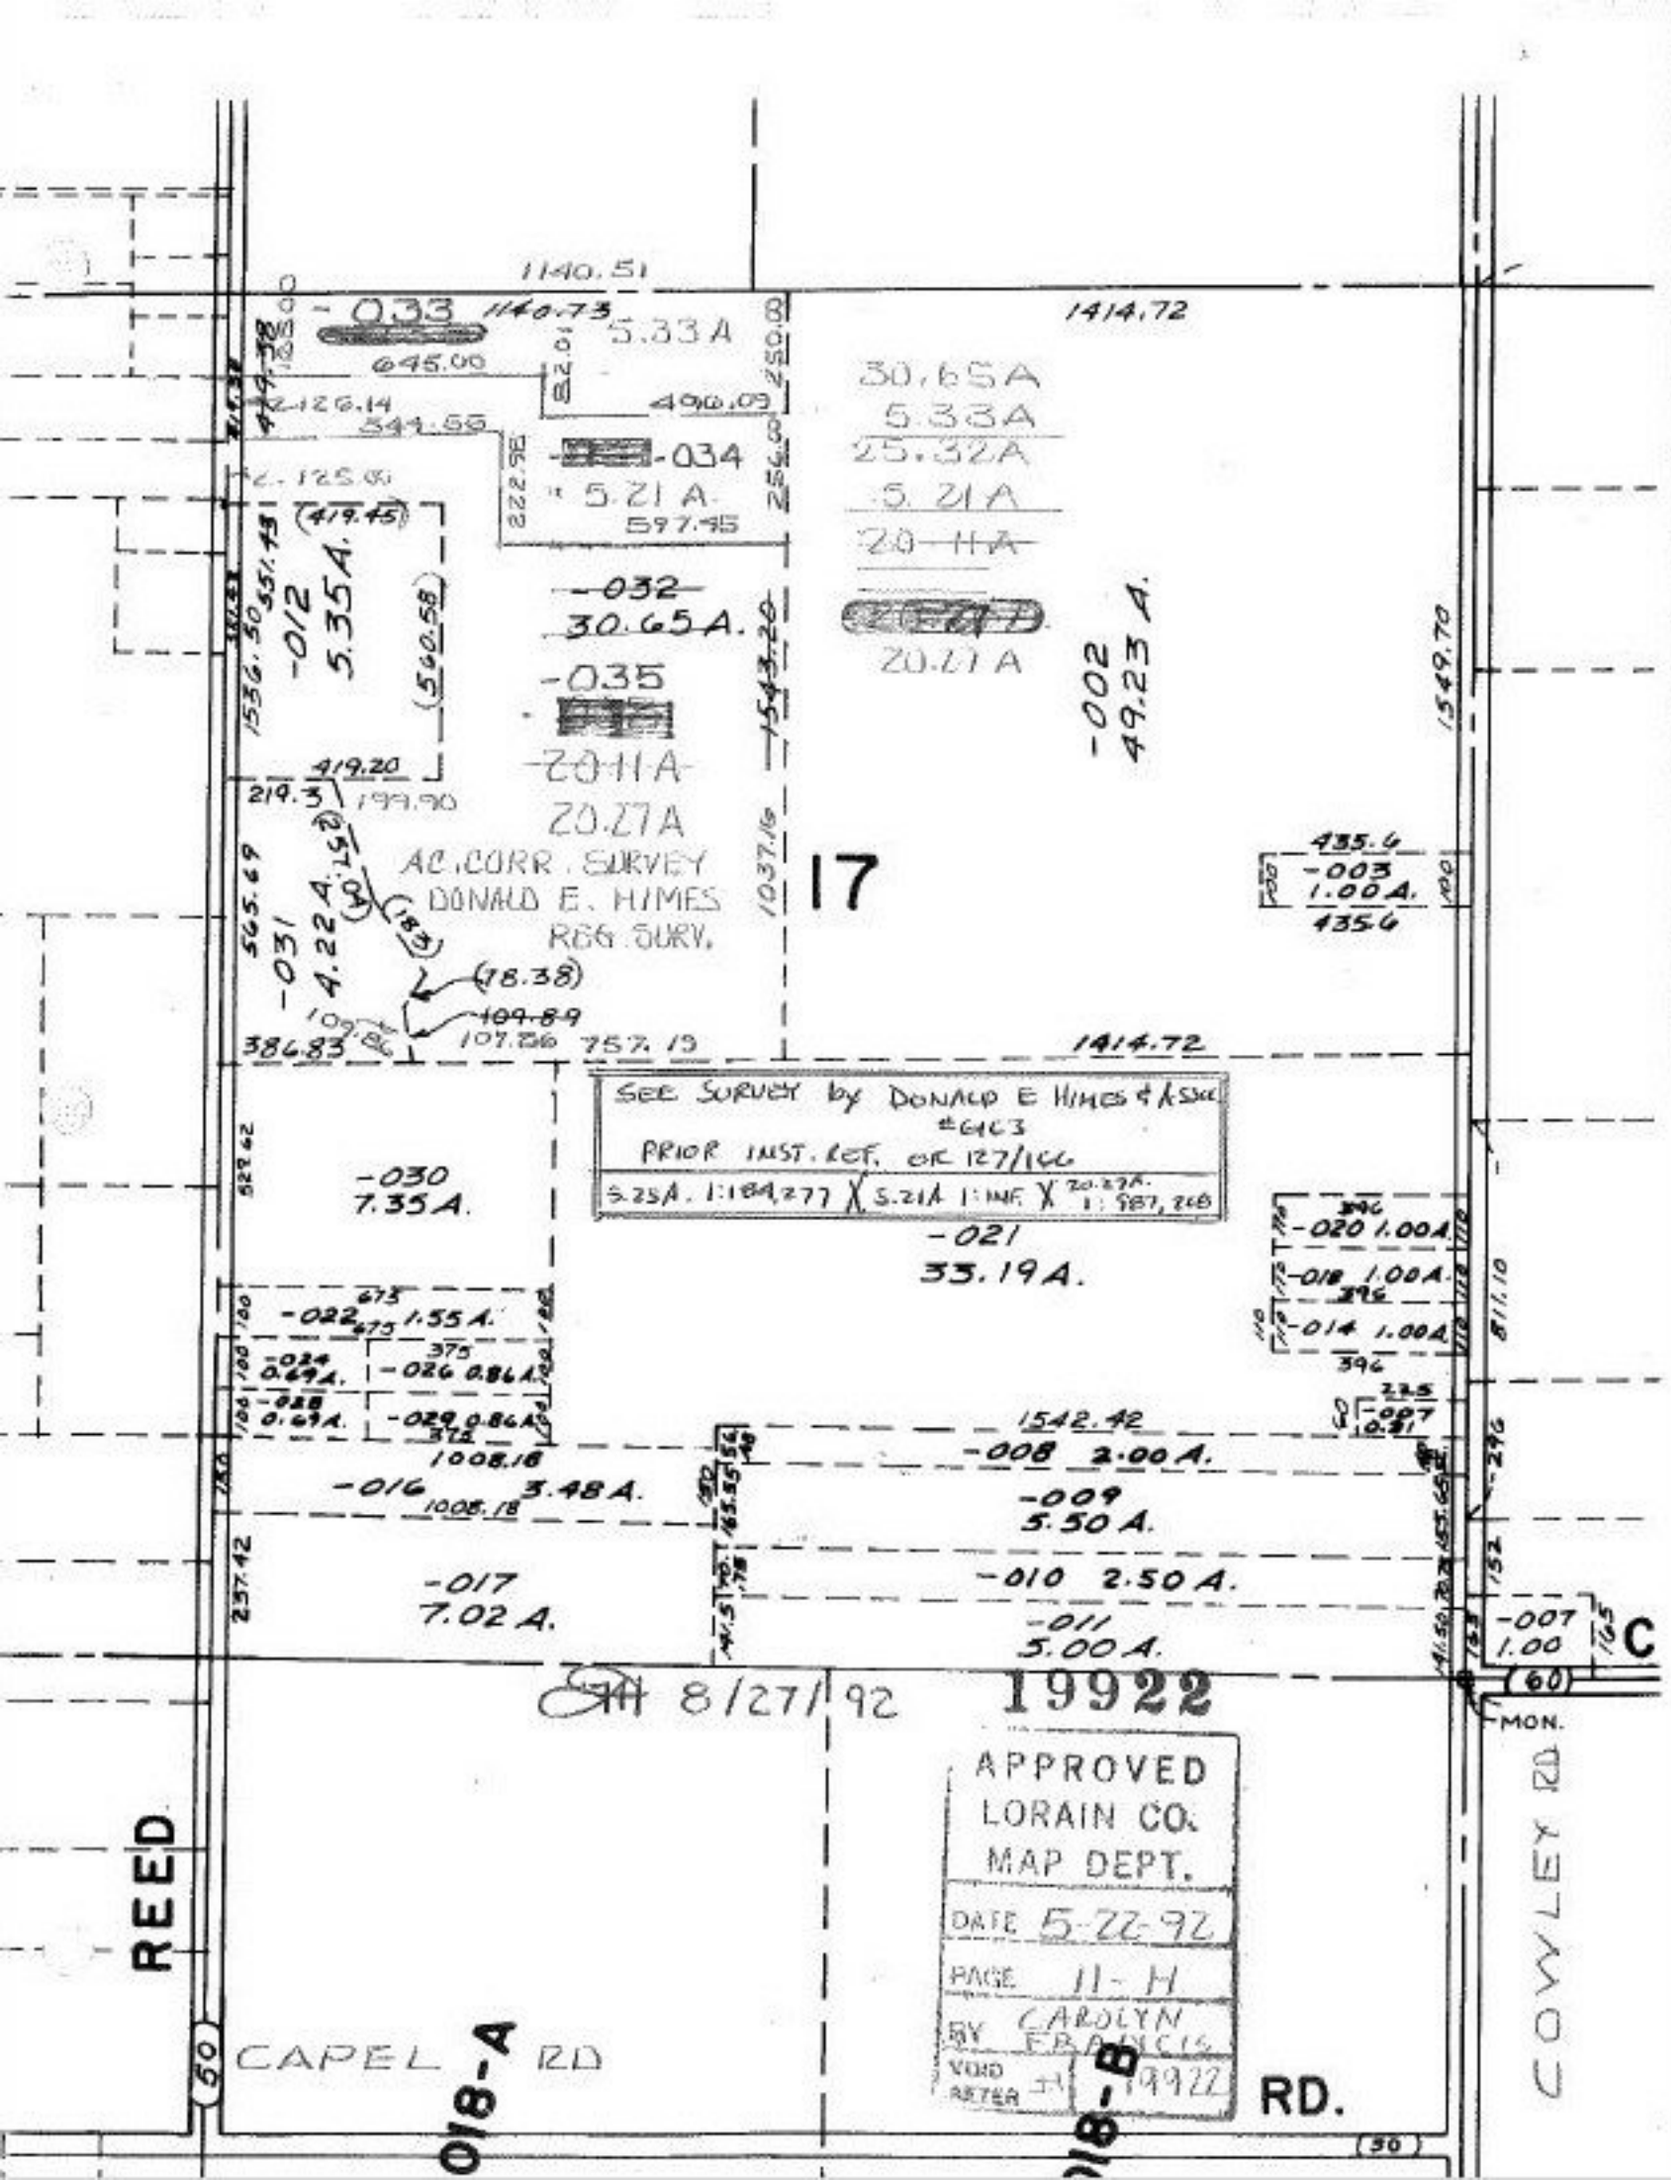

1140.51
-033
1140.73
5.33 A
645.00
1414.72
30.65A
5.33A
25.32A
5.21A
20.11A
20.27A
-034
5.21 A
597.45
-032
30.65 A.
-035
20.11A
20.27A
-012
5.35A.
(560.58)
-002
49.23 A.
1549.70
AC. CORR. SURVEY
DONALD E. HIMES
REG. SURV.
17
-031
4.22 A.
(78.38)
109.89
107.86
757.19
386.83
1414.72
SEE SURVEY by DONALD E HIMES & ASSOC
#6163
PRIOR INST. REF. OR 127/166
5.25A. 1:184,277 X 5.21A 1:INF. X 20.27A. 1:987,268
-030
7.35 A.
-021
33.19 A.
-020 1.00A.
-018 1.00A.
-014 1.00A.
-022 1.55 A.
-024 0.69A.
-026 0.86A.
-028 0.69A.
-029 0.86A.
1008.18
1542.42
-008 2.00 A.
-016 3.48 A.
-009
5.50 A.
-017
7.02 A.
-010 2.50 A.
-011
5.00 A.
-007
1.00
C
8/27/92
19922
APPROVED
LORAIN CO.
MAP DEPT.
DATE 5-22-92
PAGE 11-H
BY CAROLYN FRANCIS
VOID REFER 19922
MON.
REED
CAPEL RD
018-A
018-B
RD.
COWLEY RD