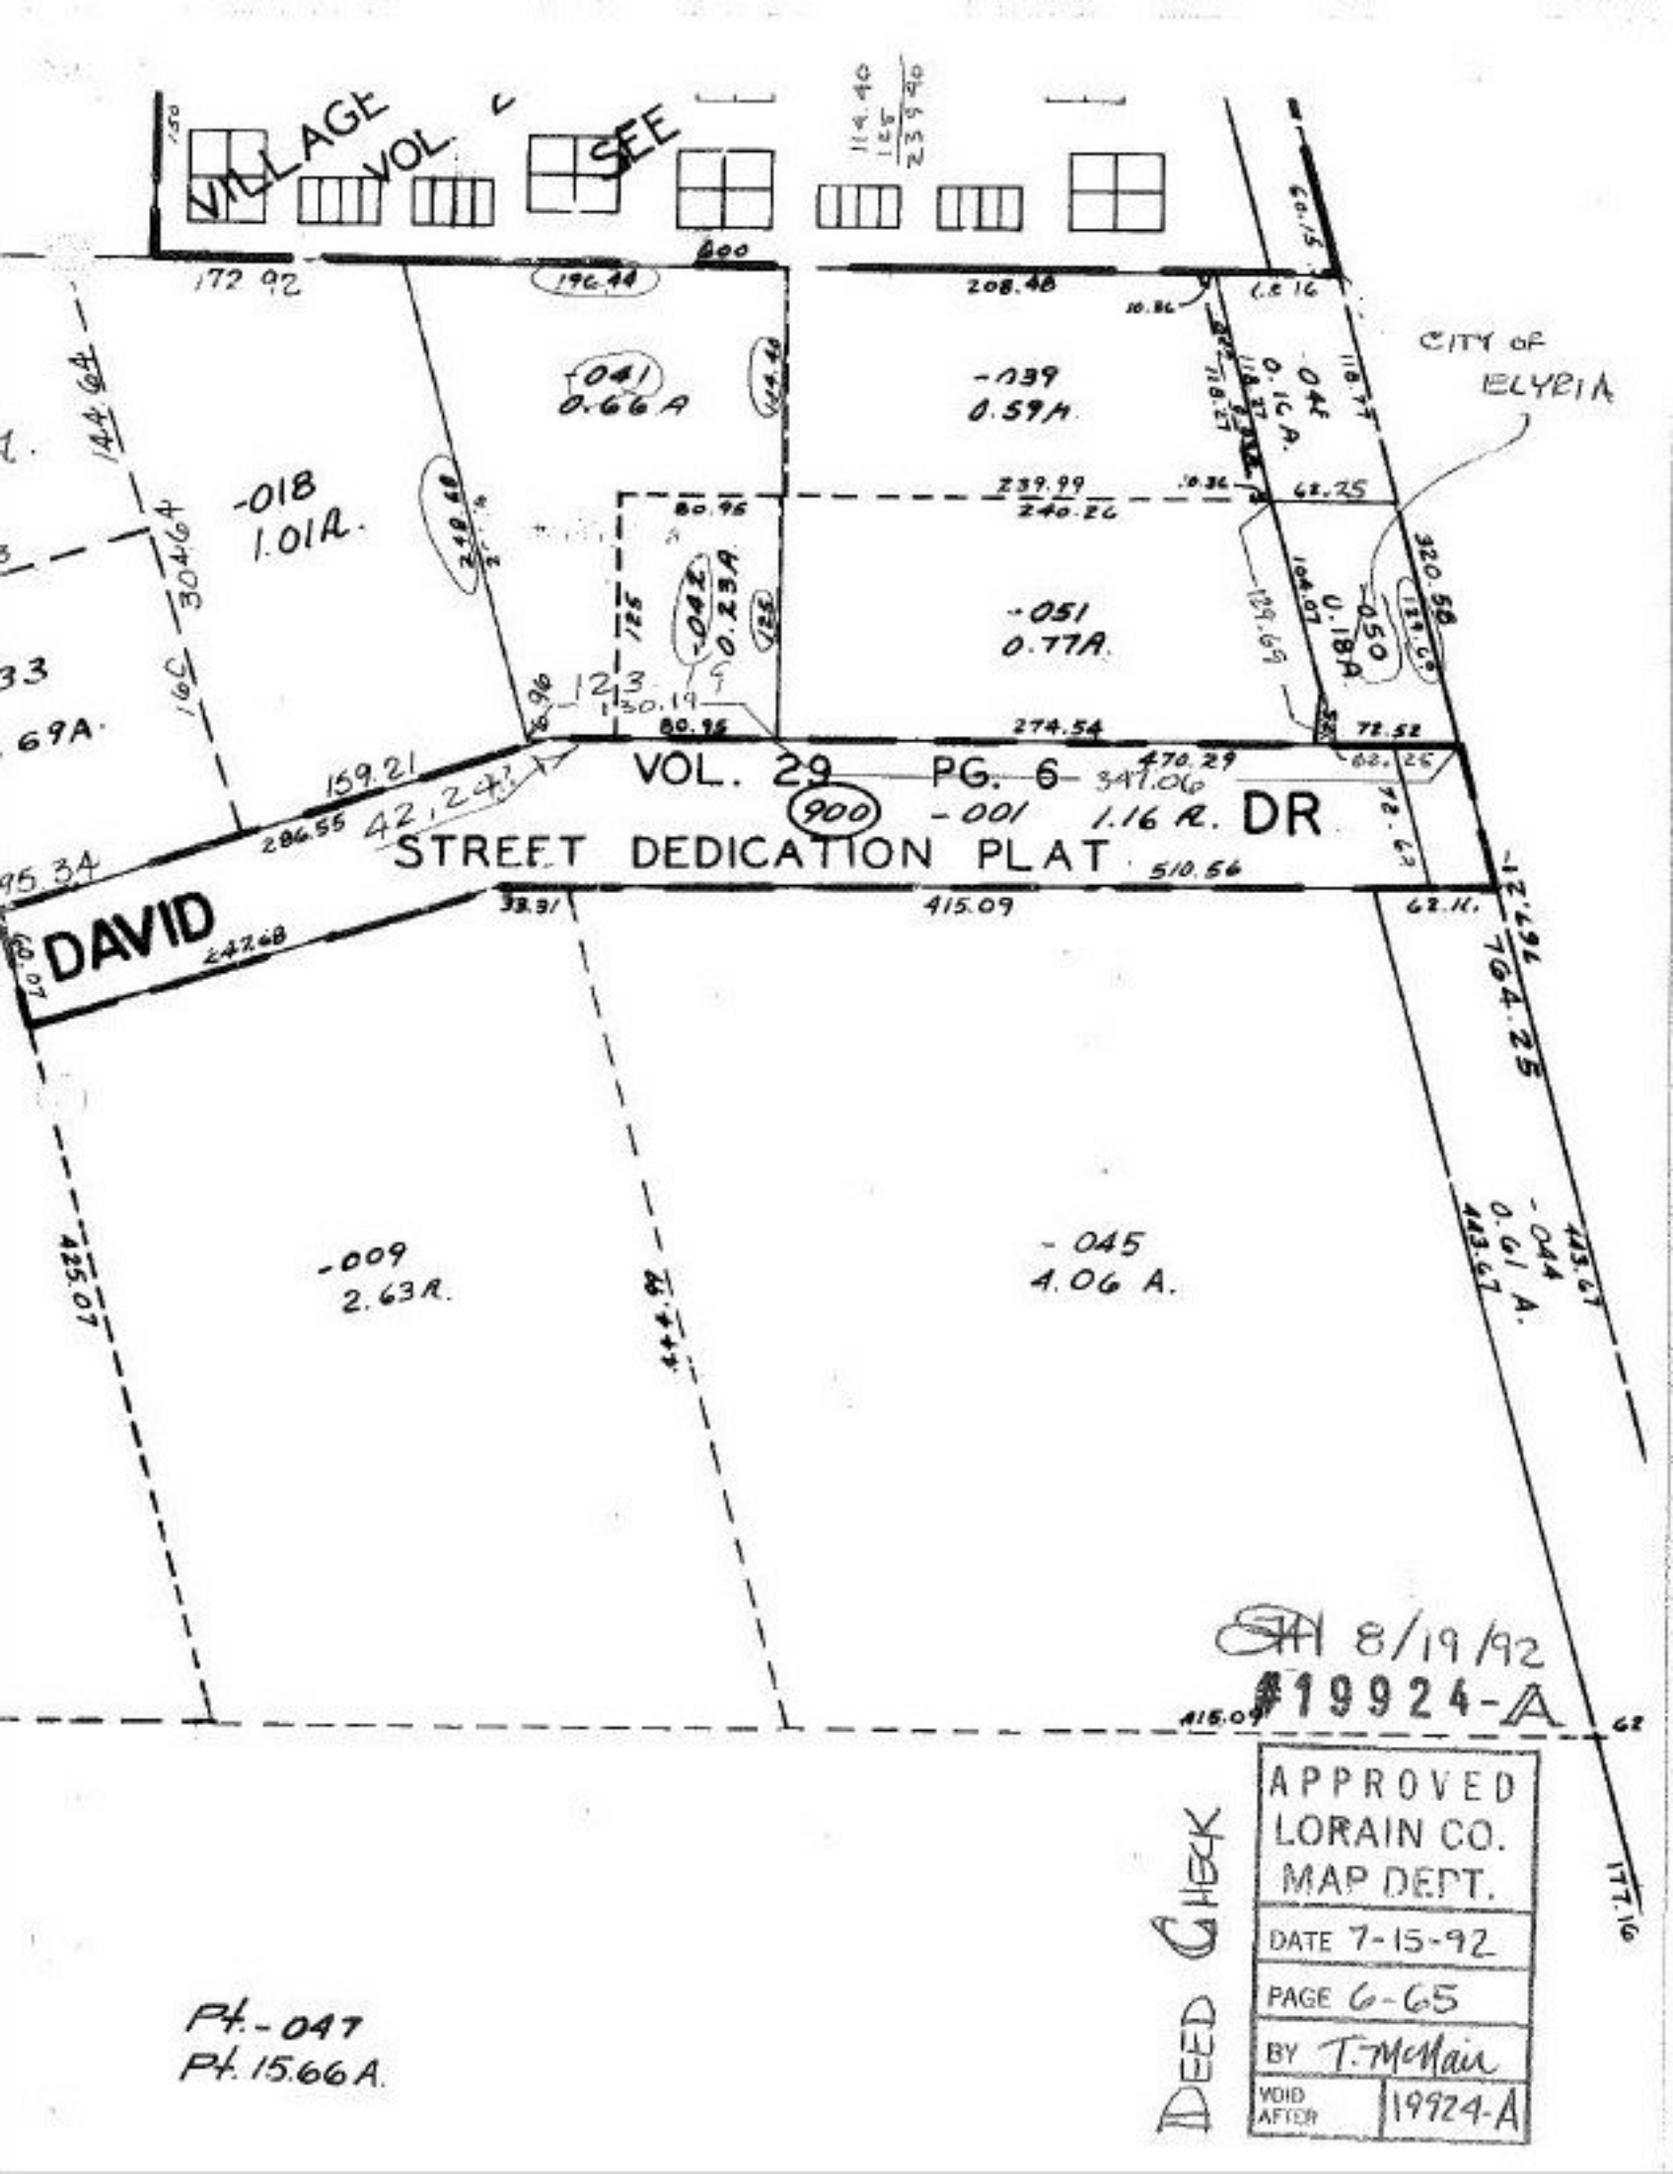
VILLAGE
VOL
SEE
CITY OF ELYRIA
-018
1.01A.
-041
0.66A
-039
0.59A.
-042
0.23A
-051
0.77A.
-050
0.18A
-044
0.61 A.
-045
4.06 A.
-009
2.63R.
VOL. 29 PG. 6
900
-001 1.16 R. DR
STREET DEDICATION PLAT
DAVID
8/19/92
#19924-A
APPROVED
LORAIN CO.
MAP DEPT.
DATE 7-15-92
PAGE 6-65
BY T. McMain
VOID AFTER 19924-A
DEED CHECK
Pt.-047
Pt. 15.66 A.