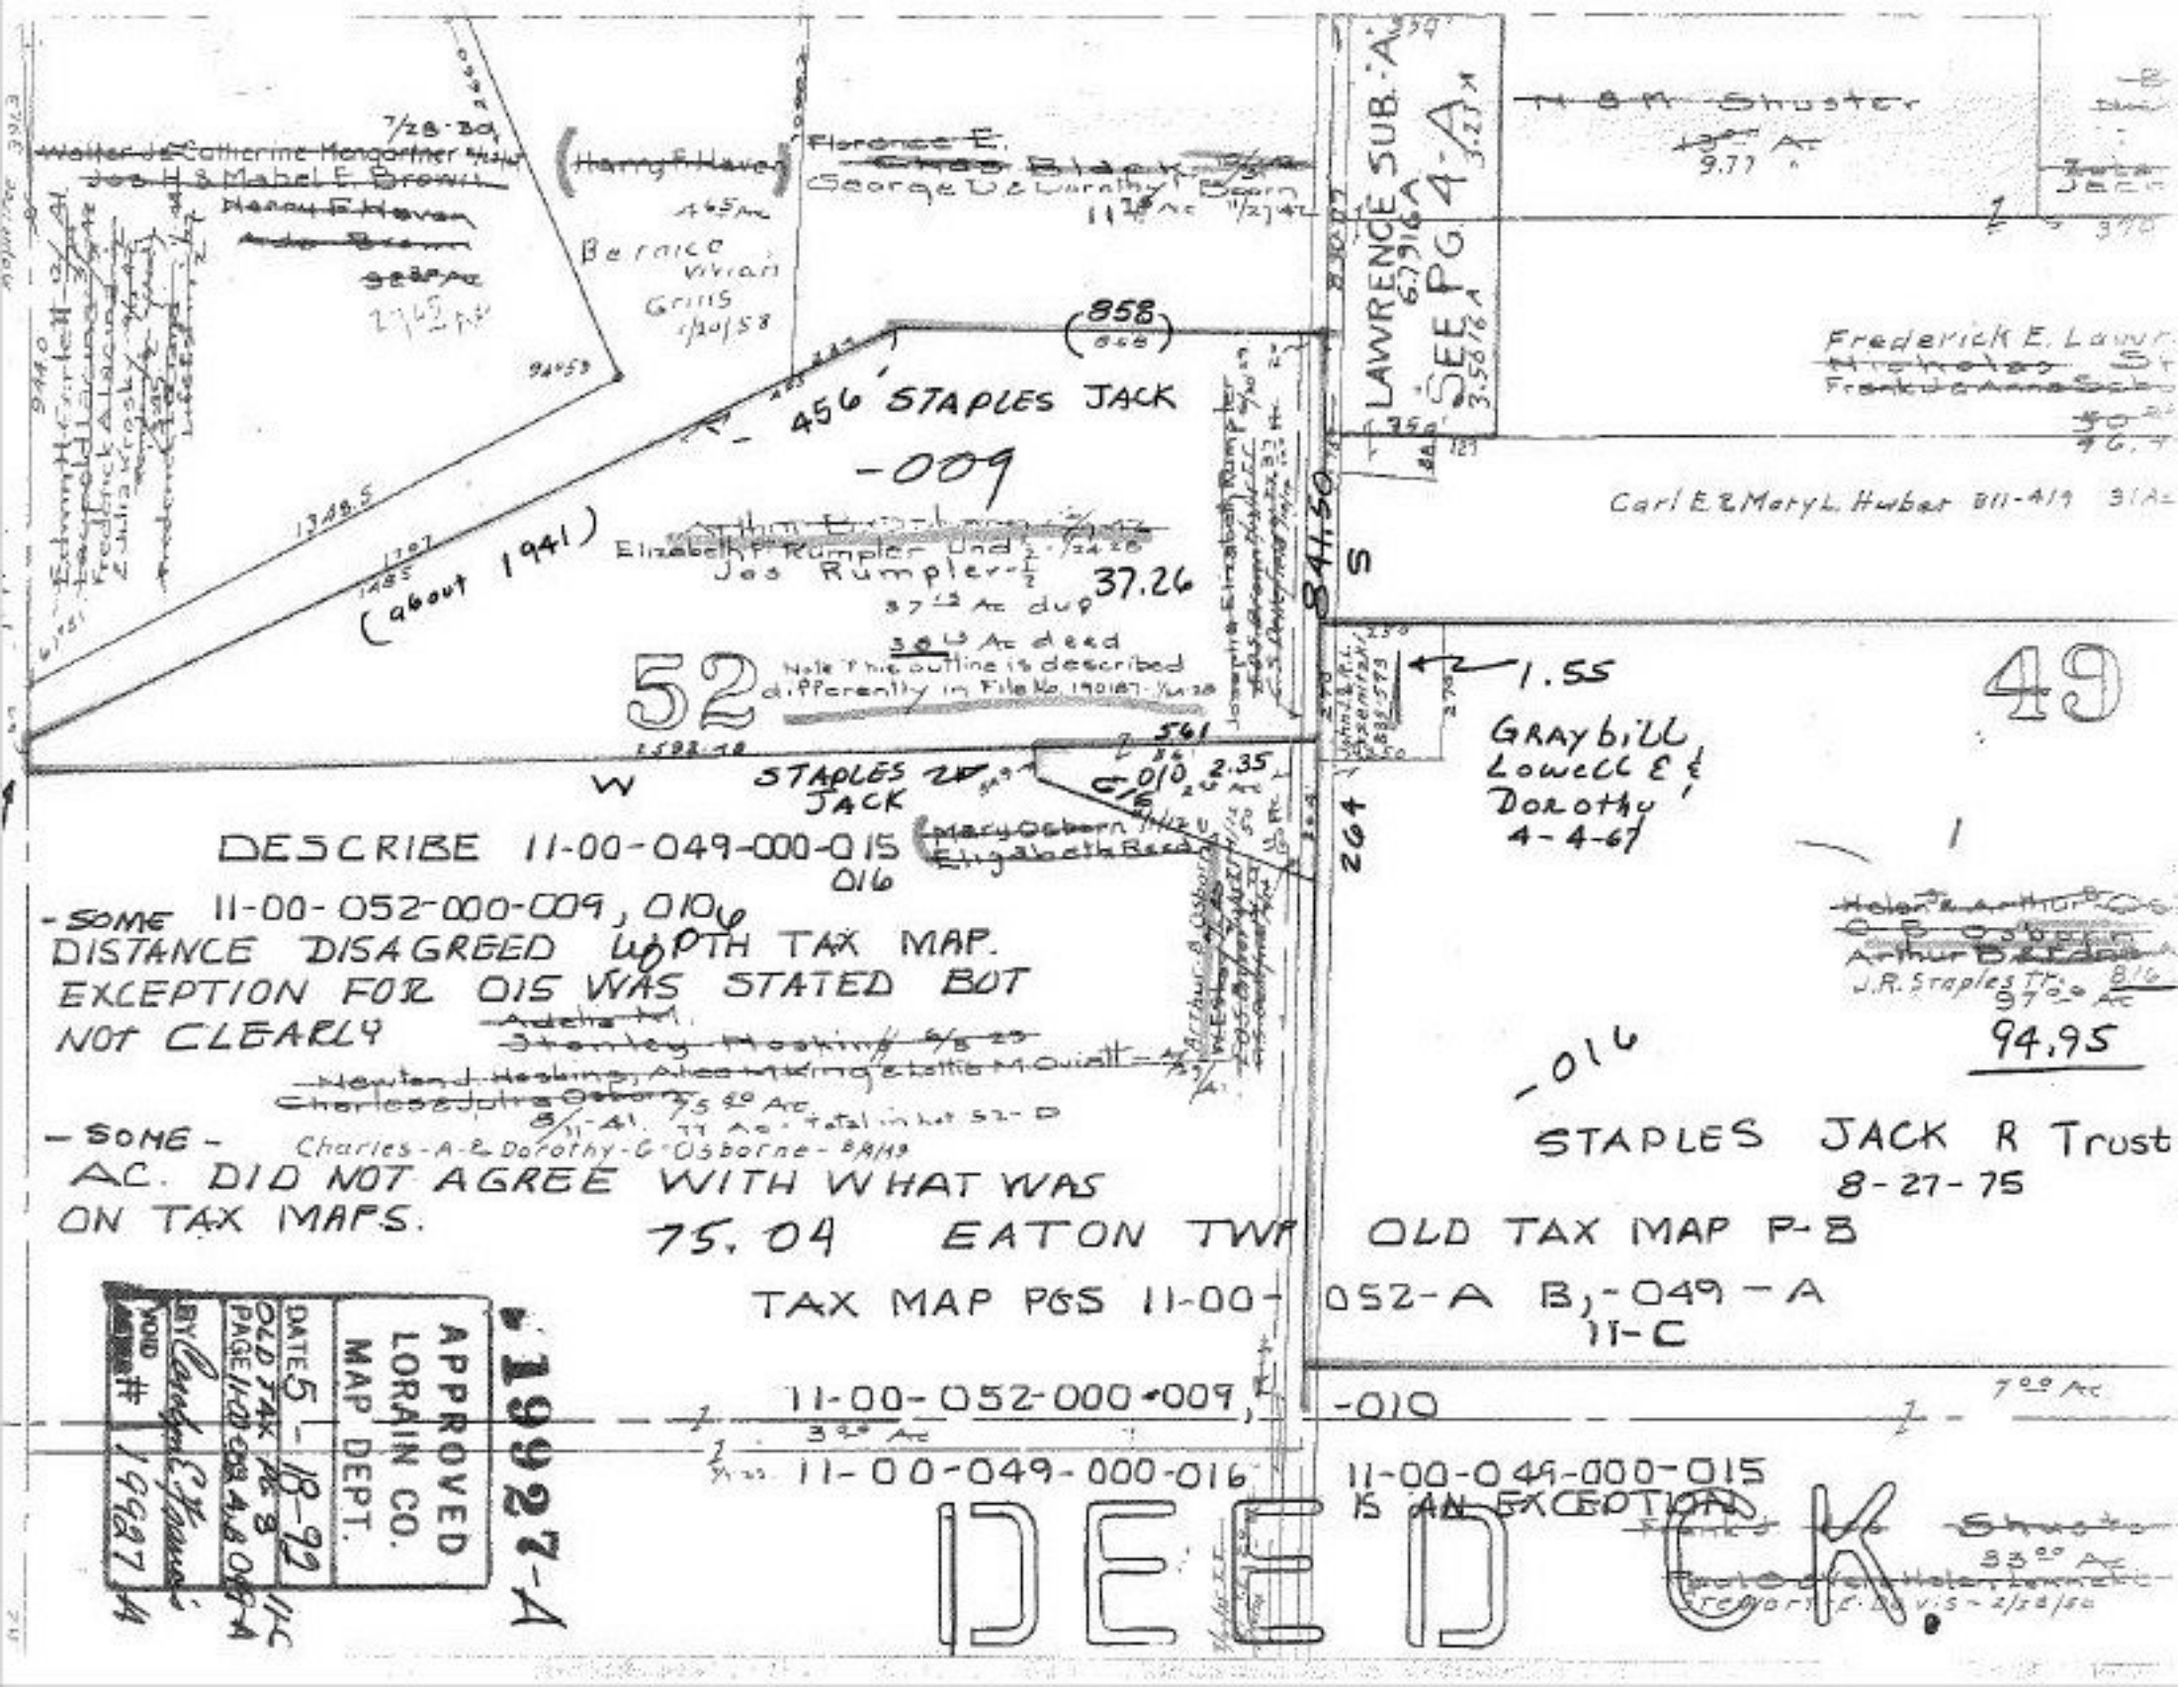
LAWRENCE SUB. "A"
6/29/16A
SEE PG 4-A
3.21 A
3.58/6A
H & M Shuster
9.77 Ac
Frederick E. Lawr
Carl E. & Mary L. Huber 811-419 3 A
Florence E.
George D. & Dorothy I. Beard
11.78 Ac 11/2 Ac
Harry F. Haven
Bernice Vivian Grimes 1/20/58
Walter J. & Catherine Hengartner 7/28-30
Jos H. & Mabel E. Brown
Harry F. Haven
2.65 Ac
2.65 Ac
94.53
1349.5
1707
1485
(about 1941)
456' STAPLES JACK
-009
Elizabeth F. Rumpler Und 1/2
Jos Rumpler- 1/2
37.26
37.13 Ac dup
3.0 Ac deed
Note: This outline is described differently in File No. 190187- 1/4/28
858
(858)
84.30
S
52
561
1.55
Graybill Lowell E & Dorothy 4-4-67
49
W
STAPLES JACK
2.35
264
DESCRIBE 11-00-049-000-015
016
Mary Osborn 1/12 U
Elizabeth Reed
- SOME 11-00-052-000-009, 010
DISTANCE DISAGREED WITH TAX MAP.
EXCEPTION FOR 015 WAS STATED BUT
NOT CLEARLY
Adella M.
Stanley Hosking 5/8 29
Newland Hosking, Alice Hosking & Hattie M. Quiatt 4/8 29
Charles & Lottie Osborn 3/8 29 Ac
8/11-41. 77 Ac. Total in lot 52- D
- SOME - Charles A. & Dorothy G. Osborne - 8/8/49
AC. DID NOT AGREE WITH WHAT WAS
ON TAX MAPS.
75.04 EATON TWP OLD TAX MAP P-B
TAX MAP PGS 11-00-052-A B, -049-A
11-C
Arthur Beard
J.R. Staples Tr. 97.0 Ac 8/6
94.95
-016
STAPLES JACK R Trust
8-27-75
11-00-052-000-009, -010
3.0 Ac
7.0 Ac
11-00-049-000-016
11-00-049-000-015
IS AN EXCEPTION
APPROVED
LORAIN CO.
MAP DEPT.
DATE 5-18-92
OLD TAX MAP & PAGE 11-C
BY Carolyn C. Hauser
VOID #19927
19927-A
DEED
Shuster
33.0 Ac
Frederick E. Davis - 4/28/60