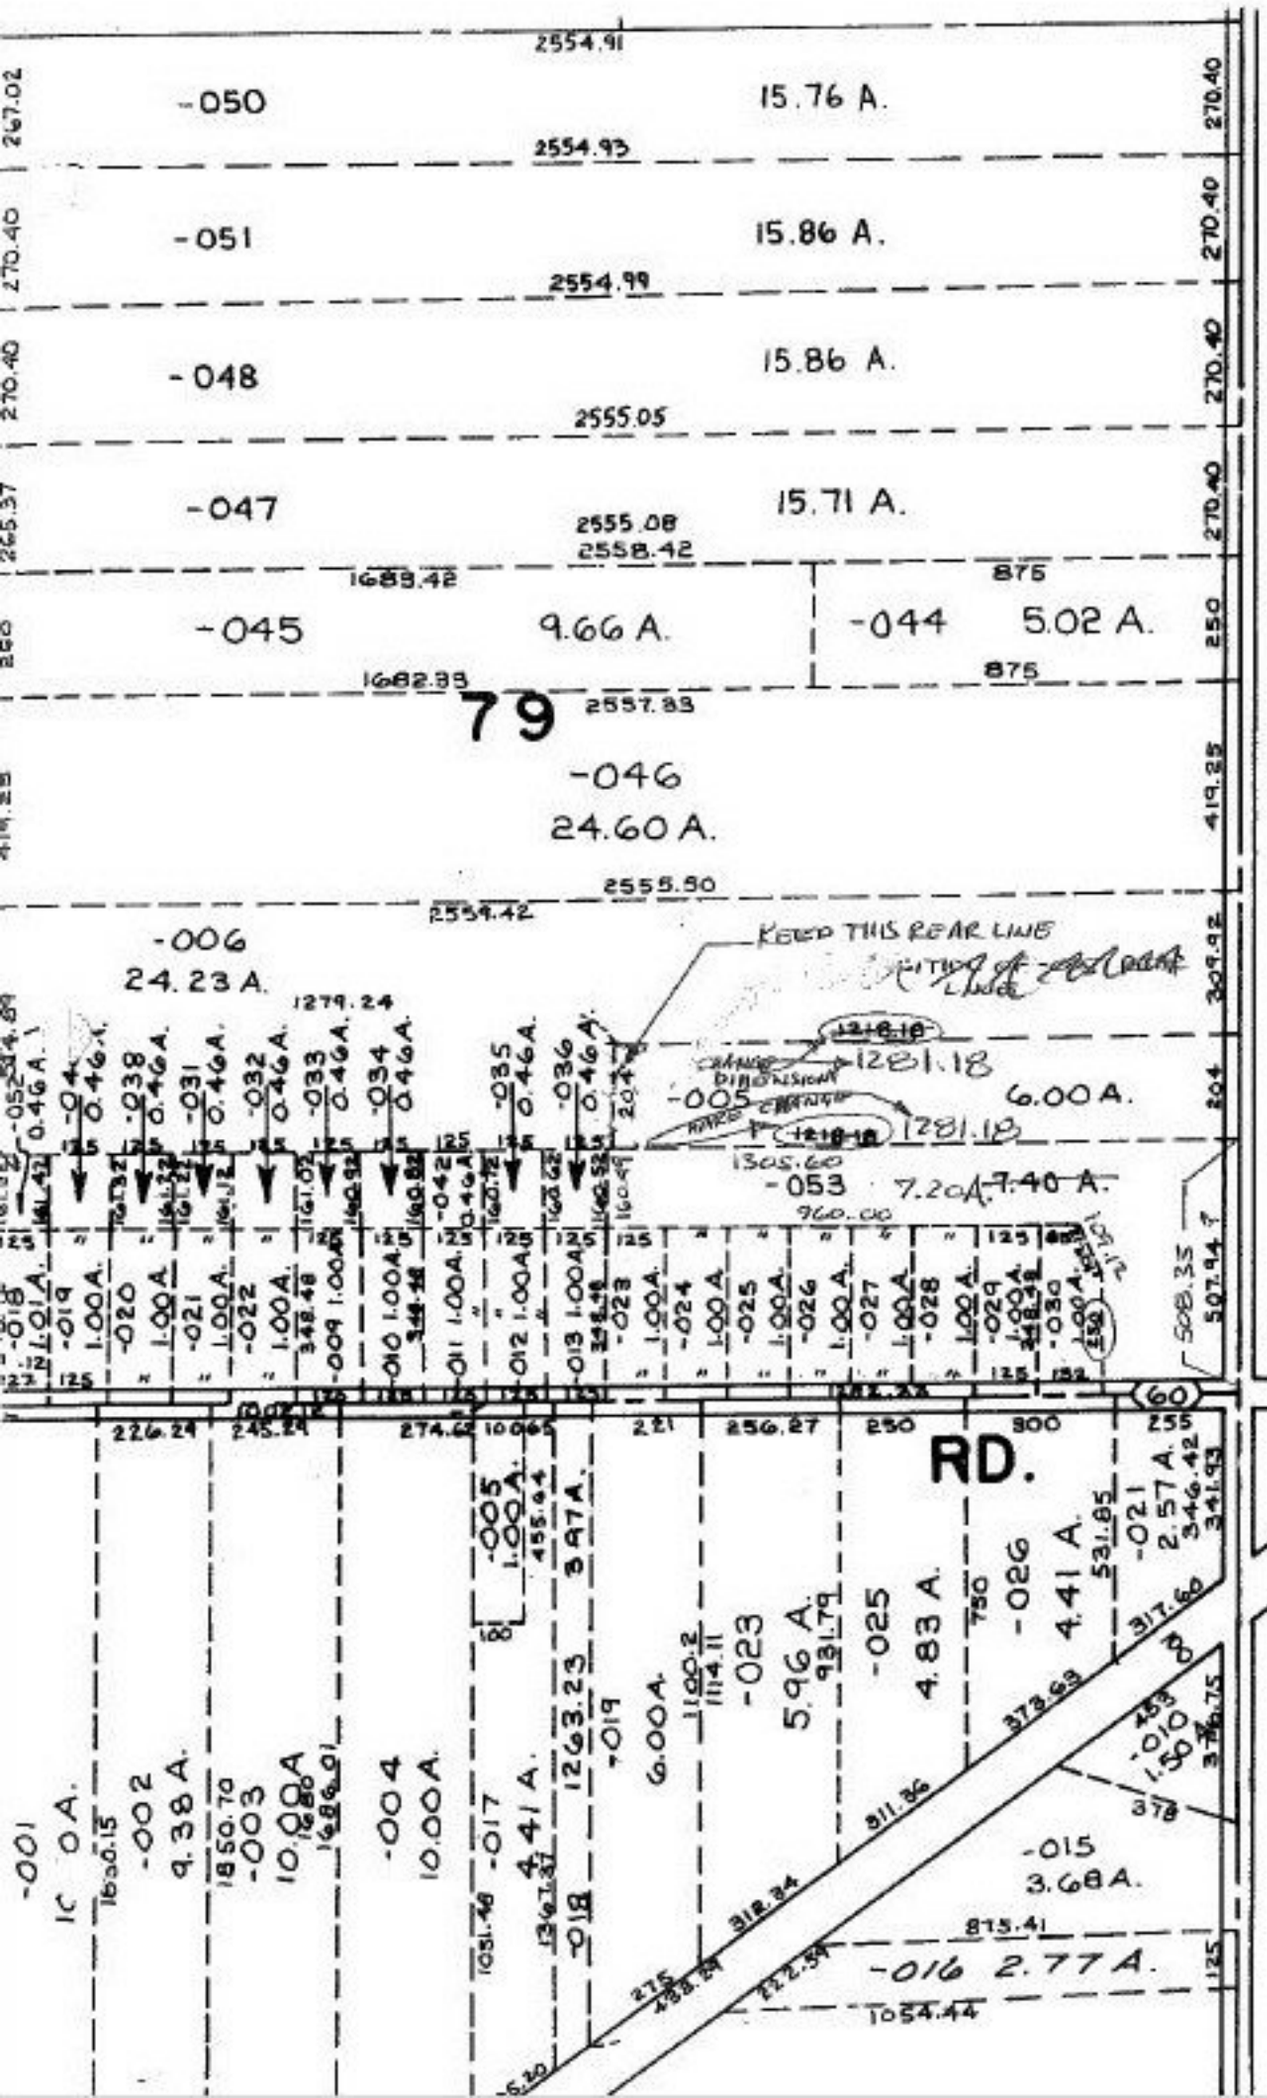

SURVEY DESCRIPTION
BY CHRIS. DEMPSEY,
DEMPSEY & NEFF, INC.
CL- 1:288,315
ON 24"x 36" MAP

PRIOR INST. REF. -

9/2/92

ACRE.

CORR.

#19929-A

APPROVED
LORAIN CO.
MAP DEPT.

DATE 6-3-92

PAGE 12-A

BY T. McMain

VOID AFTER 199