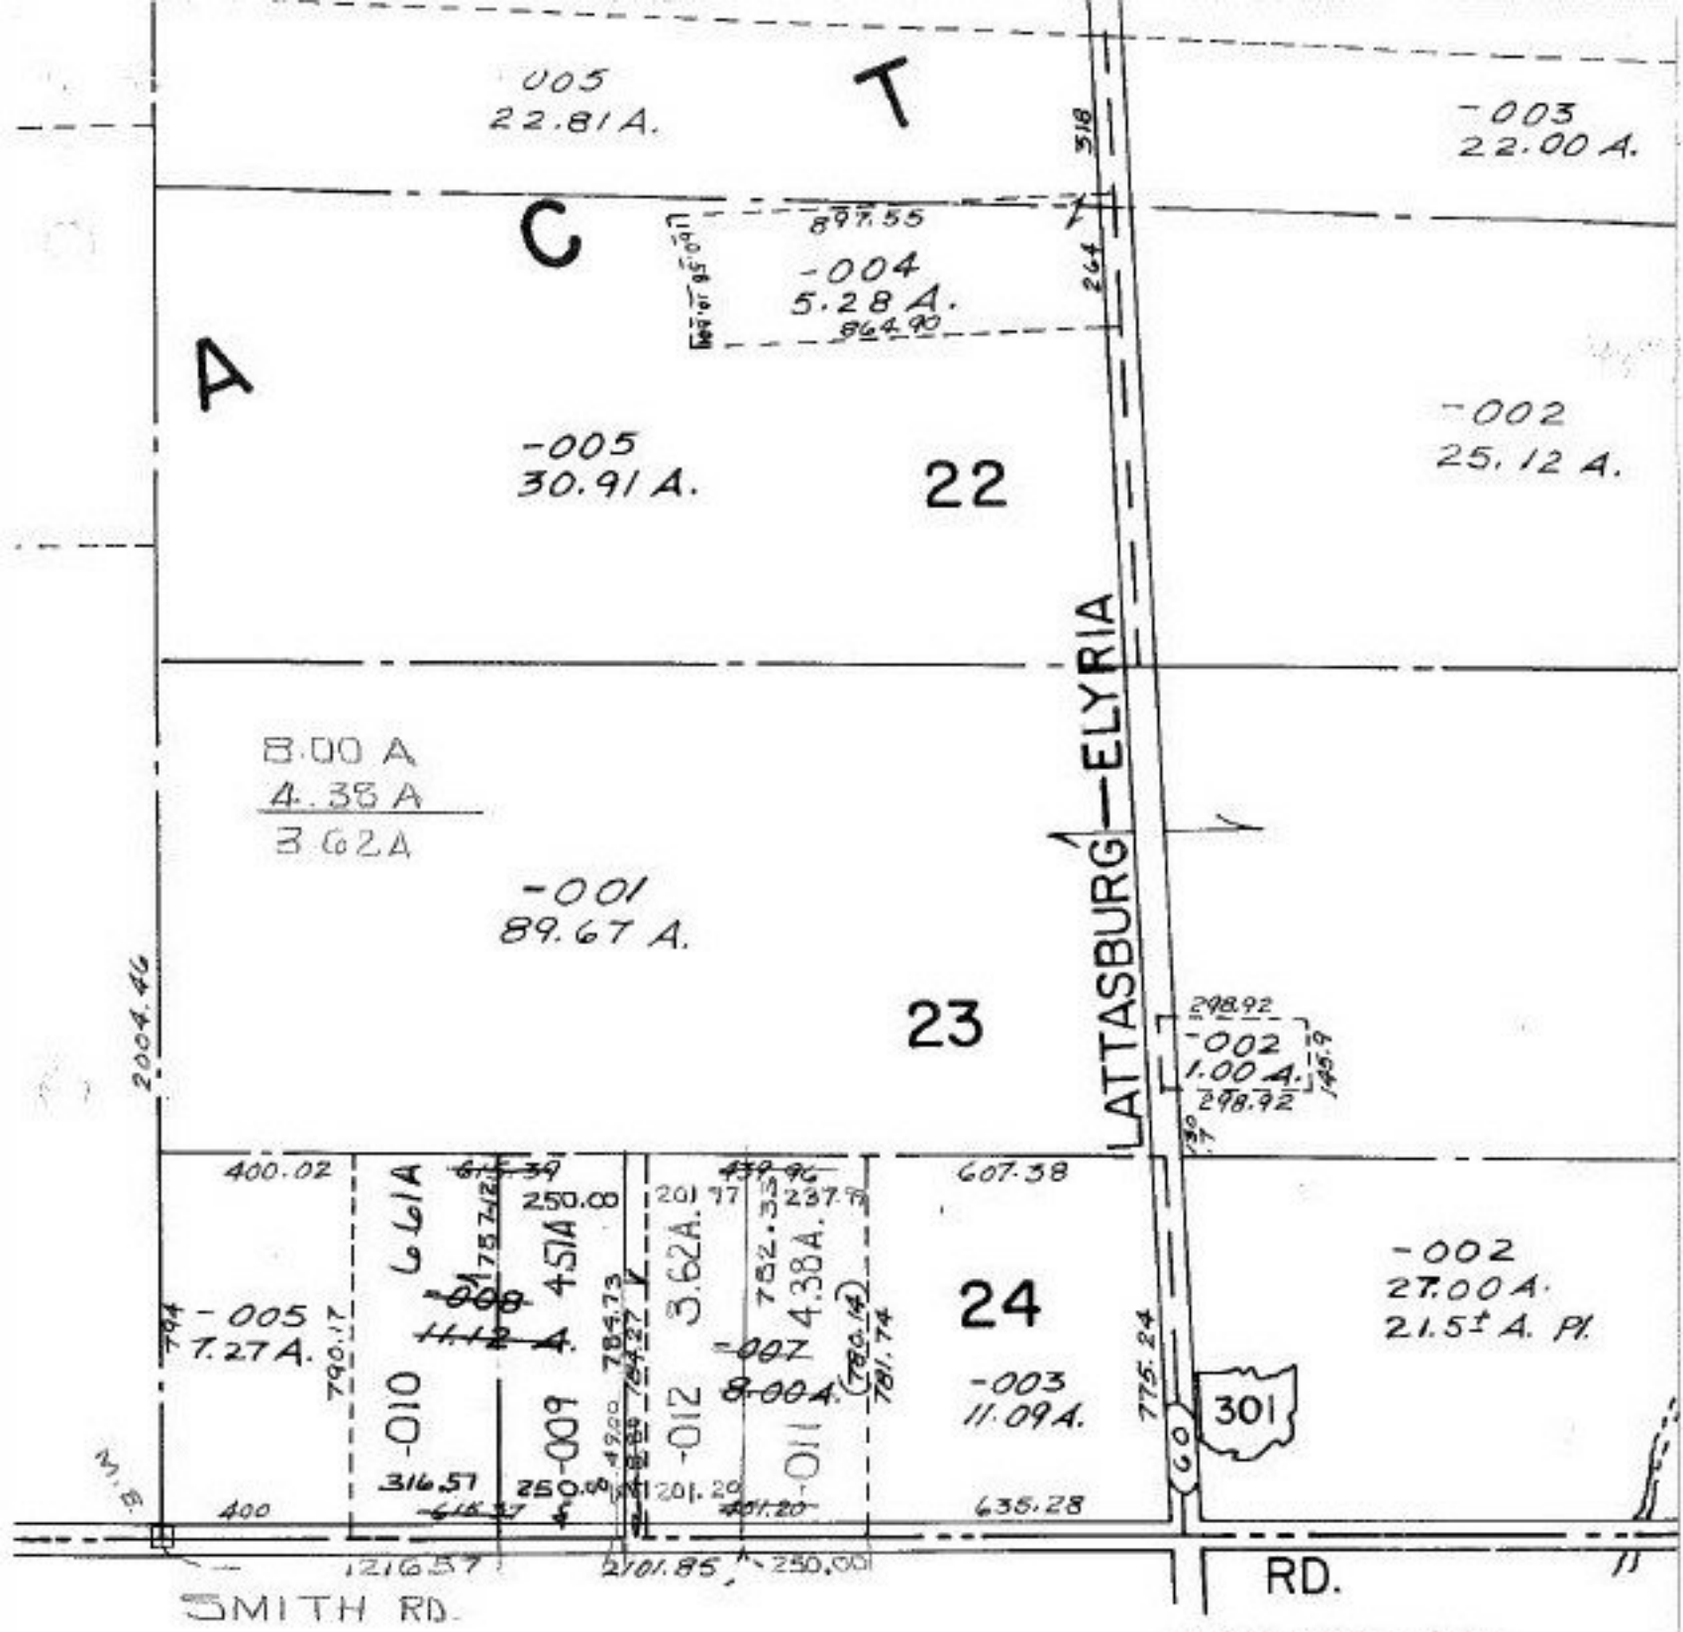

SN 6/11/92

19938

19-01-024-000-
PRIOR INST: 1184/363 1376/393
SURVEYED BY: JOHN POZYWAK
C=1:325,779 REG. SURVEYOR

APPROVED
LORAIN CO.
MAP DEPT.
DATE 6-8-92
PAGE 19-F
BY CAROLYN FRANCIS
VOID AFTER # 19938