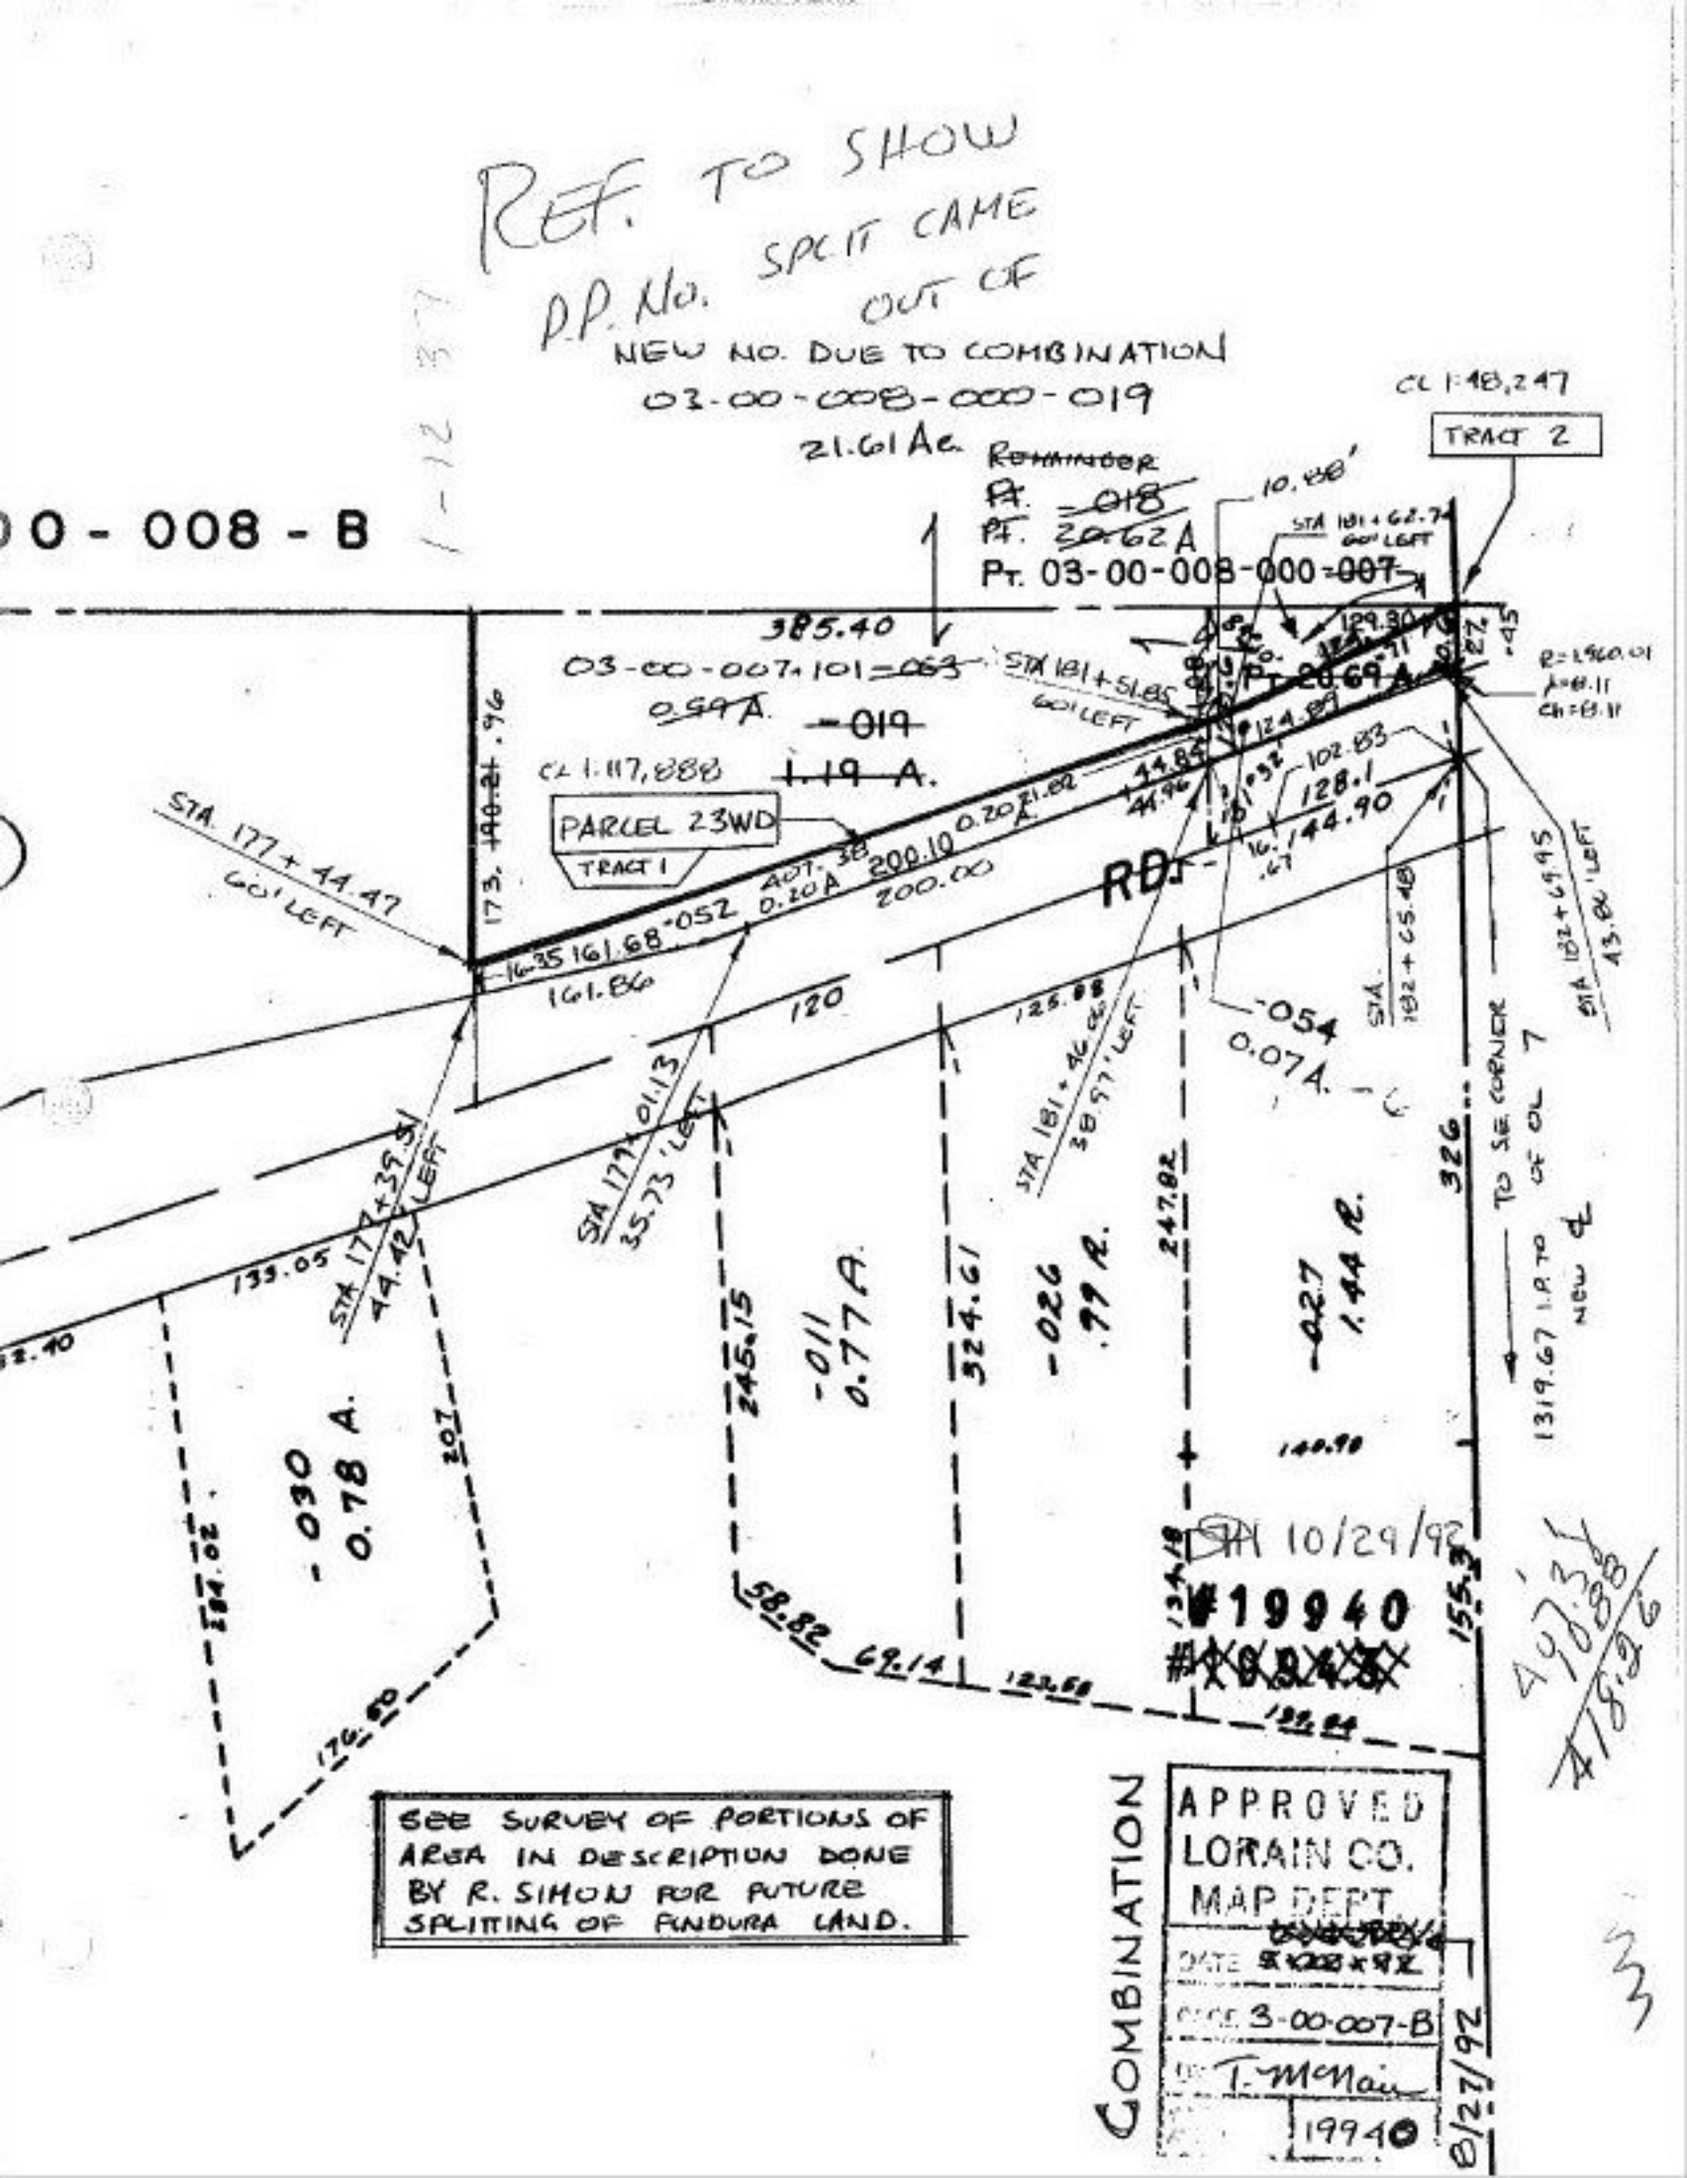
REF. TO SHOW
P.P. No. SPLIT CAME OUT OF
NEW NO. DUE TO COMBINATION
03-00-008-000-019
21.61 Ac.
~~REMAINDER~~
~~Pt. -018~~
~~Pt. 20.62 A~~
Pt. 03-00-008-000-~~007~~
CL 1:48,247
TRACT 2
00 - 008 - B
385.40
03-00-007-101-~~063~~
~~0.59 A.~~
~~-019~~
~~1.19 A.~~
CL 1:117,888
PARCEL 23WD
TRACT 1
STA 181+62.74 60' LEFT
STA 181+51.85 60' LEFT
STA 177+44.47 60' LEFT
STA 177+39.51 44.42' LEFT
STA 179+01.13 35.73' LEFT
STA 181+46.06 38.97' LEFT
STA 182+65.48
STA 182+69.95 43.86' LEFT
RD.
-054
0.07 A.
-030
0.78 A.
-011
0.77 A.
-026
.99 R.
-027
1.44 R.
TO SE CORNER OF OL 7
1319.67 I.P. TO NEW ℄
10/29/92
#19940
SEE SURVEY OF PORTIONS OF AREA IN DESCRIPTION DONE BY R. SIMON FOR FUTURE SPLITTING OF FINDURA LAND.
COMBINATION
APPROVED
LORAIN CO.
MAP DEPT.
DATE
CODE 3-00-007-B
T. McNair
19940
8/27/92