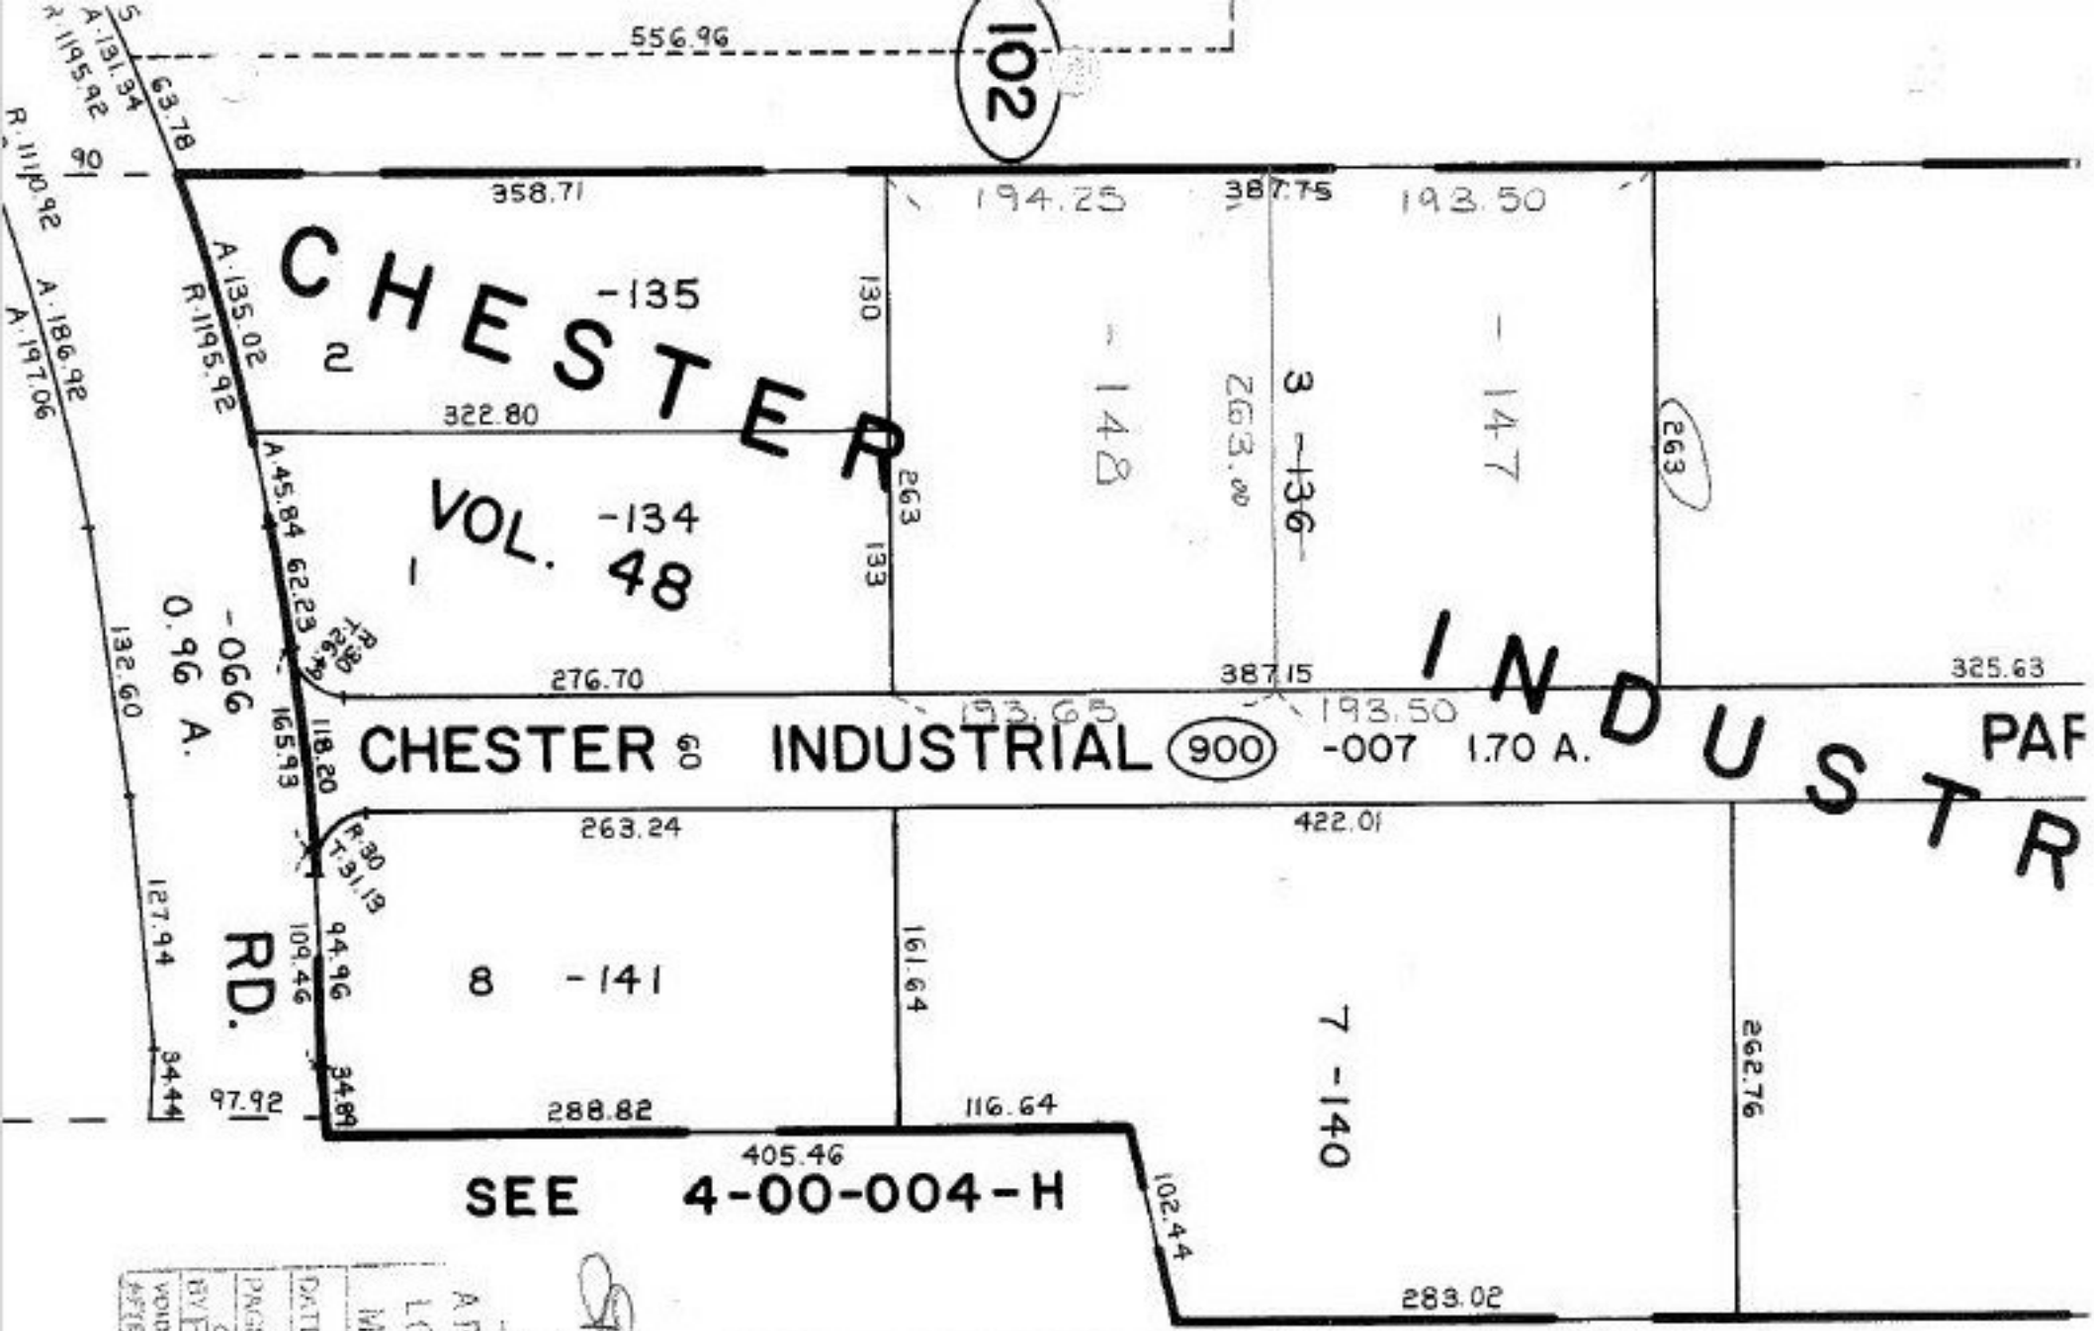

04-00-004-102- PRIOR INST: O.R.455/663
SURVEYED BY: KS ASSOC. C=1: INF.