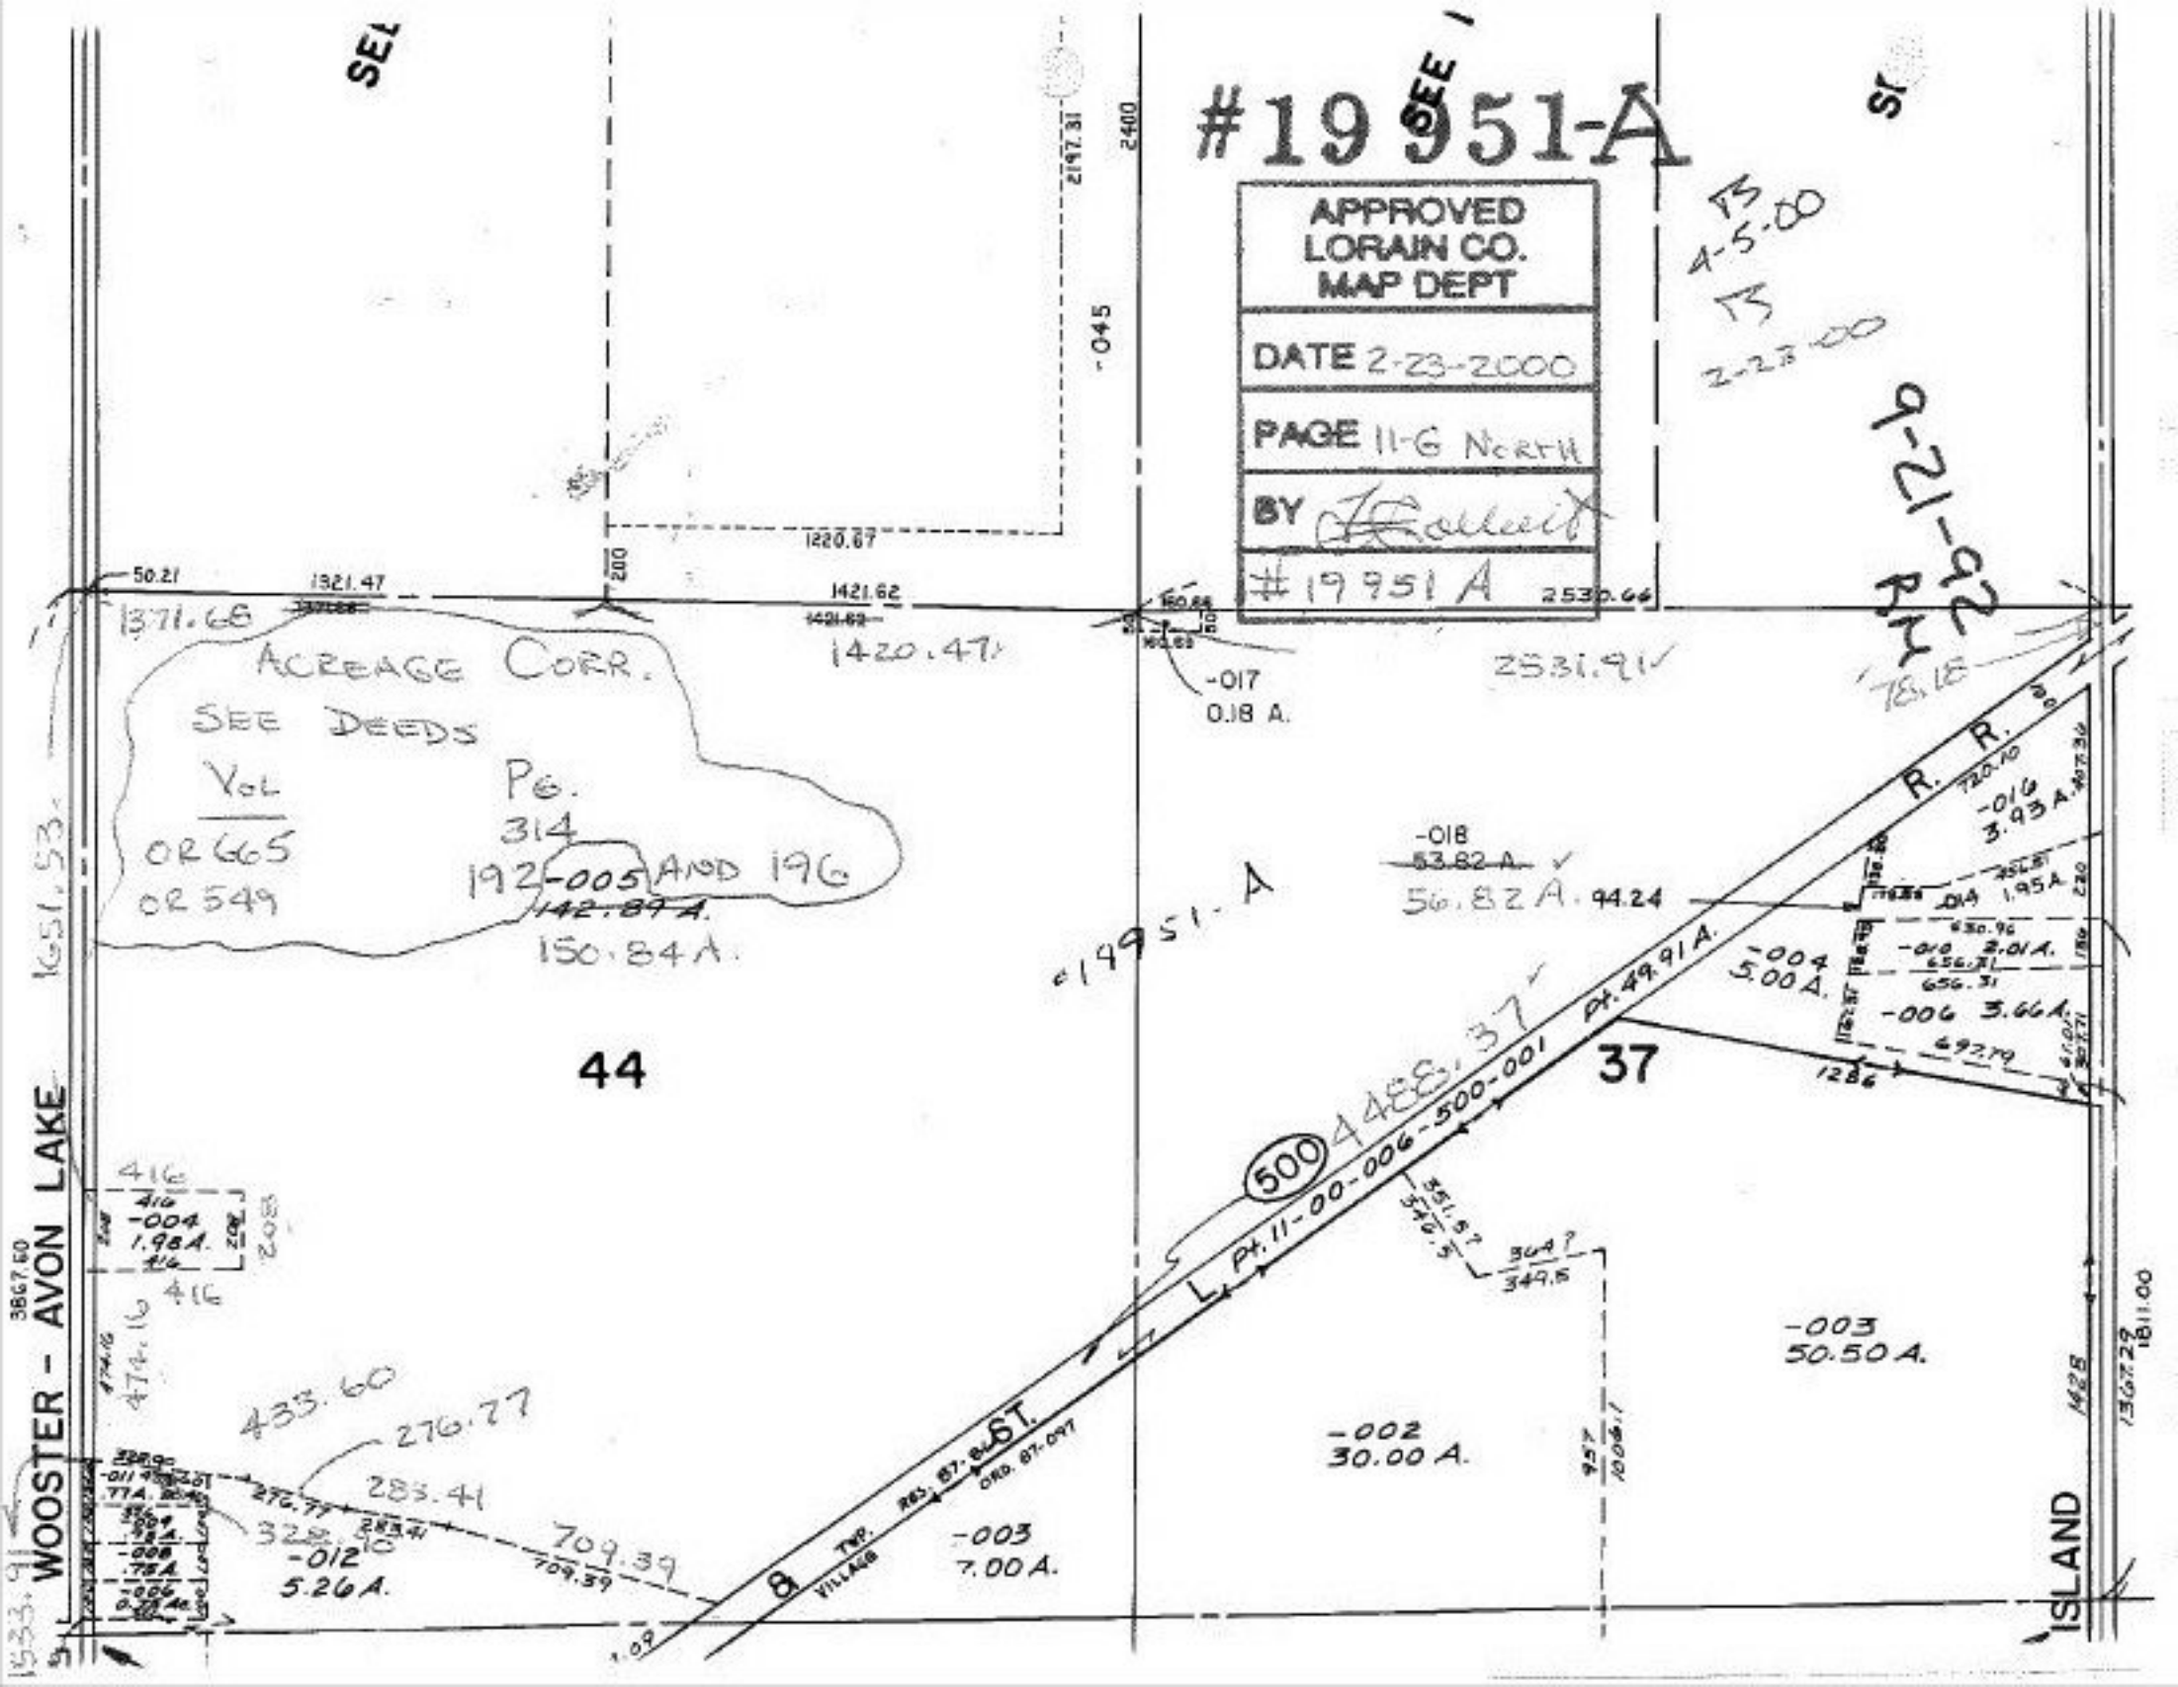
#19951-A
APPROVED
LORAIN CO.
MAP DEPT
DATE 2-23-2000
PAGE 11-G North
BY
#19951 A
ACREAGE CORR.
SEE DEEDS
VOL
OR665
OR549
PG.
314
192-005 AND 196
142.89 A.
150.84 A.
#19951-A
-017
0.18 A.
-018
53.82 A.
56.82 A. 94.24
-016
3.93 A.
-004
5.00 A.
-005 2.01 A.
-006 3.66 A.
-003
50.50 A.
-002
30.00 A.
-003
7.00 A.
-012
5.26 A.
-004
1.98 A.
44
37
8
500
Pt. 11-00-006-500-001
Pt. 49.91 A.
WOOSTER - AVON LAKE
ISLAND
R. R.
9-21-92
1371.68
1321.47
1421.62
1420.47
2531.91
2530.66
1220.87
2197.31
2400
-045
433.60
276.77
283.41
709.39
328.10
474.16
416
1533.91
1811.00