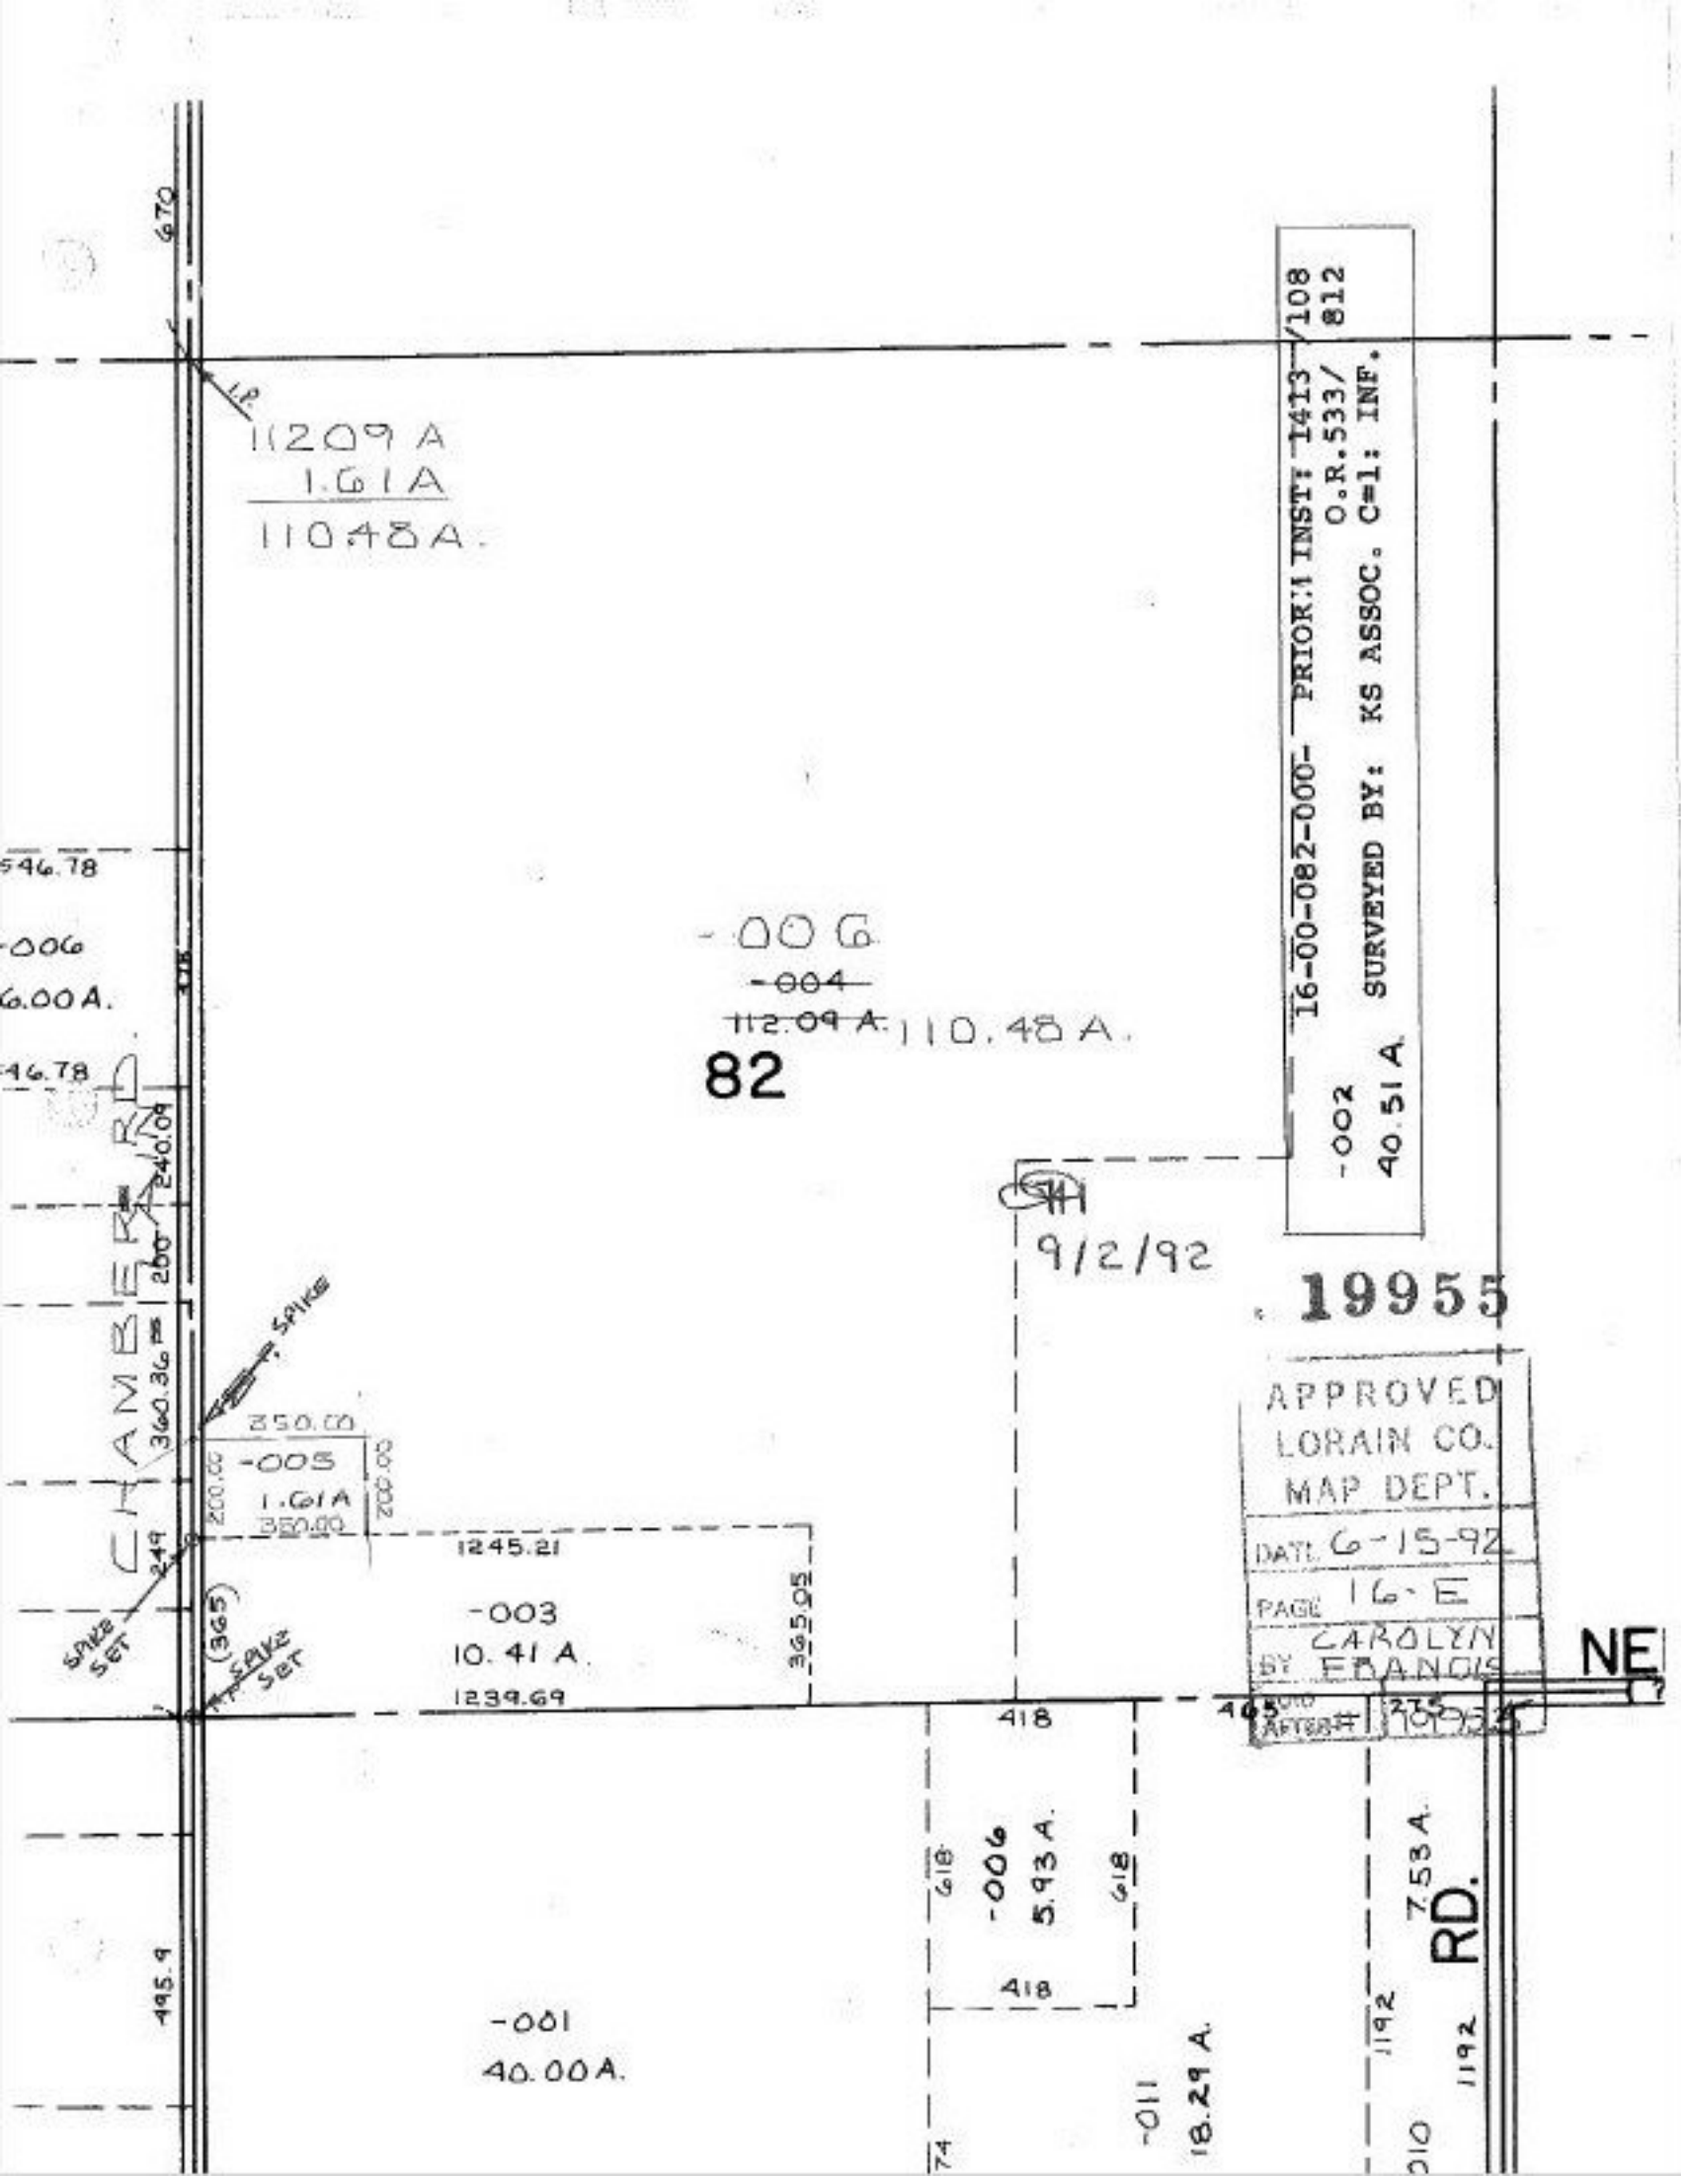
670
11209 A
1.61 A
110.48 A.
16-00-082-000-
PRIOR# INST: 1413/108
O.R.533/812
SURVEYED BY: KS ASSOC. C=1: INF.
-002
40.51 A.
-006
-004
112.09 A.
110.48 A.
82
546.78
-006
6.00 A.
546.78
CHAMBERLAIN RD.
240.09
200
360.36 PIN
SPIKE
350.00
-005
1.61 A
350.00
200.00
200.00
249
1245.21
-003
10.41 A.
1239.69
365.05
SPIKE SET
(365)
SPIKE SET
9/2/92
19955
APPROVED
LORAIN CO.
MAP DEPT.
DATE 6-15-92
PAGE 16-E
BY CAROLYN FRANCIS
NE
418
-006
5.93 A.
618
618
418
-001
40.00 A.
-011
18.29 A.
74
495.9
1192
1192
7.53 A.
RD.
010