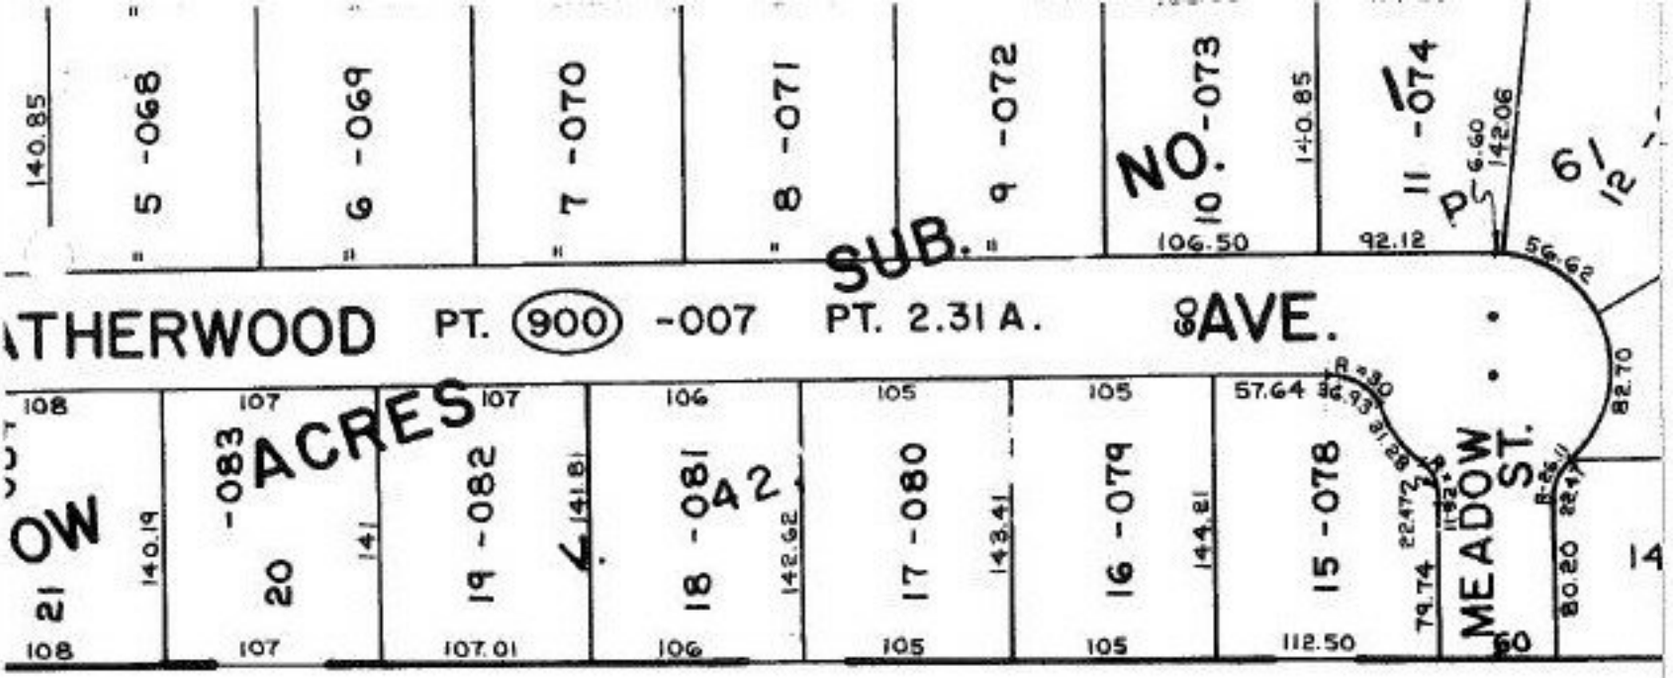

04-00-024-102- 04-00-024-900-
PRIOR INST: O.R.114/197

Pt - 107
~~Pt-006~~
Pt. ~~32.03 A.~~
29.27 A.

8/20/92
19956

APPROVED
LORAIN CO.
MAP DEPT.
DATE 6-15-92
PAGE 4-00024-0
BY CAROLYN FRANCIS
VOID AFTER # 19956