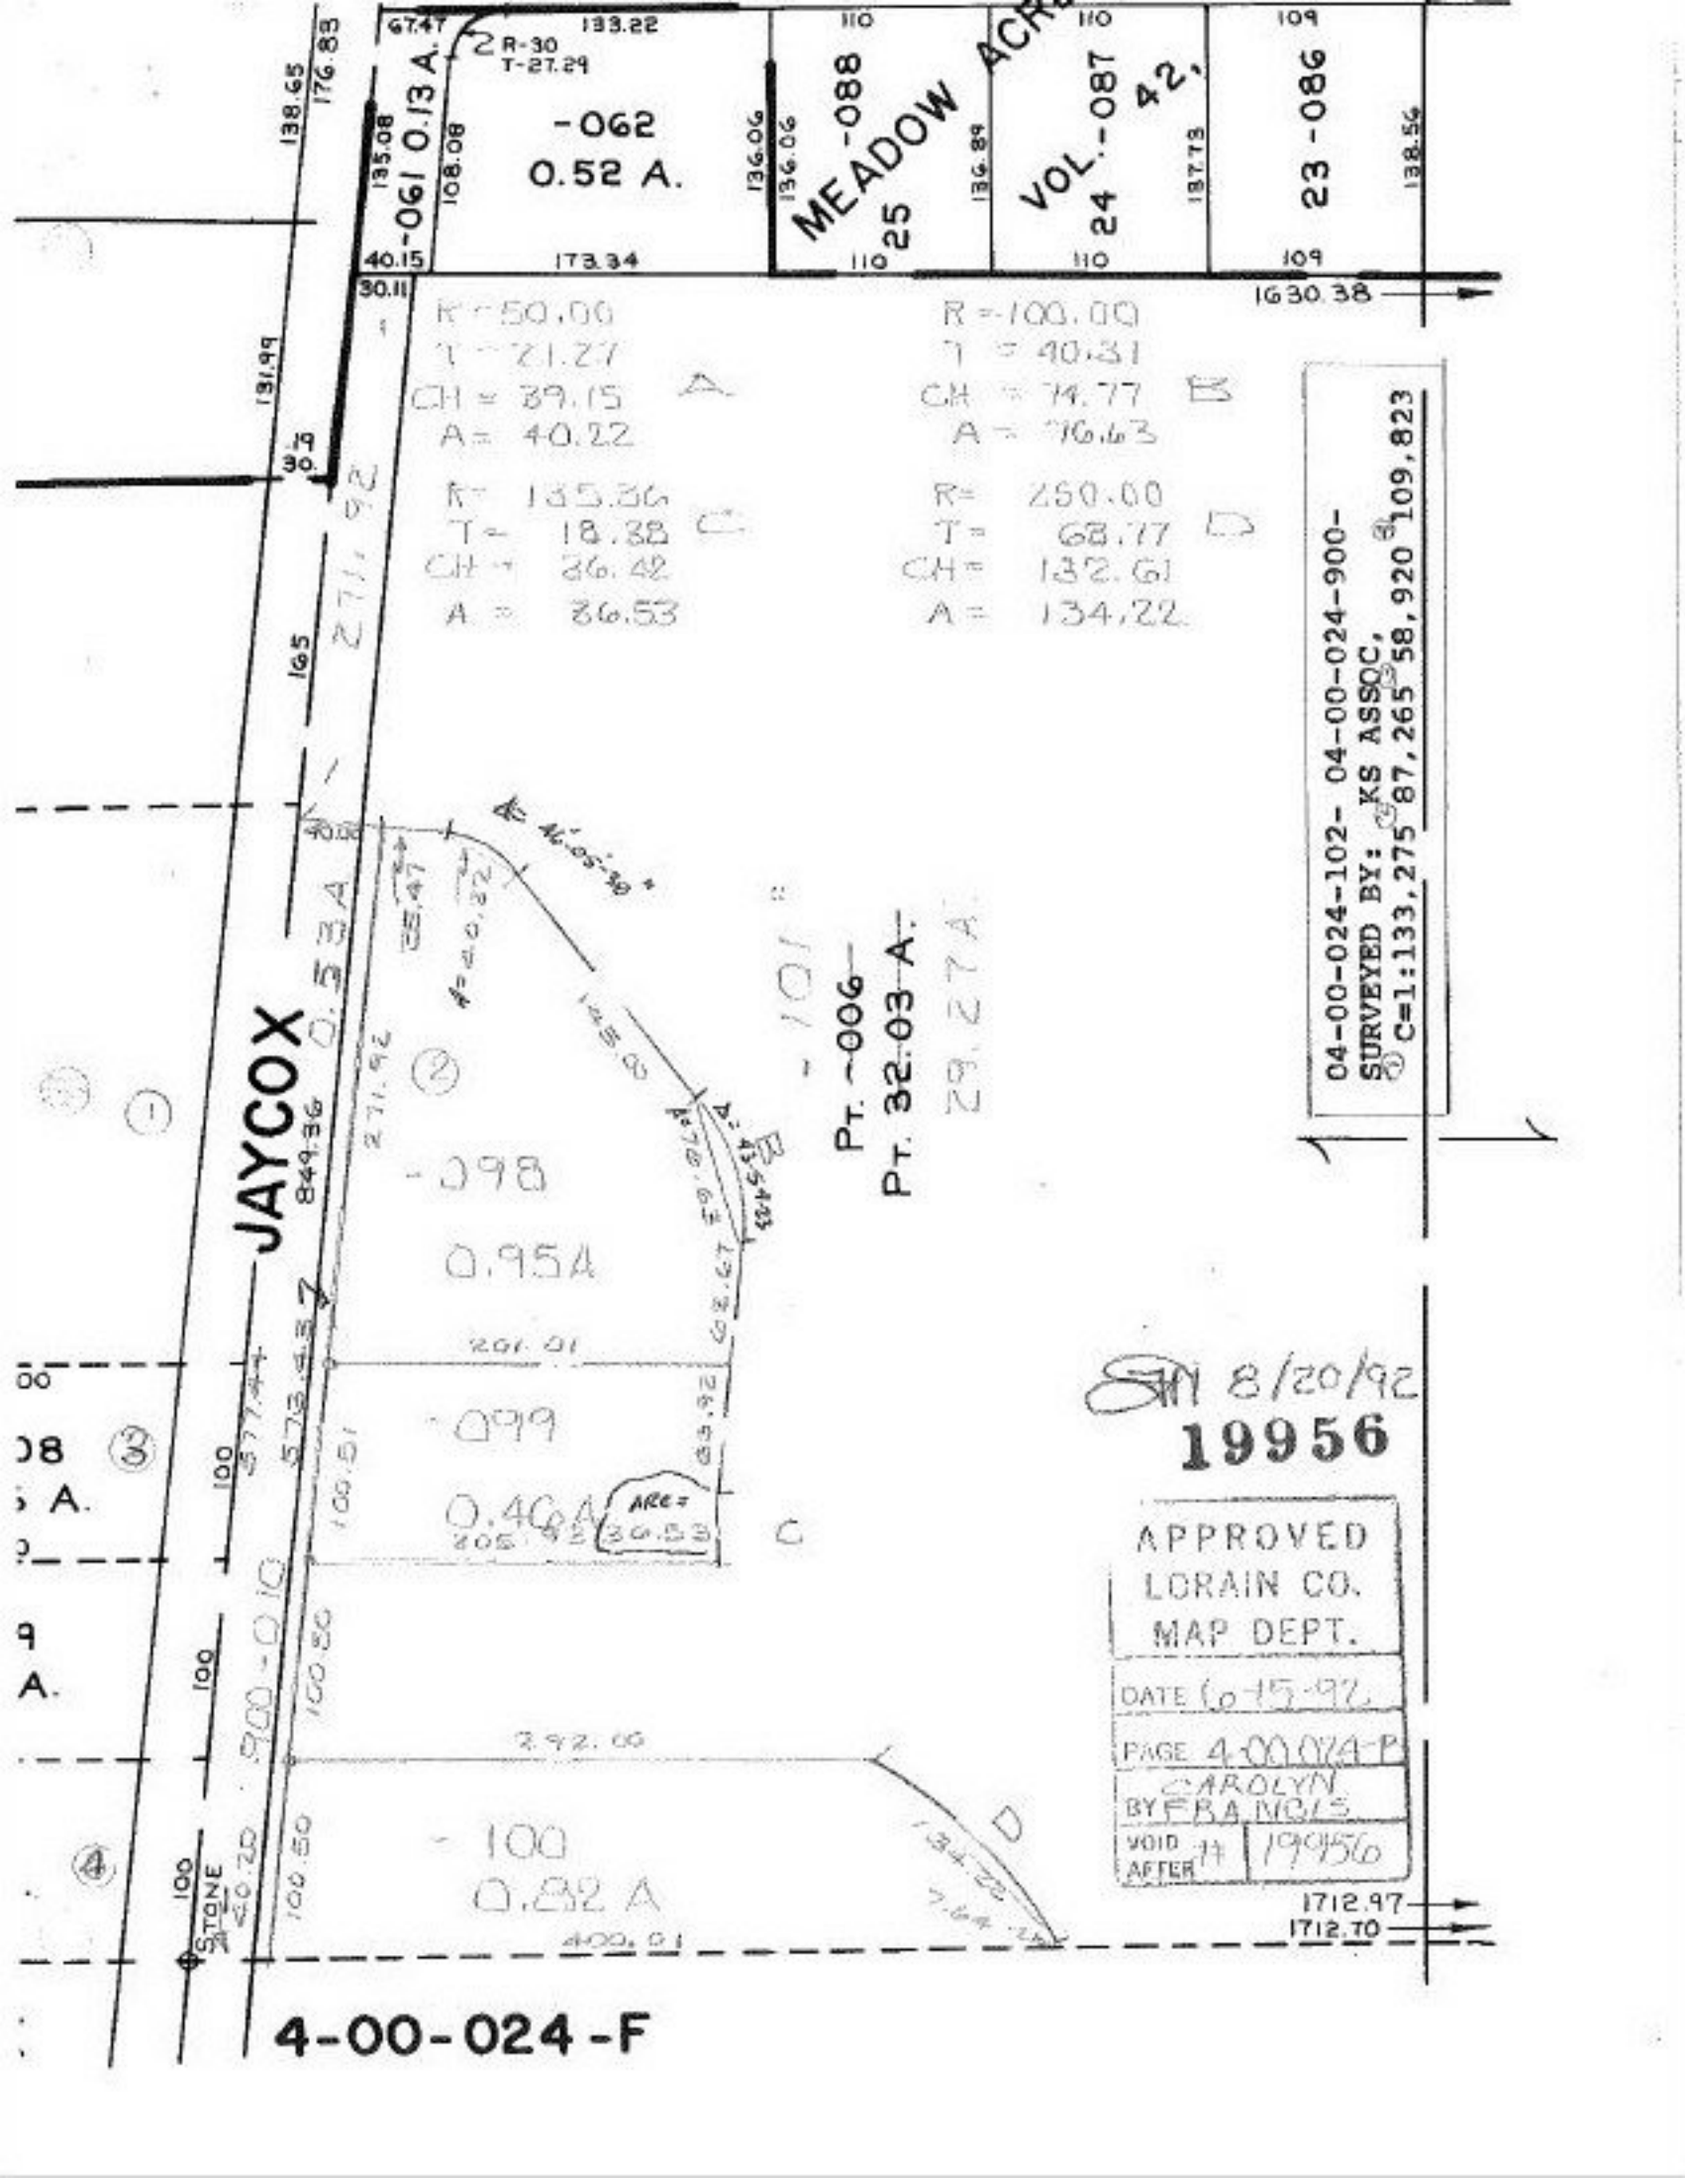
-062
0.52 A.
-061 0.13 A.
MEADOW ACRES
VOL. 42, PG. 25
-088
VOL. 24
-087
23-086
R-30
T-27.29
R=50.00
T=21.27
CH=39.15
A=40.22
A
R=100.00
T=40.31
CH=74.77
A=76.63
B
R=135.36
T=18.38
CH=36.42
A=36.53
C
R=250.00
T=68.77
CH=132.61
A=134.22
D
JAYCOX
-098
0.95A
-099
0.40A
-100
0.82A
-101
PT. -006-
PT. 32.03 A.
29.27 A.
04-00-024-102- 04-00-024-900-
SURVEYED BY: KS ASSOC,
C=1:133,275 87,265 58,920 109,823
APPROVED
LORAIN CO.
MAP DEPT.
DATE 6-15-92
PAGE 4-00-024-F
BY CAROLYN F BANGLS
VOID AFTER 11
19956
8/20/92
19956
4-00-024-F