P.O. NO. 001 &002 went into 005, 006, 007, 008, 009 010 011, 012, 013
003, 004 went into 014, 015, 016, 017, 018, 019
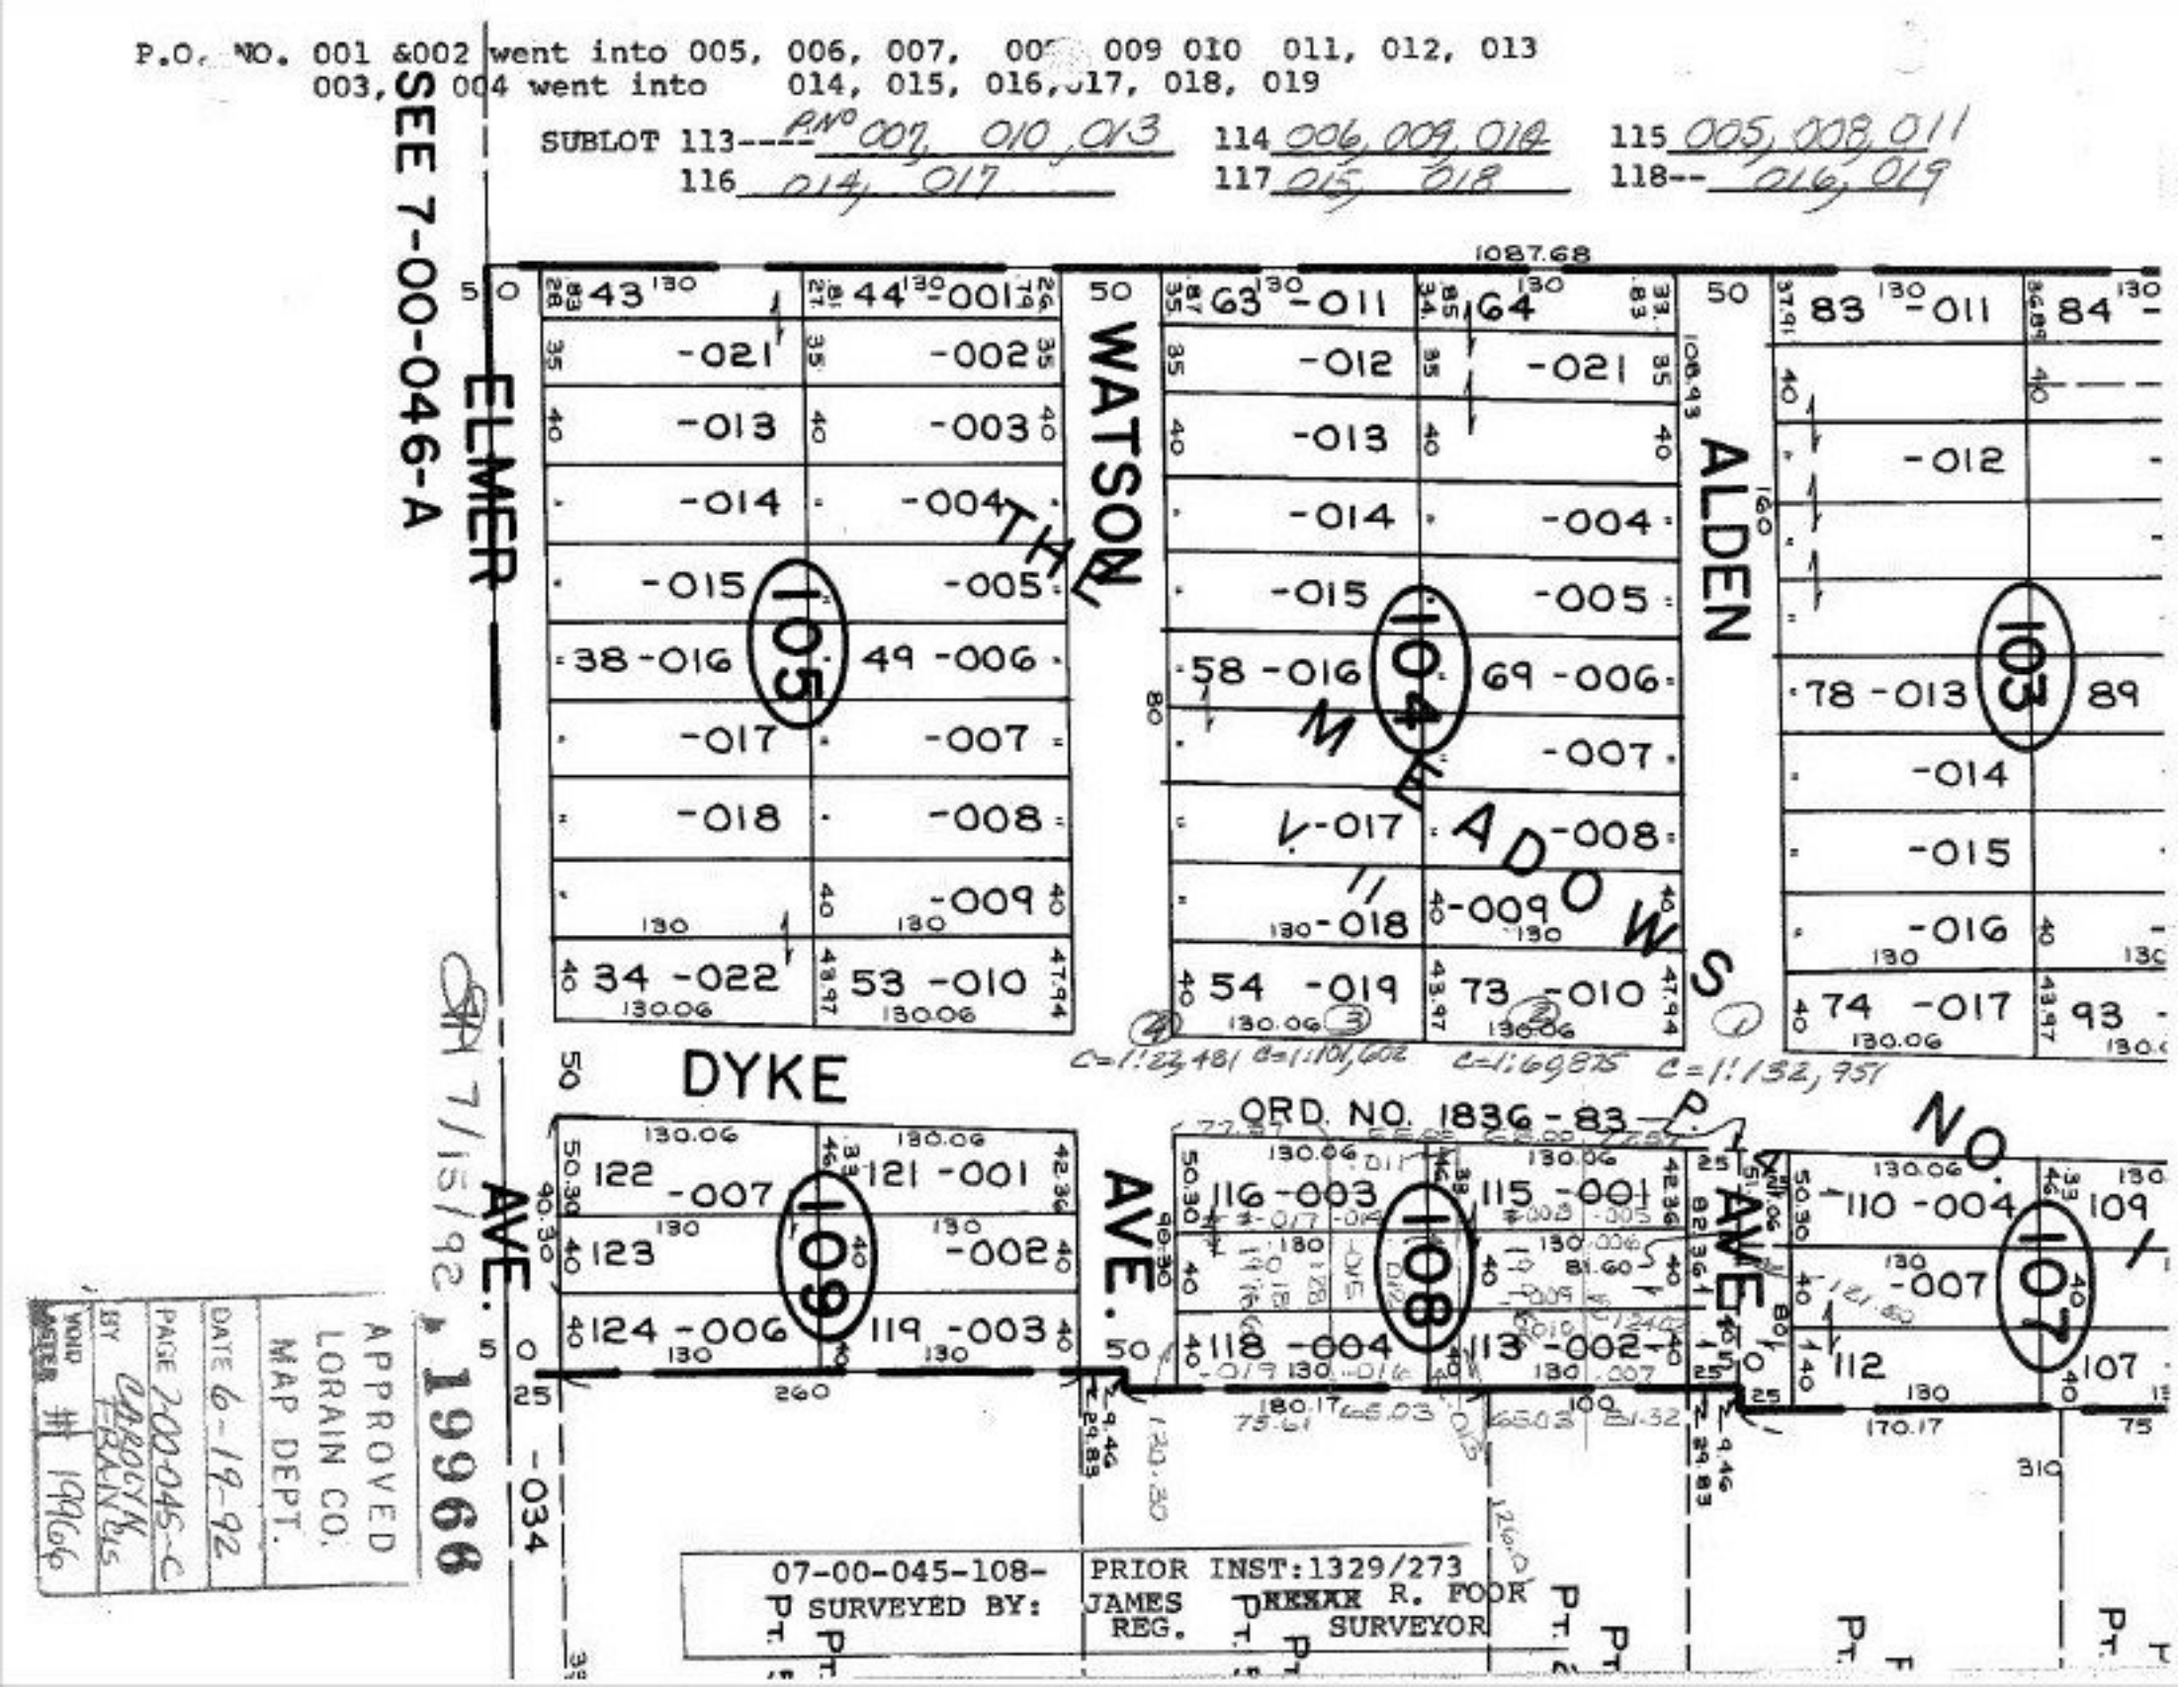
SUBLOT 113---P.N° 007, 010, 013 114 006, 009, 012 115 005, 008, 011
116 014, 017 117 015, 018 118-- 016, 019