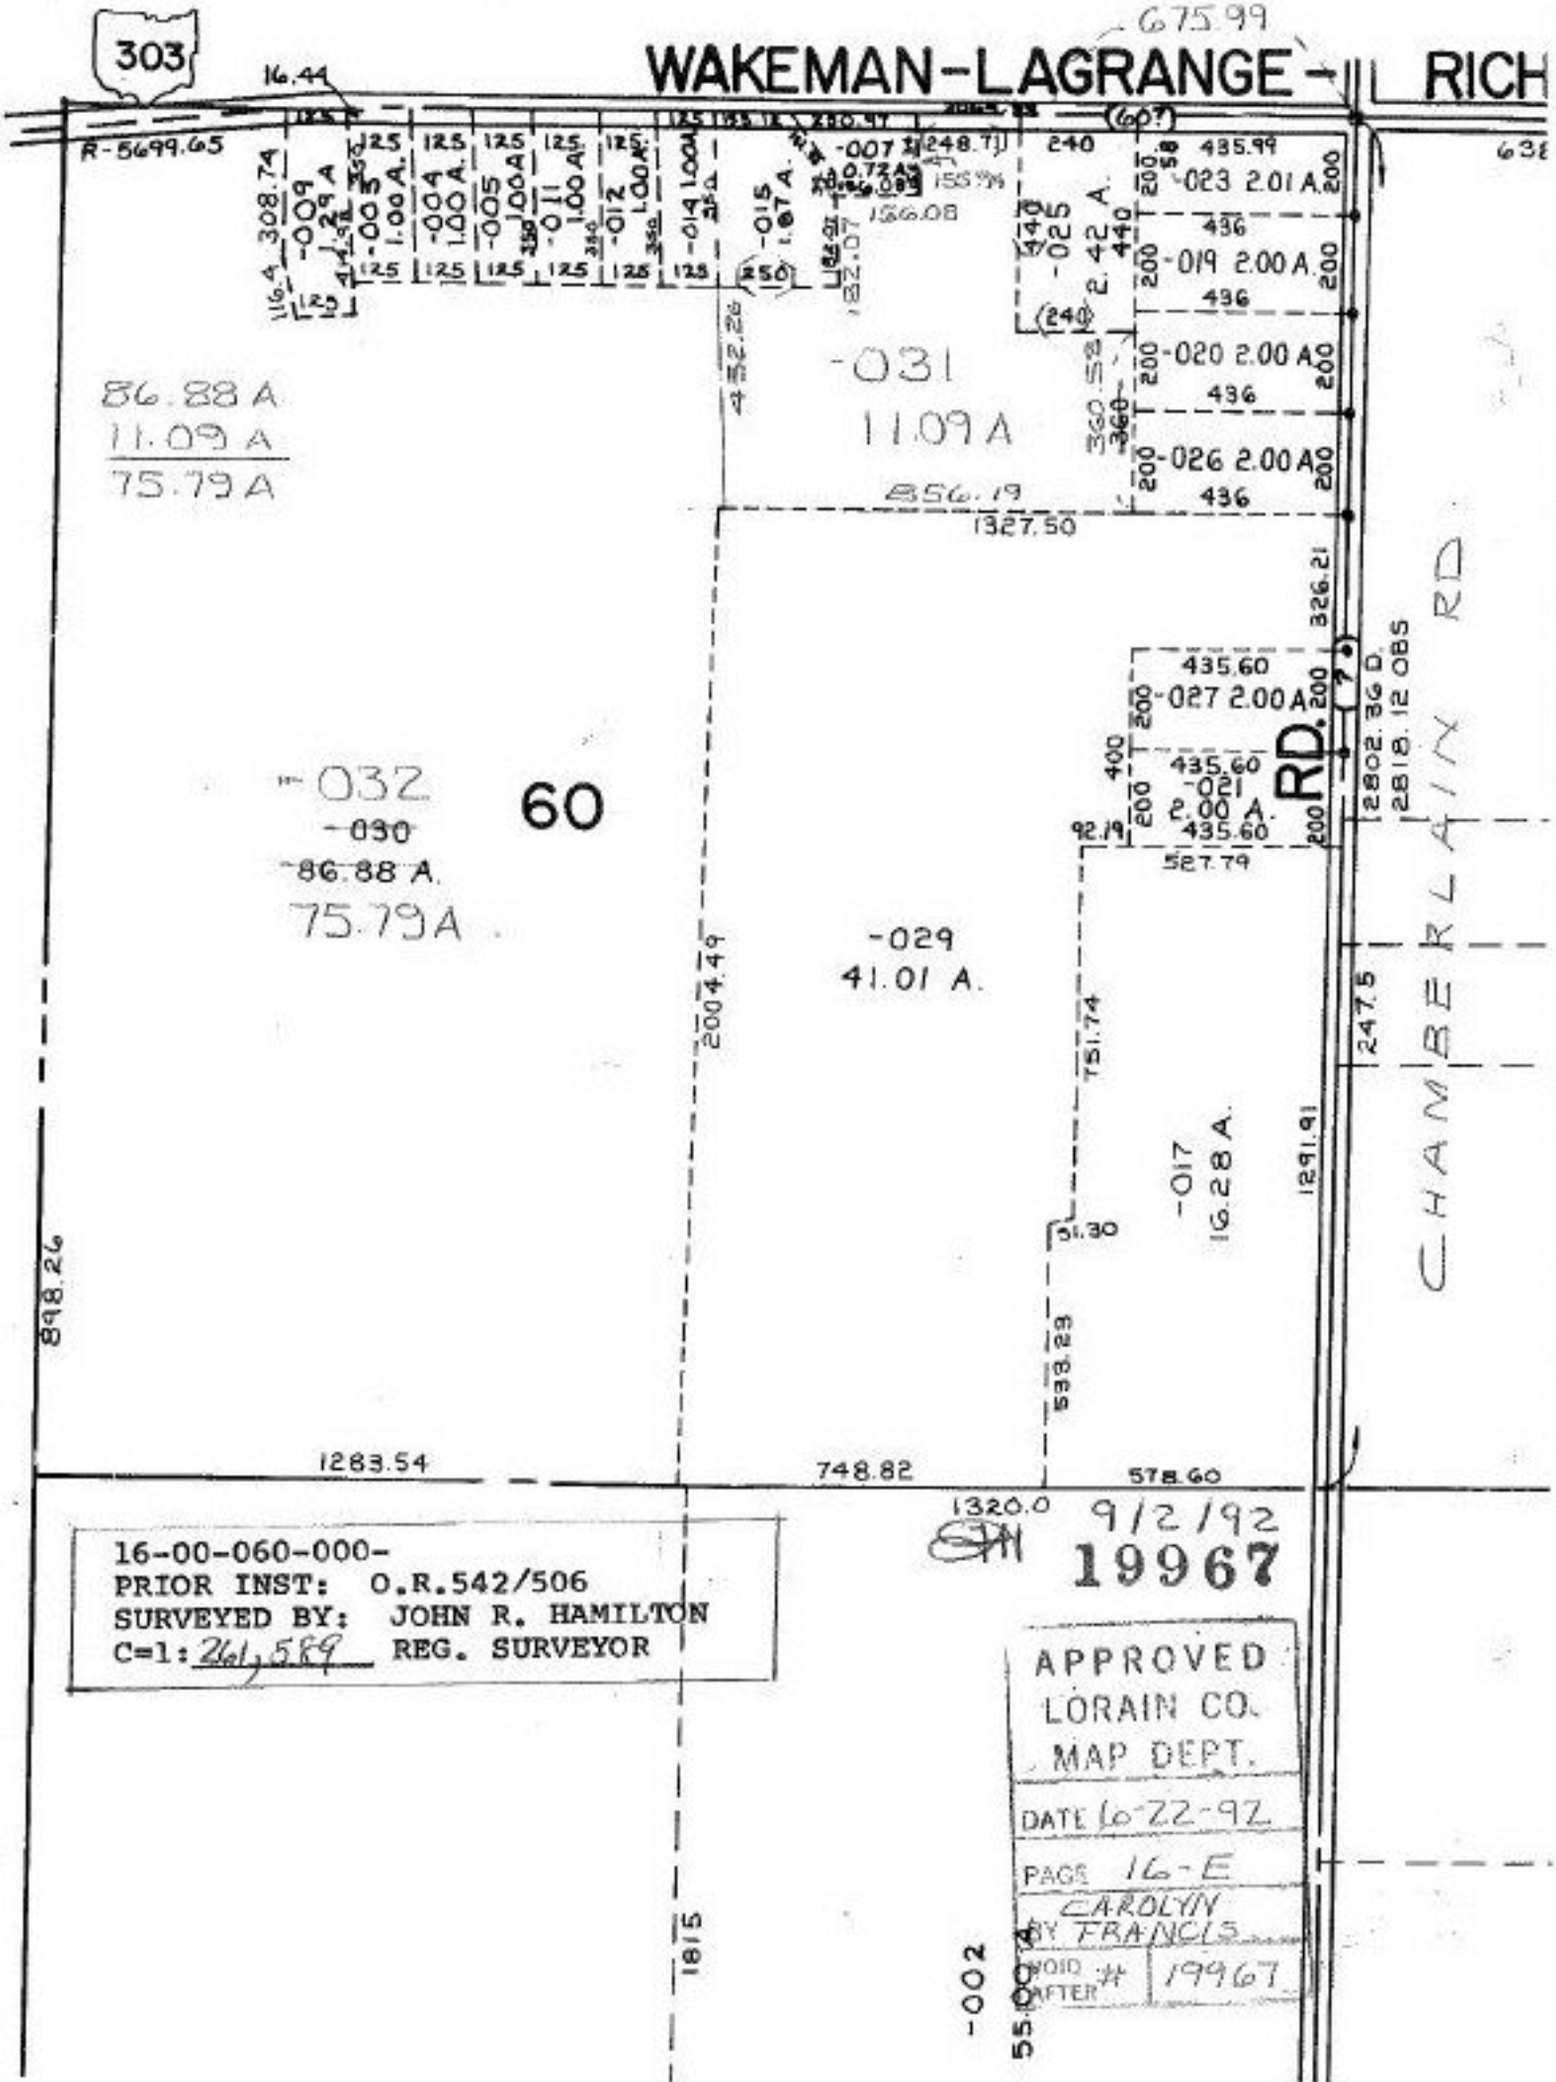
303
WAKEMAN-LAGRANGE
RICH
675.99
16.44
R-5699.65
60'
-009 1.29 A.
-003 1.00 A.
-004 1.00 A.
-005 1.00 A.
-011 1.00 A.
-012 1.00 A.
-014 1.00 A.
-015 1.67 A.
-007 0.72 A.
-025 2.42 A.
-023 2.01 A.
-019 2.00 A.
-020 2.00 A.
-026 2.00 A.
-027 2.00 A.
-021 2.00 A.
-031
11.09 A
86.88 A
11.09 A
75.79 A
-032
-030
86.88 A.
75.79 A
60
-029
41.01 A.
-017
16.28 A.
CHAMBERLAIN RD.
RD.
1327.50
856.19
2004.49
751.74
538.29
51.30
1291.91
247.5
898.26
1283.54
748.82
578.60
1320.0
1815
-002
55.00
16-00-060-000-
PRIOR INST: O.R.542/506
SURVEYED BY: JOHN R. HAMILTON
C=1: 261,589 REG. SURVEYOR
9/2/92
19967
APPROVED
LORAIN CO.
MAP DEPT.
DATE 6-22-92
PAGE 16-E
CAROLYN
BY FRANCIS
VOID AFTER # 19967