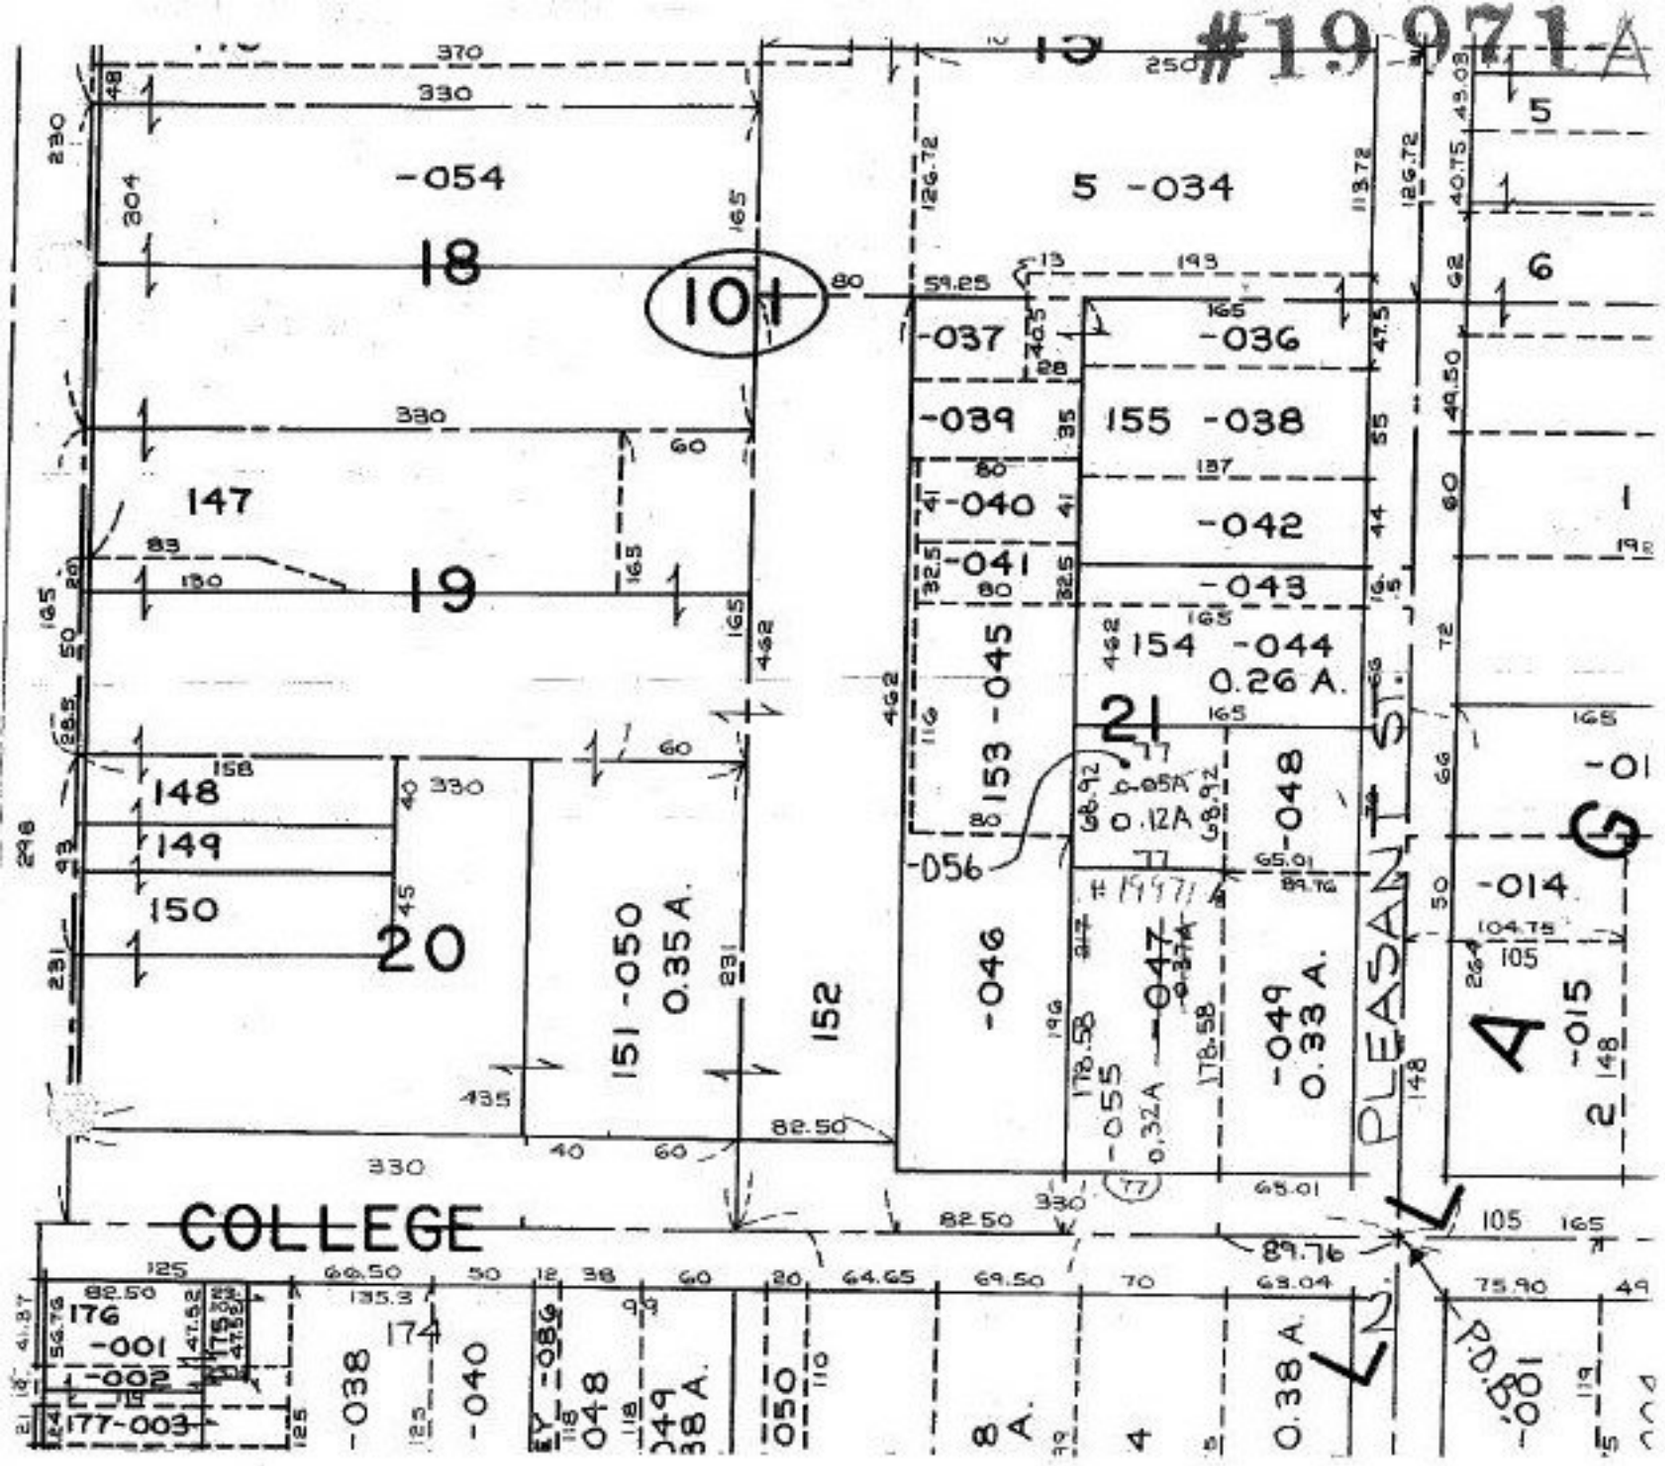

ORV 559, P. 798 DESCRIBES -055 CORRECTLY BUT WAS NOT PROCESSED AS A MINOR SUBDIVISION WHEN IT WAS RECORDED 6/25/82 IN ORV 559, P. 798

#19971-A

APPROVED
LORAIN CO.
MAP DEPT

DATE 6-12-97

PAGE 9-00-086-A

R. BELL

BY K. COLBERT

#19971-A