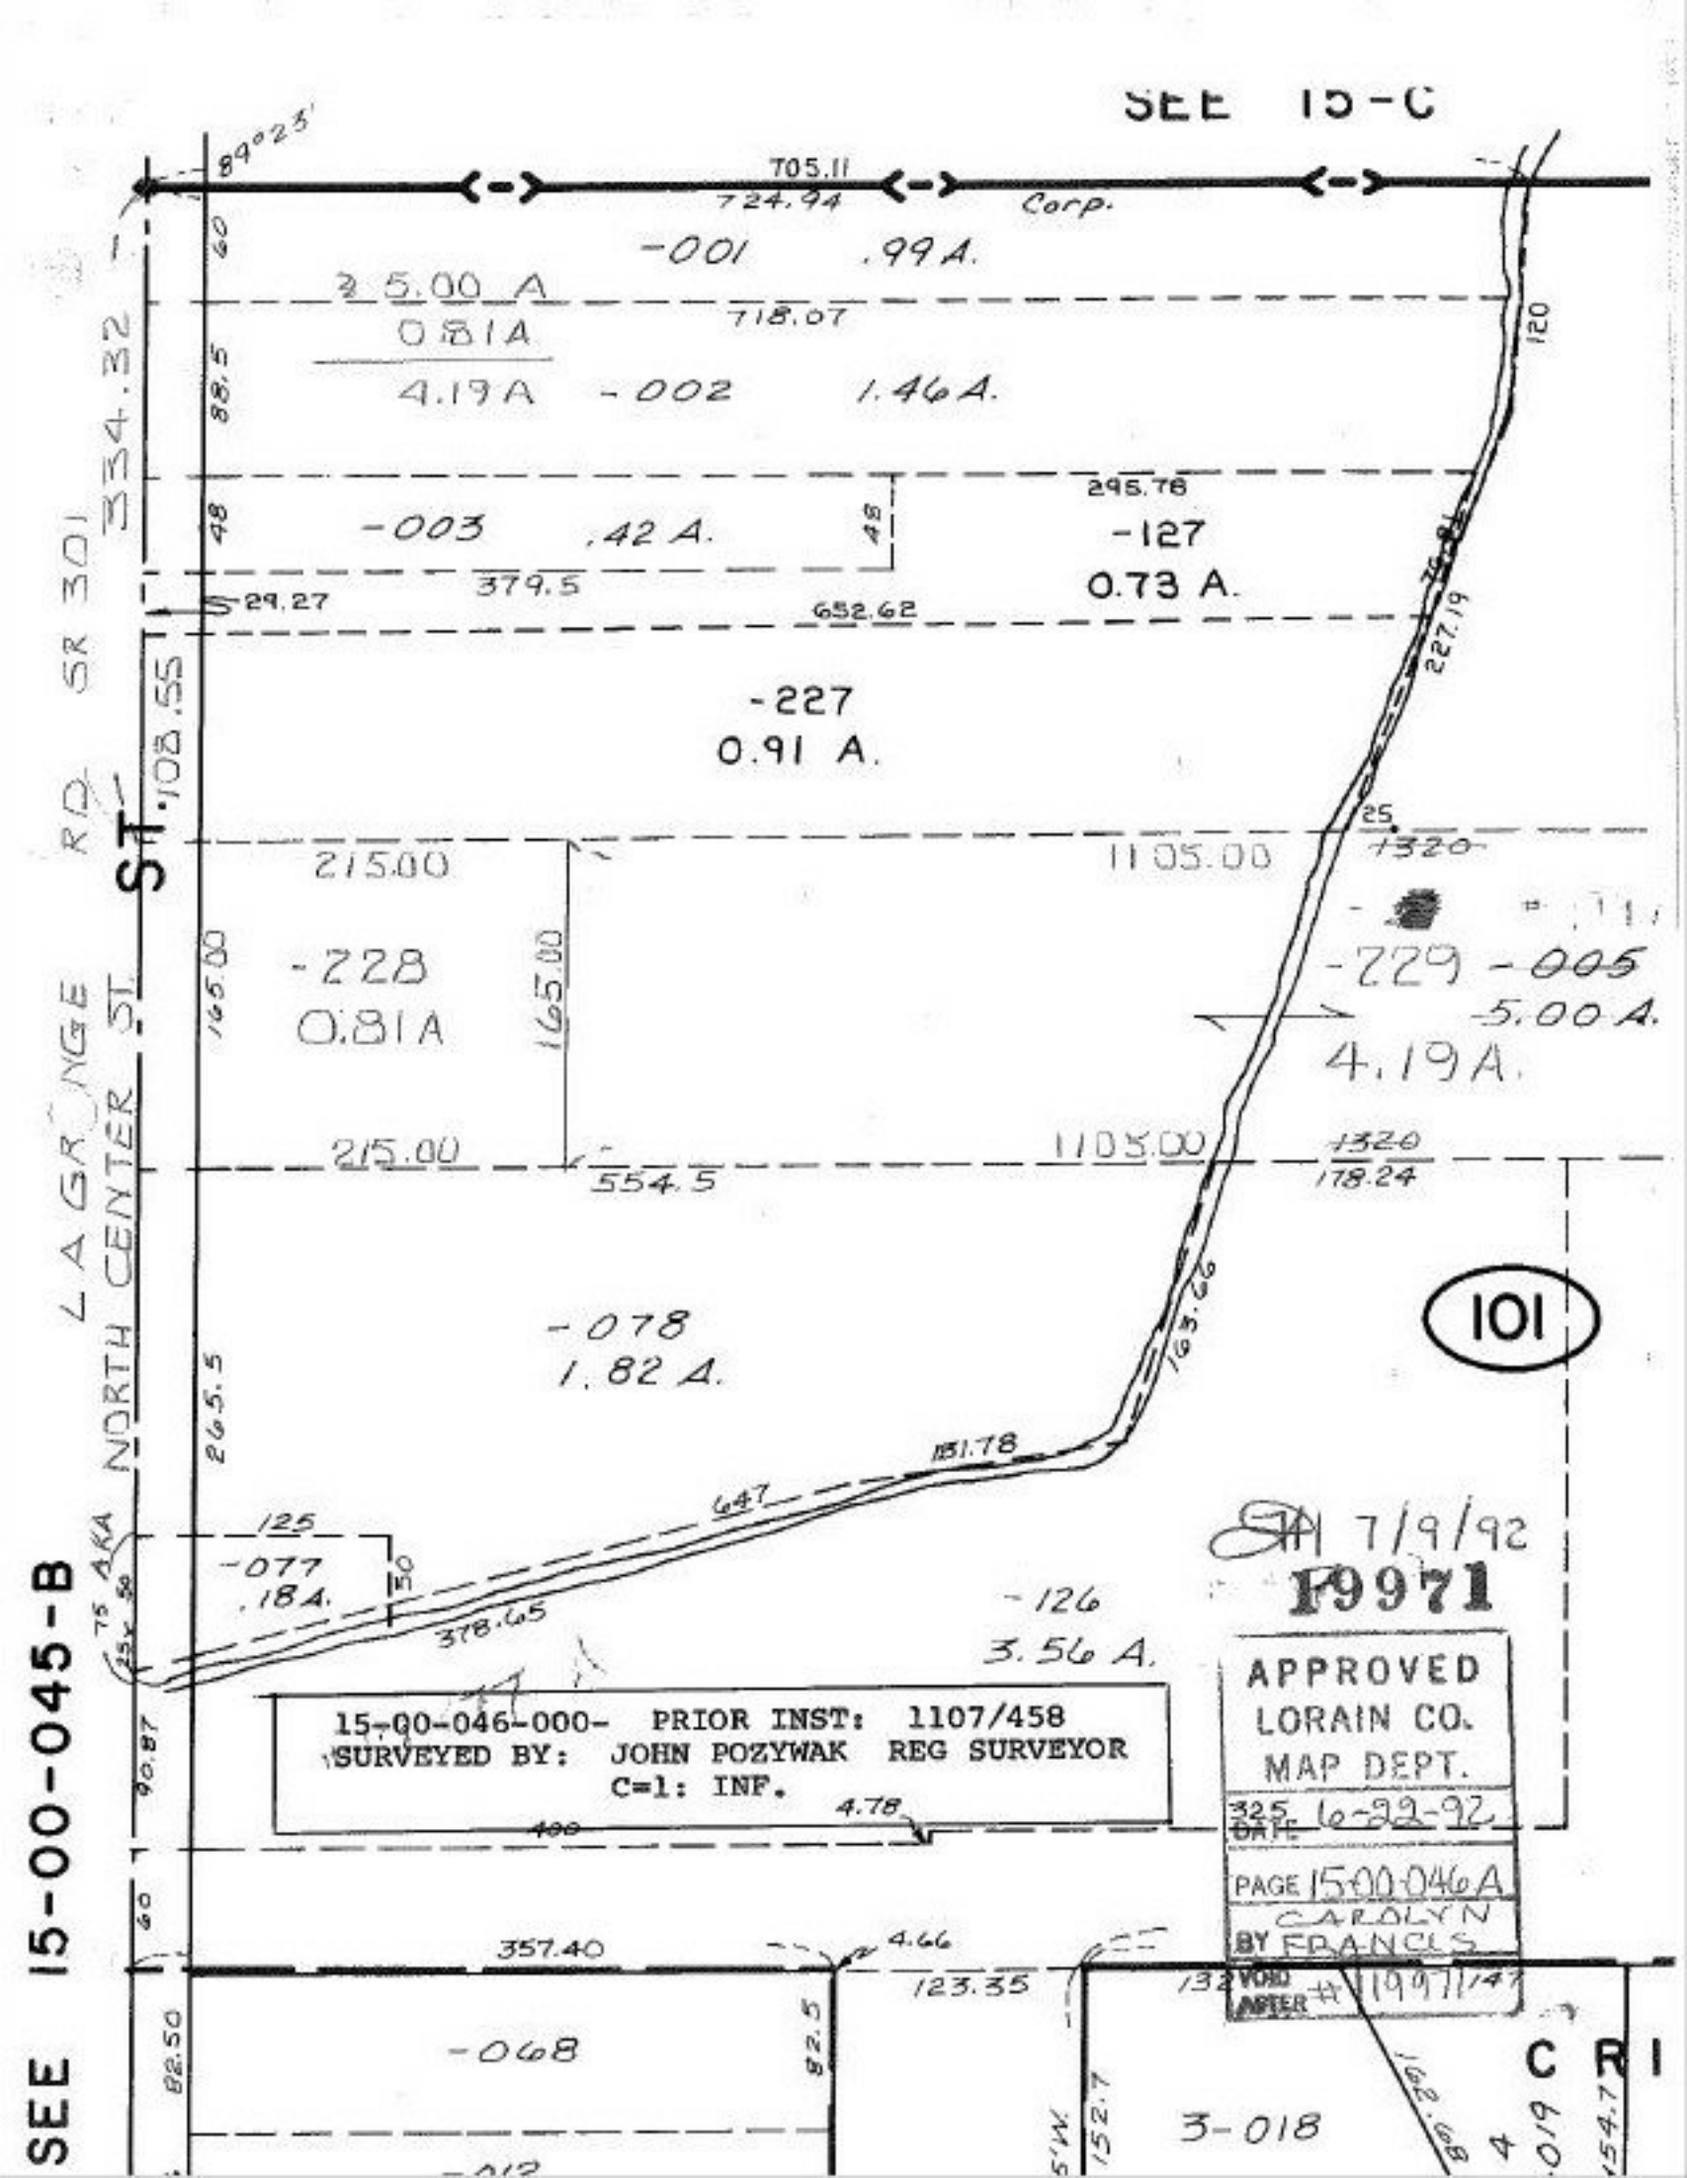
SEE 15-C
84°25'
705.11
724.94
Corp.
-001 .99A.
25.00 A
0.81A
718.07
4.19A -002 1.46A.
334.32
88.5
48
-003 .42A.
48
295.76
-127
0.73 A.
379.5
29.27
652.62
SR 301
LAGRANGE RD.
ST.
108.55
-227
0.91 A.
215.00
1105.00
1320
165.00
-228
0.81A
165.00
-229 -005
5.00A.
4.19A.
215.00
1105.00
1320
554.5
178.24
NORTH CENTER ST.
-078
1.82 A.
265.5
163.66
151.78
647
125
-077
.184.
50
75
AKA
23x50
378.65
-126
3.56 A.
90.87
15-00-046-000- PRIOR INST: 1107/458
SURVEYED BY: JOHN POZYWAK REG SURVEYOR
C=1: INF.
4.78
400
APPROVED
LORAIN CO.
MAP DEPT.
325 DATE 6-22-92
PAGE 15-00-046A
BY CAROLYN FRANCIS
VOID AFTER # 19971147
7/9/92
19971
101
60
357.40
4.66
123.35
132
SEE 15-00-045-B
82.50
82.5
-068
-012
152.7
3-018
162.68
154.7
C R I