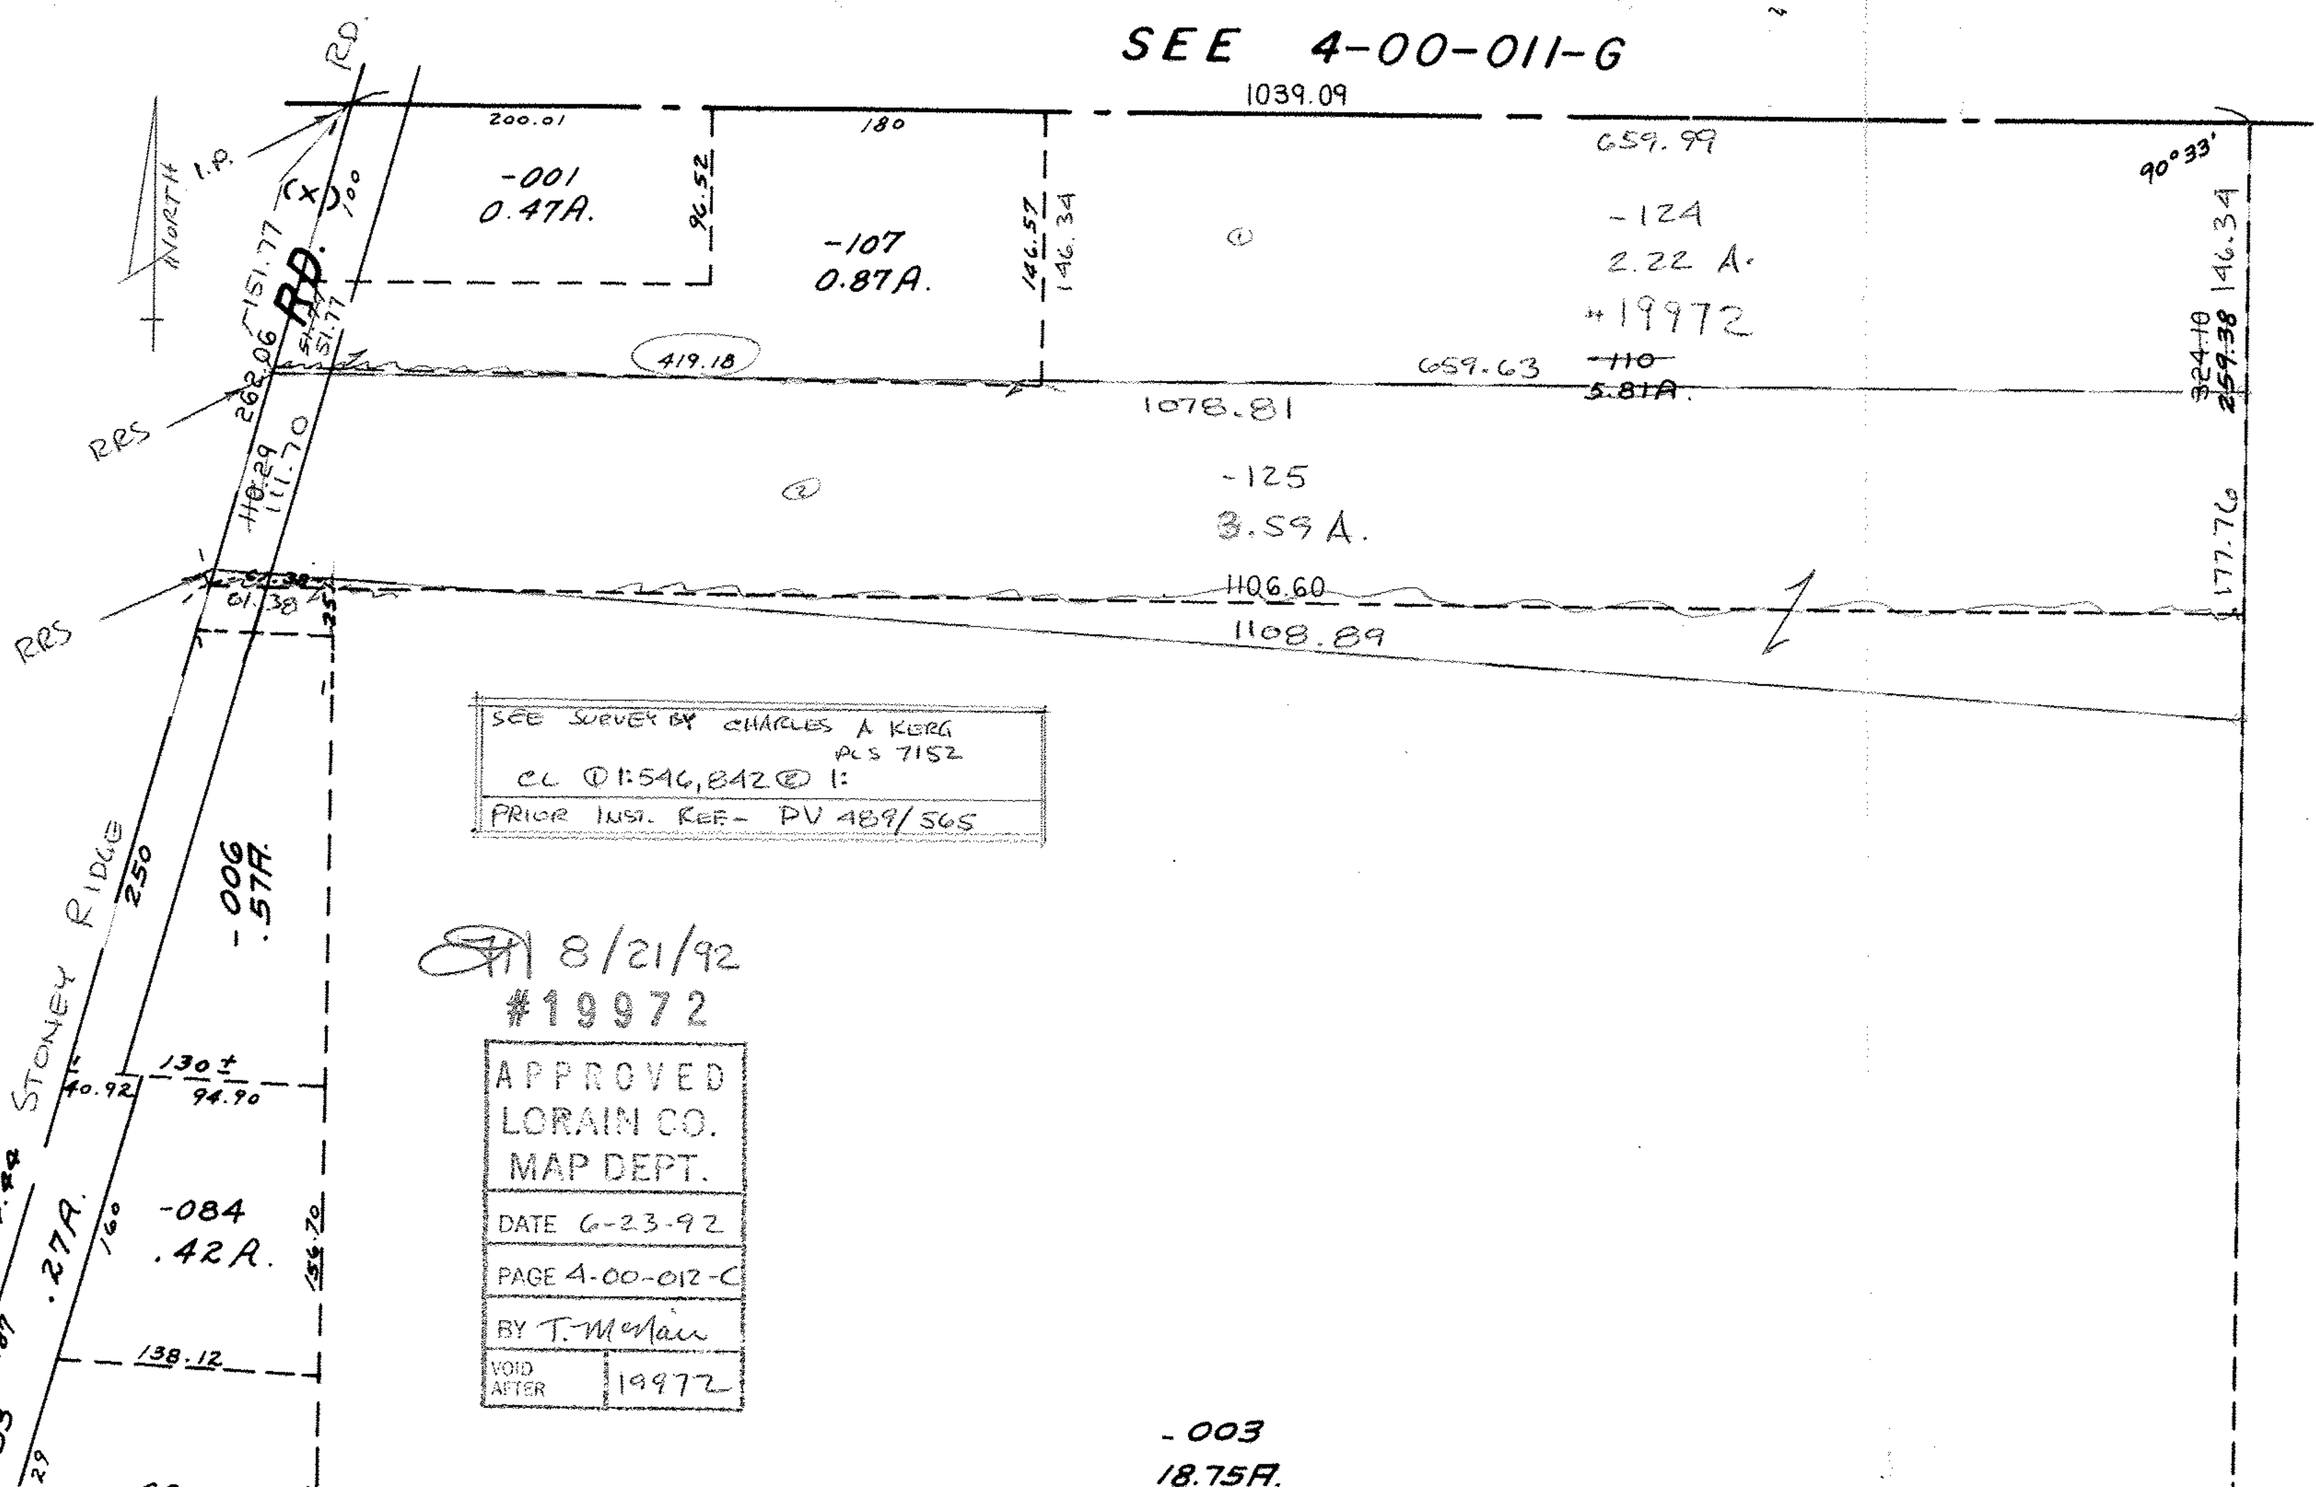
SEE 4-00-011-G
1039.09
200.01
180
659.99
90°33'
-001
0.47A.
96.52
-107
0.87A.
146.57
146.34
-124
2.22 A.
#19972
146.34
151.77
RD.
100
NORTH
I.P.
RD.
262.06
51.77
419.18
659.63
~~110~~
~~5.81A.~~
~~324.10~~
~~259.38~~
1078.81
RRS
110.29
111.70
-125
3.59 A.
177.76
RRS
61.38
25
1106.60
1108.89
SEE SURVEY BY CHARLES A KERG
PLS 7152
CL ① 1:546,842 ② 1:
PRIOR INST. REF- PV 489/565
STONEY RIDGE
250
-006
.57A.
8/21/92
#19972
APPROVED
LORAIN CO.
MAP DEPT.
DATE 6-23-92
PAGE 4-00-012-C
BY T. McNair
VOID AFTER 19972
130±
40.92
94.90
574.44
.27A.
160
-084
.42A.
156.70
298.87
138.12
-083
29
-003
18.75A.