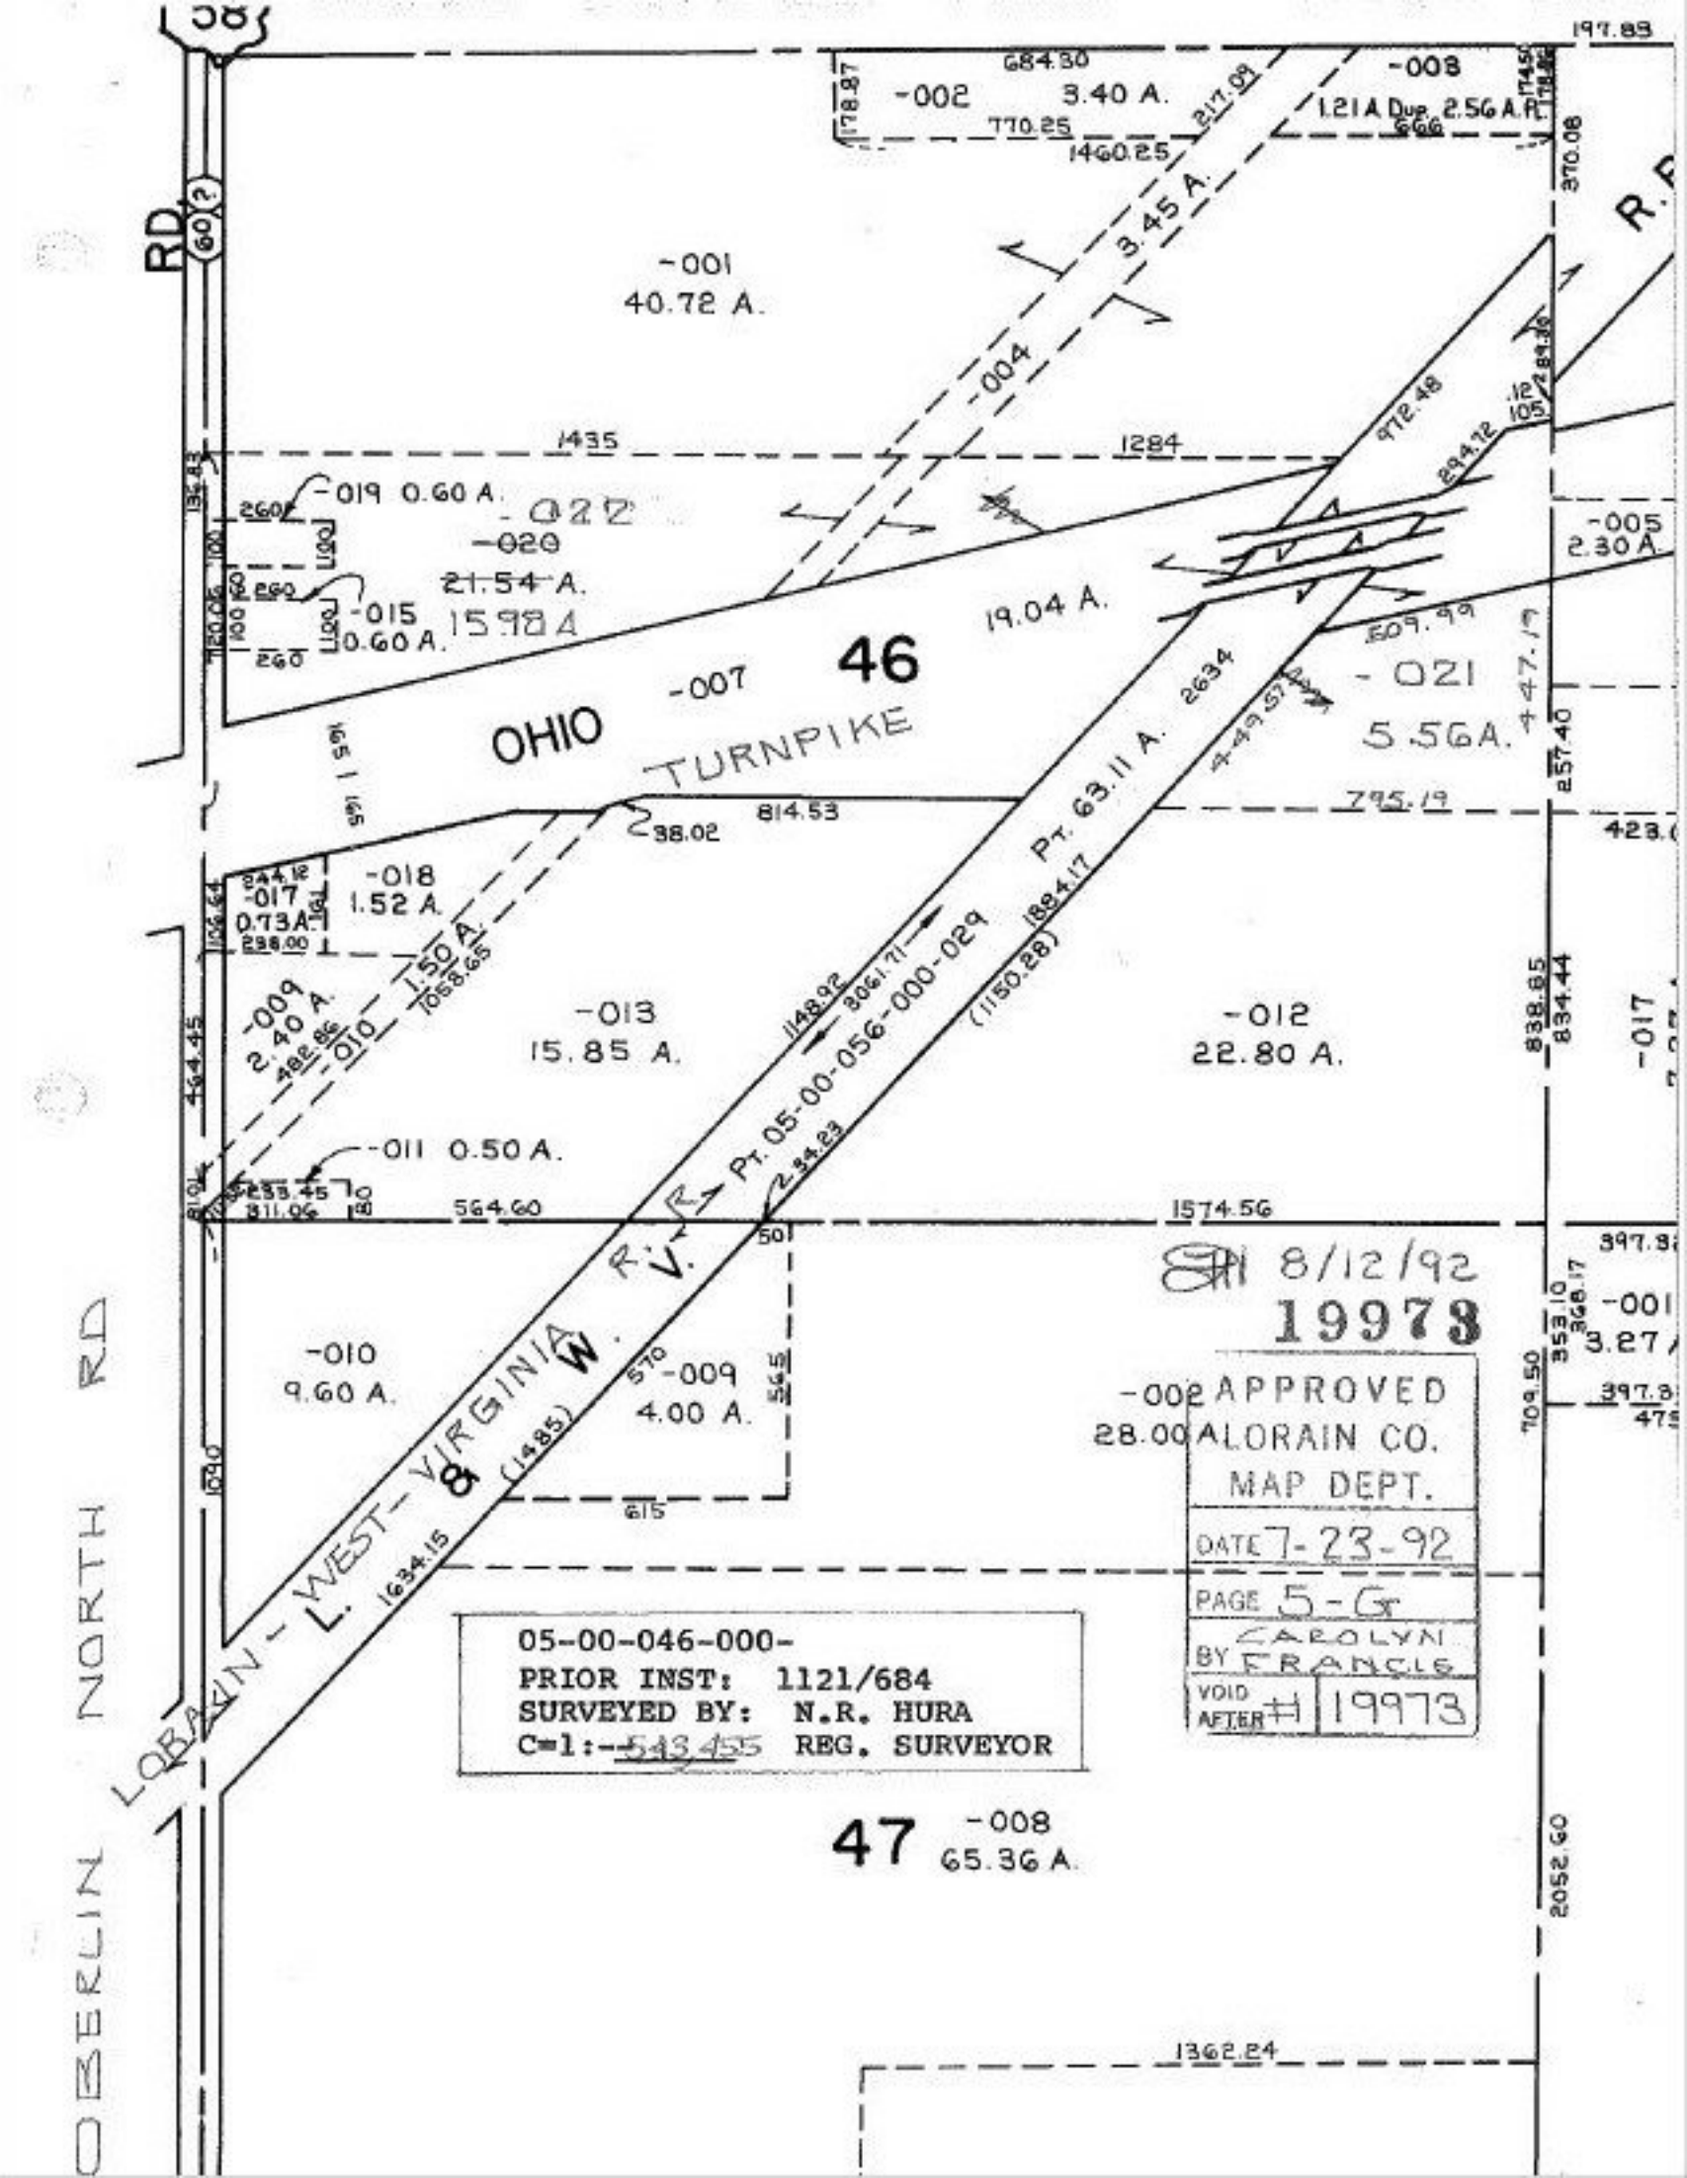
58
RD.
(60')
-001
40.72 A.
-002
3.40 A.
-008
1.21 A Dup 2.56 A.
3.45 A.
-004
-019 0.60 A.
-020
21.54 A.
-015
0.60 A.
15984
-022
46
OHIO
TURNPIKE
-007
19.04 A.
-005
2.30 A.
-021
5.56 A.
-018
1.52 A.
-017
0.73 A.
-009
2.40 A.
-010
1.50 A.
-013
15.85 A.
-012
22.80 A.
-011 0.50 A.
Pt. 63.11 A.
Pt. 05-00-056-000-029
L. WEST VIRGINIA & R.R.
-010
9.60 A.
-009
4.00 A.
-008
28.00
-001
3.27 A.
47
-008
65.36 A.
8/12/92
19973
APPROVED
LORAIN CO.
MAP DEPT.
DATE 7-23-92
PAGE 5-G
BY CAROLYN FRANCIS
VOID AFTER # 19973
05-00-046-000-
PRIOR INST: 1121/684
SURVEYED BY: N.R. HURA
C=1:-543455 REG. SURVEYOR