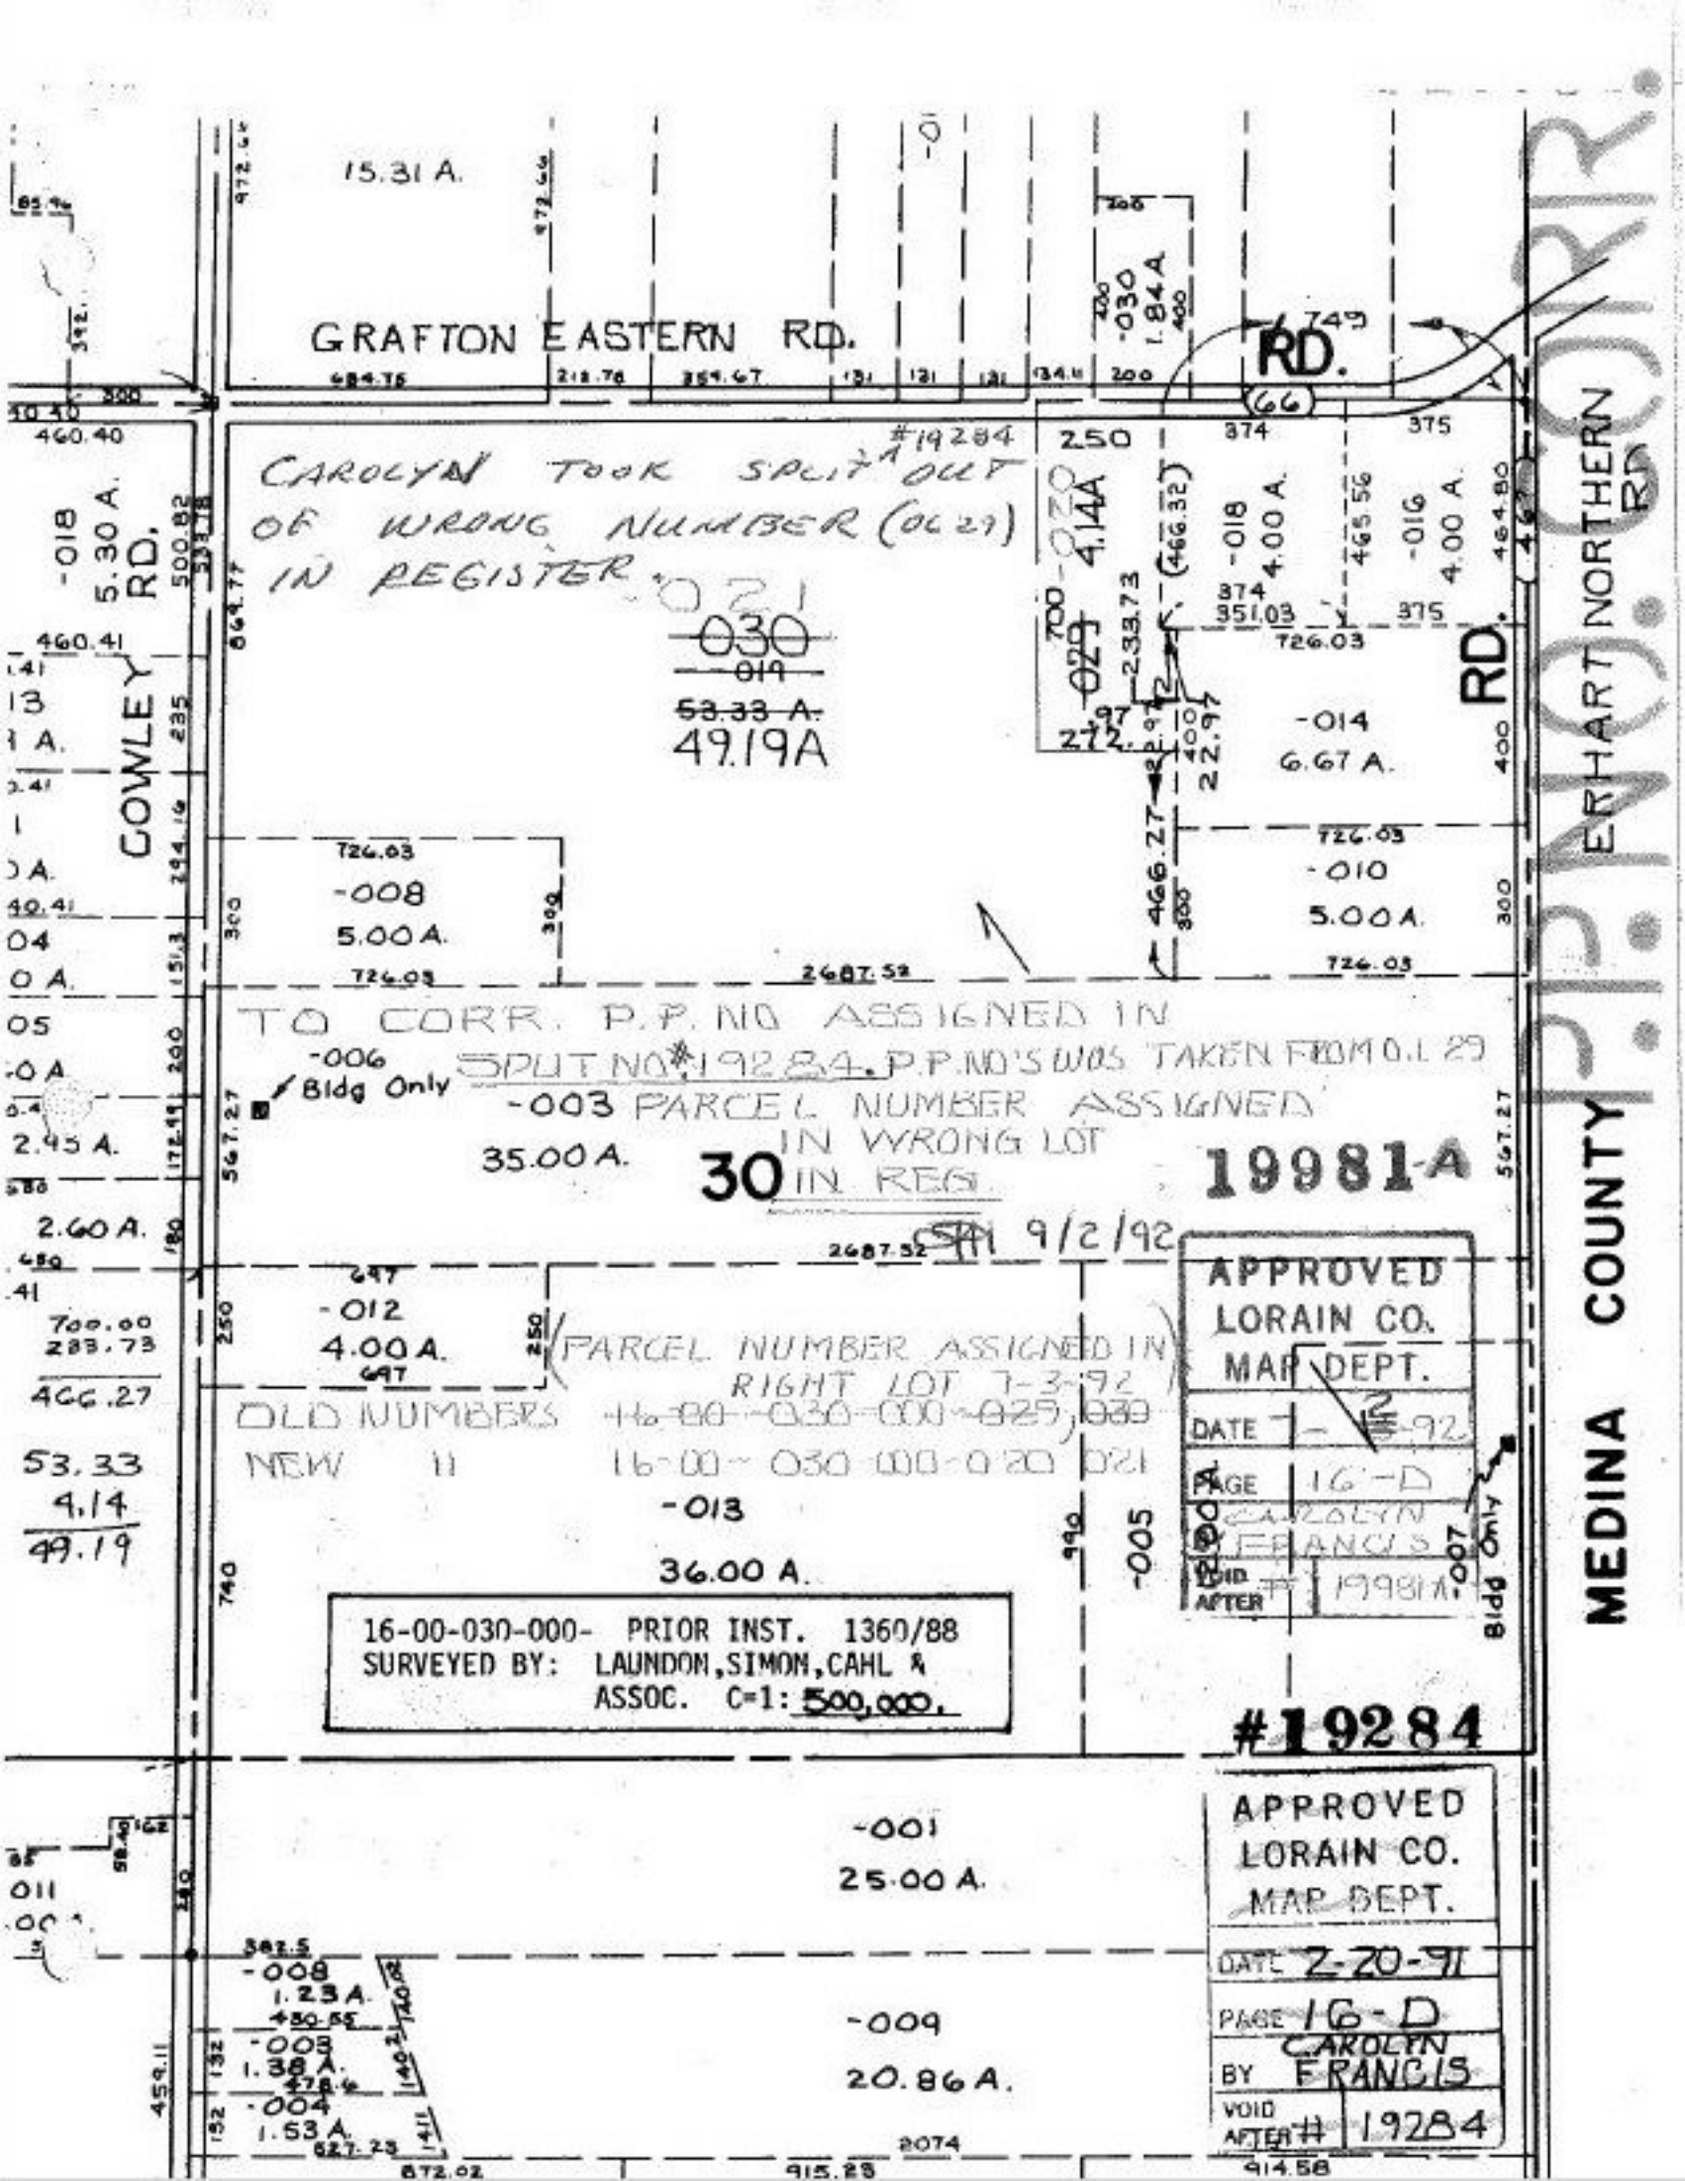

GRAFTON EASTERN RD.
RD.
COWLEY RD.
ERHART NORTHERN RD.
MEDINA COUNTY
P.P. NO. CORR.
15.31 A.
CAROLYN TOOK SPLIT #19284 OUT OF WRONG NUMBER (OL 29) IN REGISTER.
021
~~030~~
~~019~~
~~53.33 A.~~
49.19A
-018 5.30 A.
-030 1.84 A
-020 4.14A
-018 4.00 A.
-016 4.00 A.
-014 6.67 A.
-010 5.00 A.
-008 5.00 A.
TO CORR. P.P. NO ASSIGNED IN SPLIT NO #19284. P.P. NO'S WAS TAKEN FROM O.L 29
-006 Bldg Only
-003 PARCEL NUMBER ASSIGNED IN WRONG LOT IN REG.
35.00 A.
30
19981-A
9/2/92
-012 4.00 A.
PARCEL NUMBER ASSIGNED IN RIGHT LOT 7-3-92
OLD NUMBERS ~~16-00-030-000-029, 030~~
NEW " 16-00-030-000-020 021
-013
36.00 A.
16-00-030-000- PRIOR INST. 1360/88
SURVEYED BY: LAUNDON, SIMON, CAHL & ASSOC. C=1: 500,000.
APPROVED LORAIN CO. MAP DEPT.
DATE 7-15-92
PAGE 16-D
BY CAROLYN FRANCIS
VOID AFTER # 19981A
#19284
-001
25.00 A.
-008 1.23 A.
-003 1.38 A.
-004 1.53 A.
-009
20.86 A.
APPROVED LORAIN CO. MAP DEPT.
DATE 2-20-91
PAGE 16-D
BY CAROLYN FRANCIS
VOID AFTER # 19284