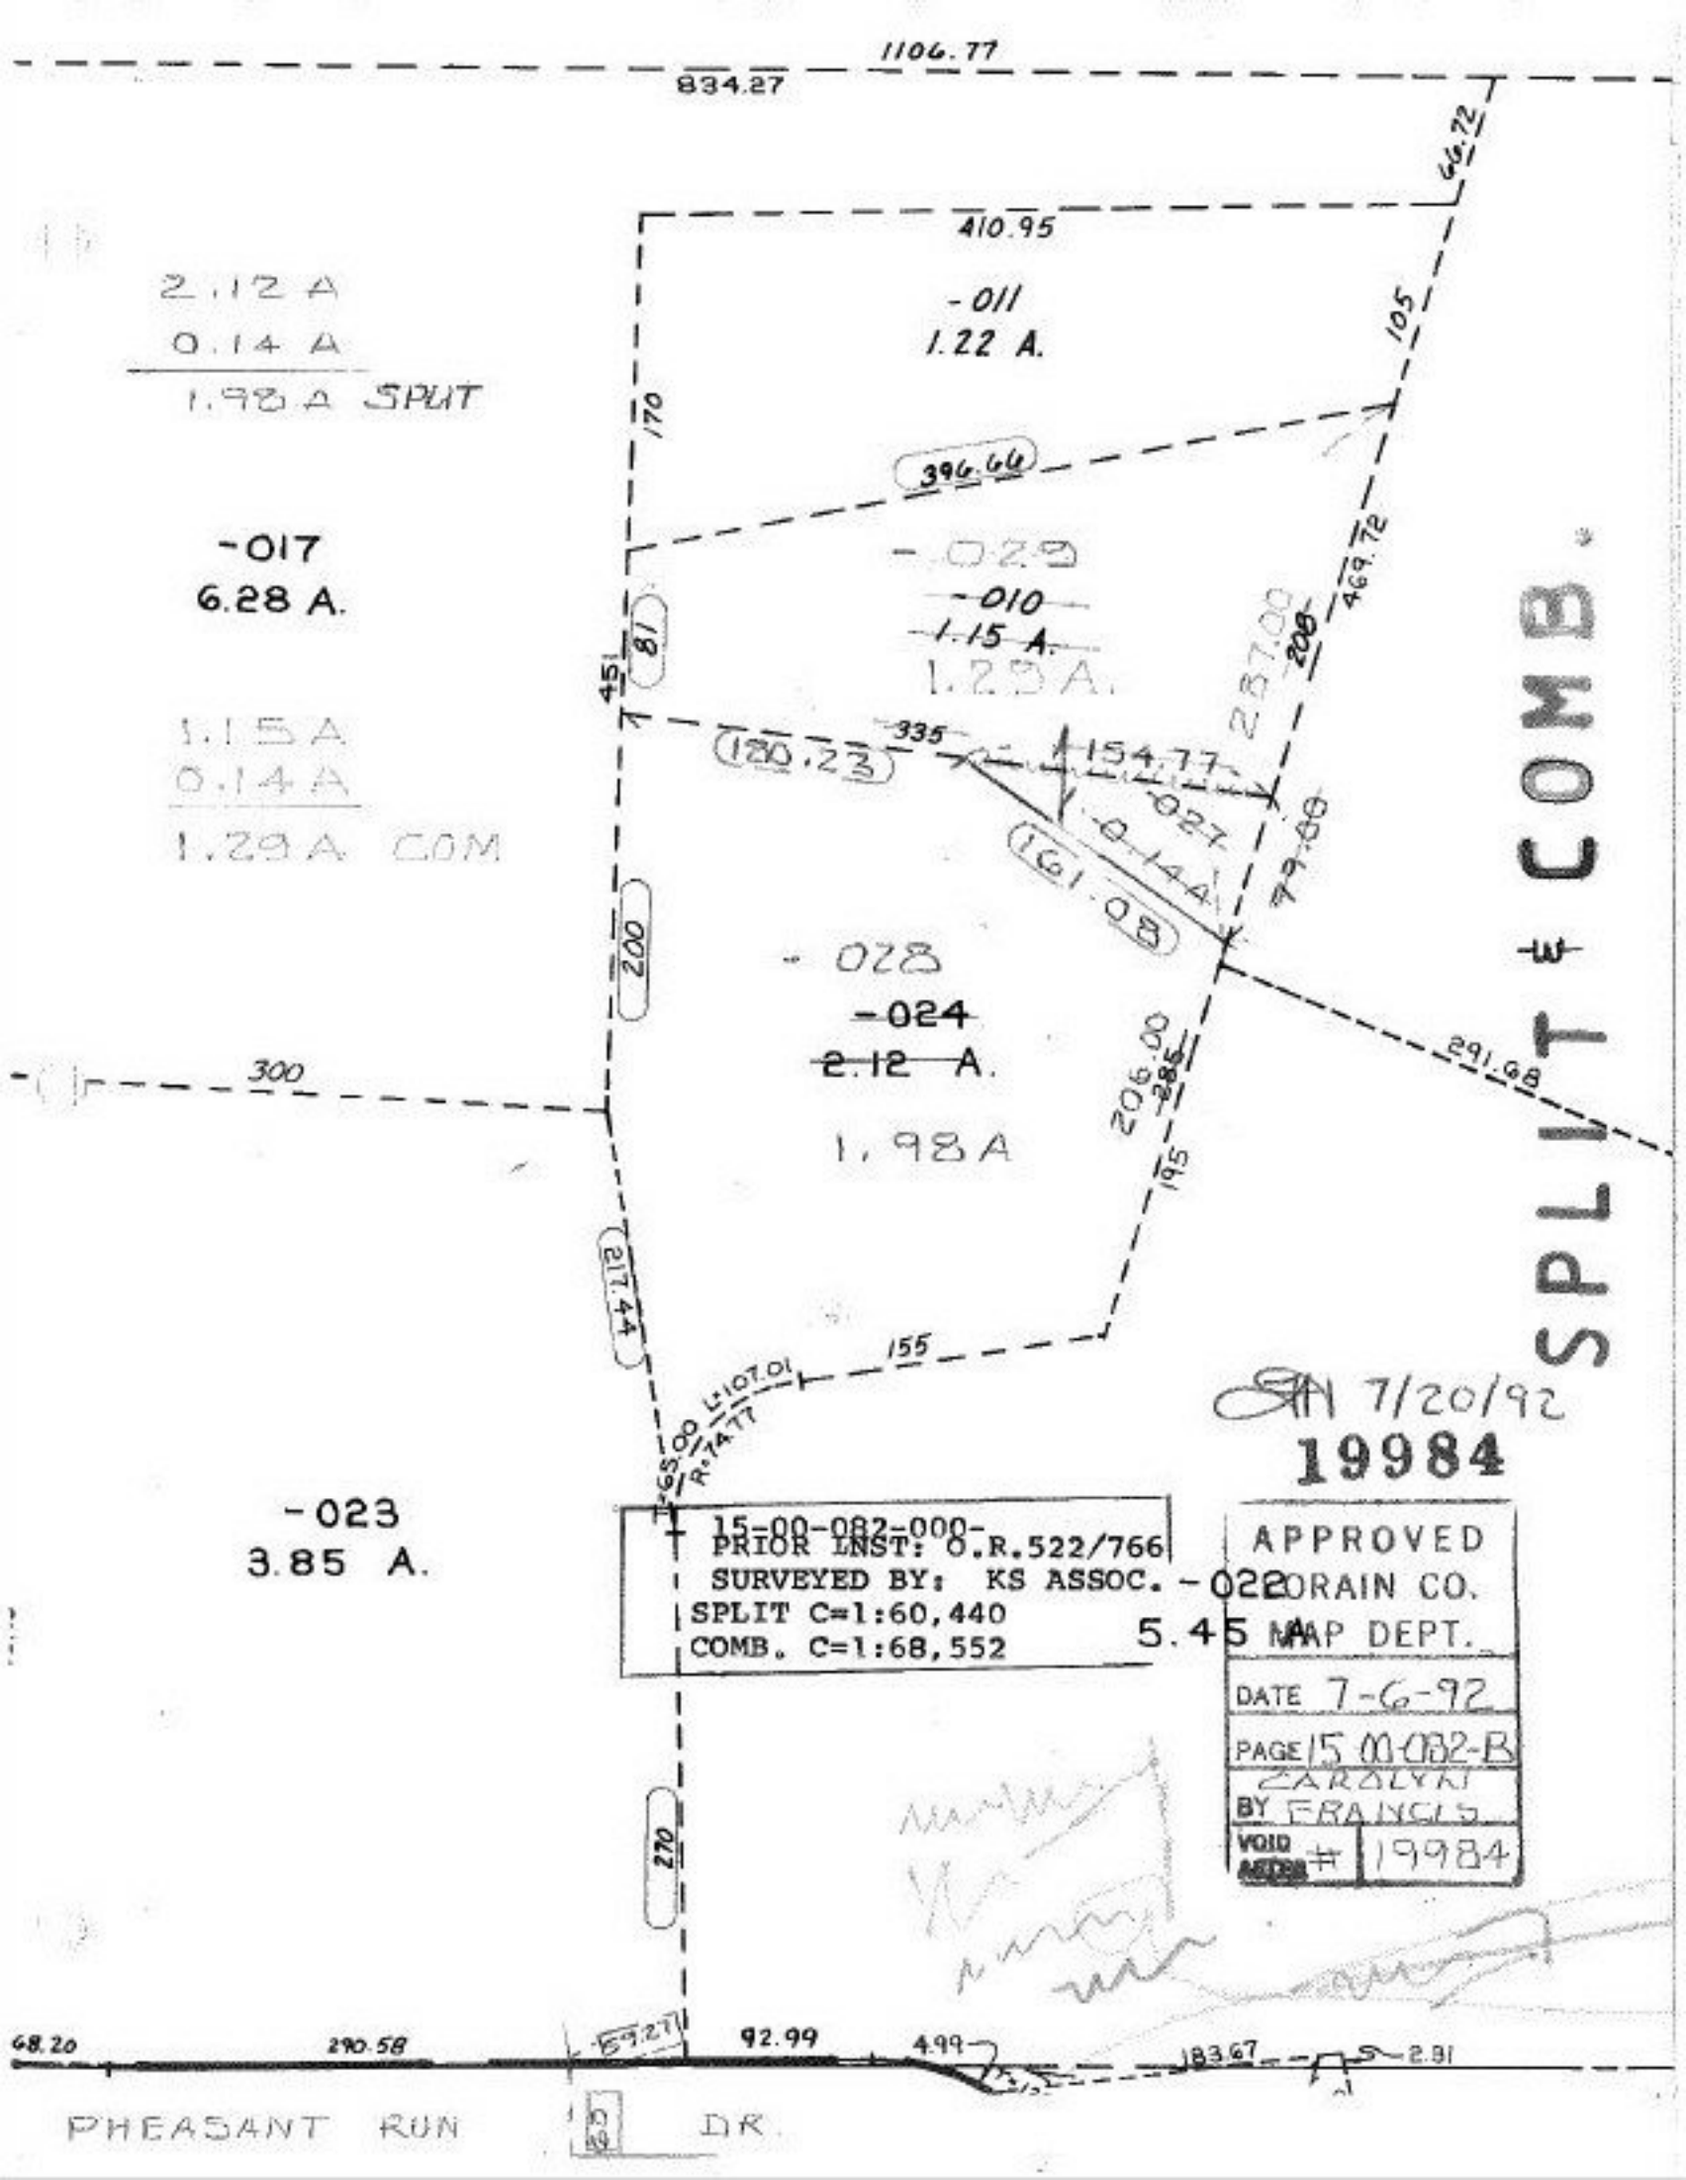
1106.77
834.27
66.72
410.95
2.12 A
0.14 A
1.98 A SPLIT
-011
1.22 A.
105
170
396.66
-017
6.28 A.
-029
-010
1.15 A.
1.29 A.
469.72
287.00
208
81
451
1.15 A
0.14 A
1.29 A COM
335
180.23
154.77
-027
0.14 A
161.08
79.00
200
-028
-024
2.12 A.
1.98 A
300
206.00
285
291.68
195
217.44
155
L=107.01
R=74.77
T=65.00
SPLIT & COMB.
7/20/92
19984
-023
3.85 A.
15-00-082-000-
PRIOR INST: O.R.522/766
SURVEYED BY: KS ASSOC.
SPLIT C=1:60,440
COMB. C=1:68,552
-022
5.45 A
APPROVED
LORAIN CO.
MAP DEPT.
DATE 7-6-92
PAGE 15-00-082-B
BY CAROLYN FRANCIS
VOID AFTER # 19984
270
68.20
290.58
59.27
92.99
4.99
183.67
2.81
PHEASANT RUN
DR.