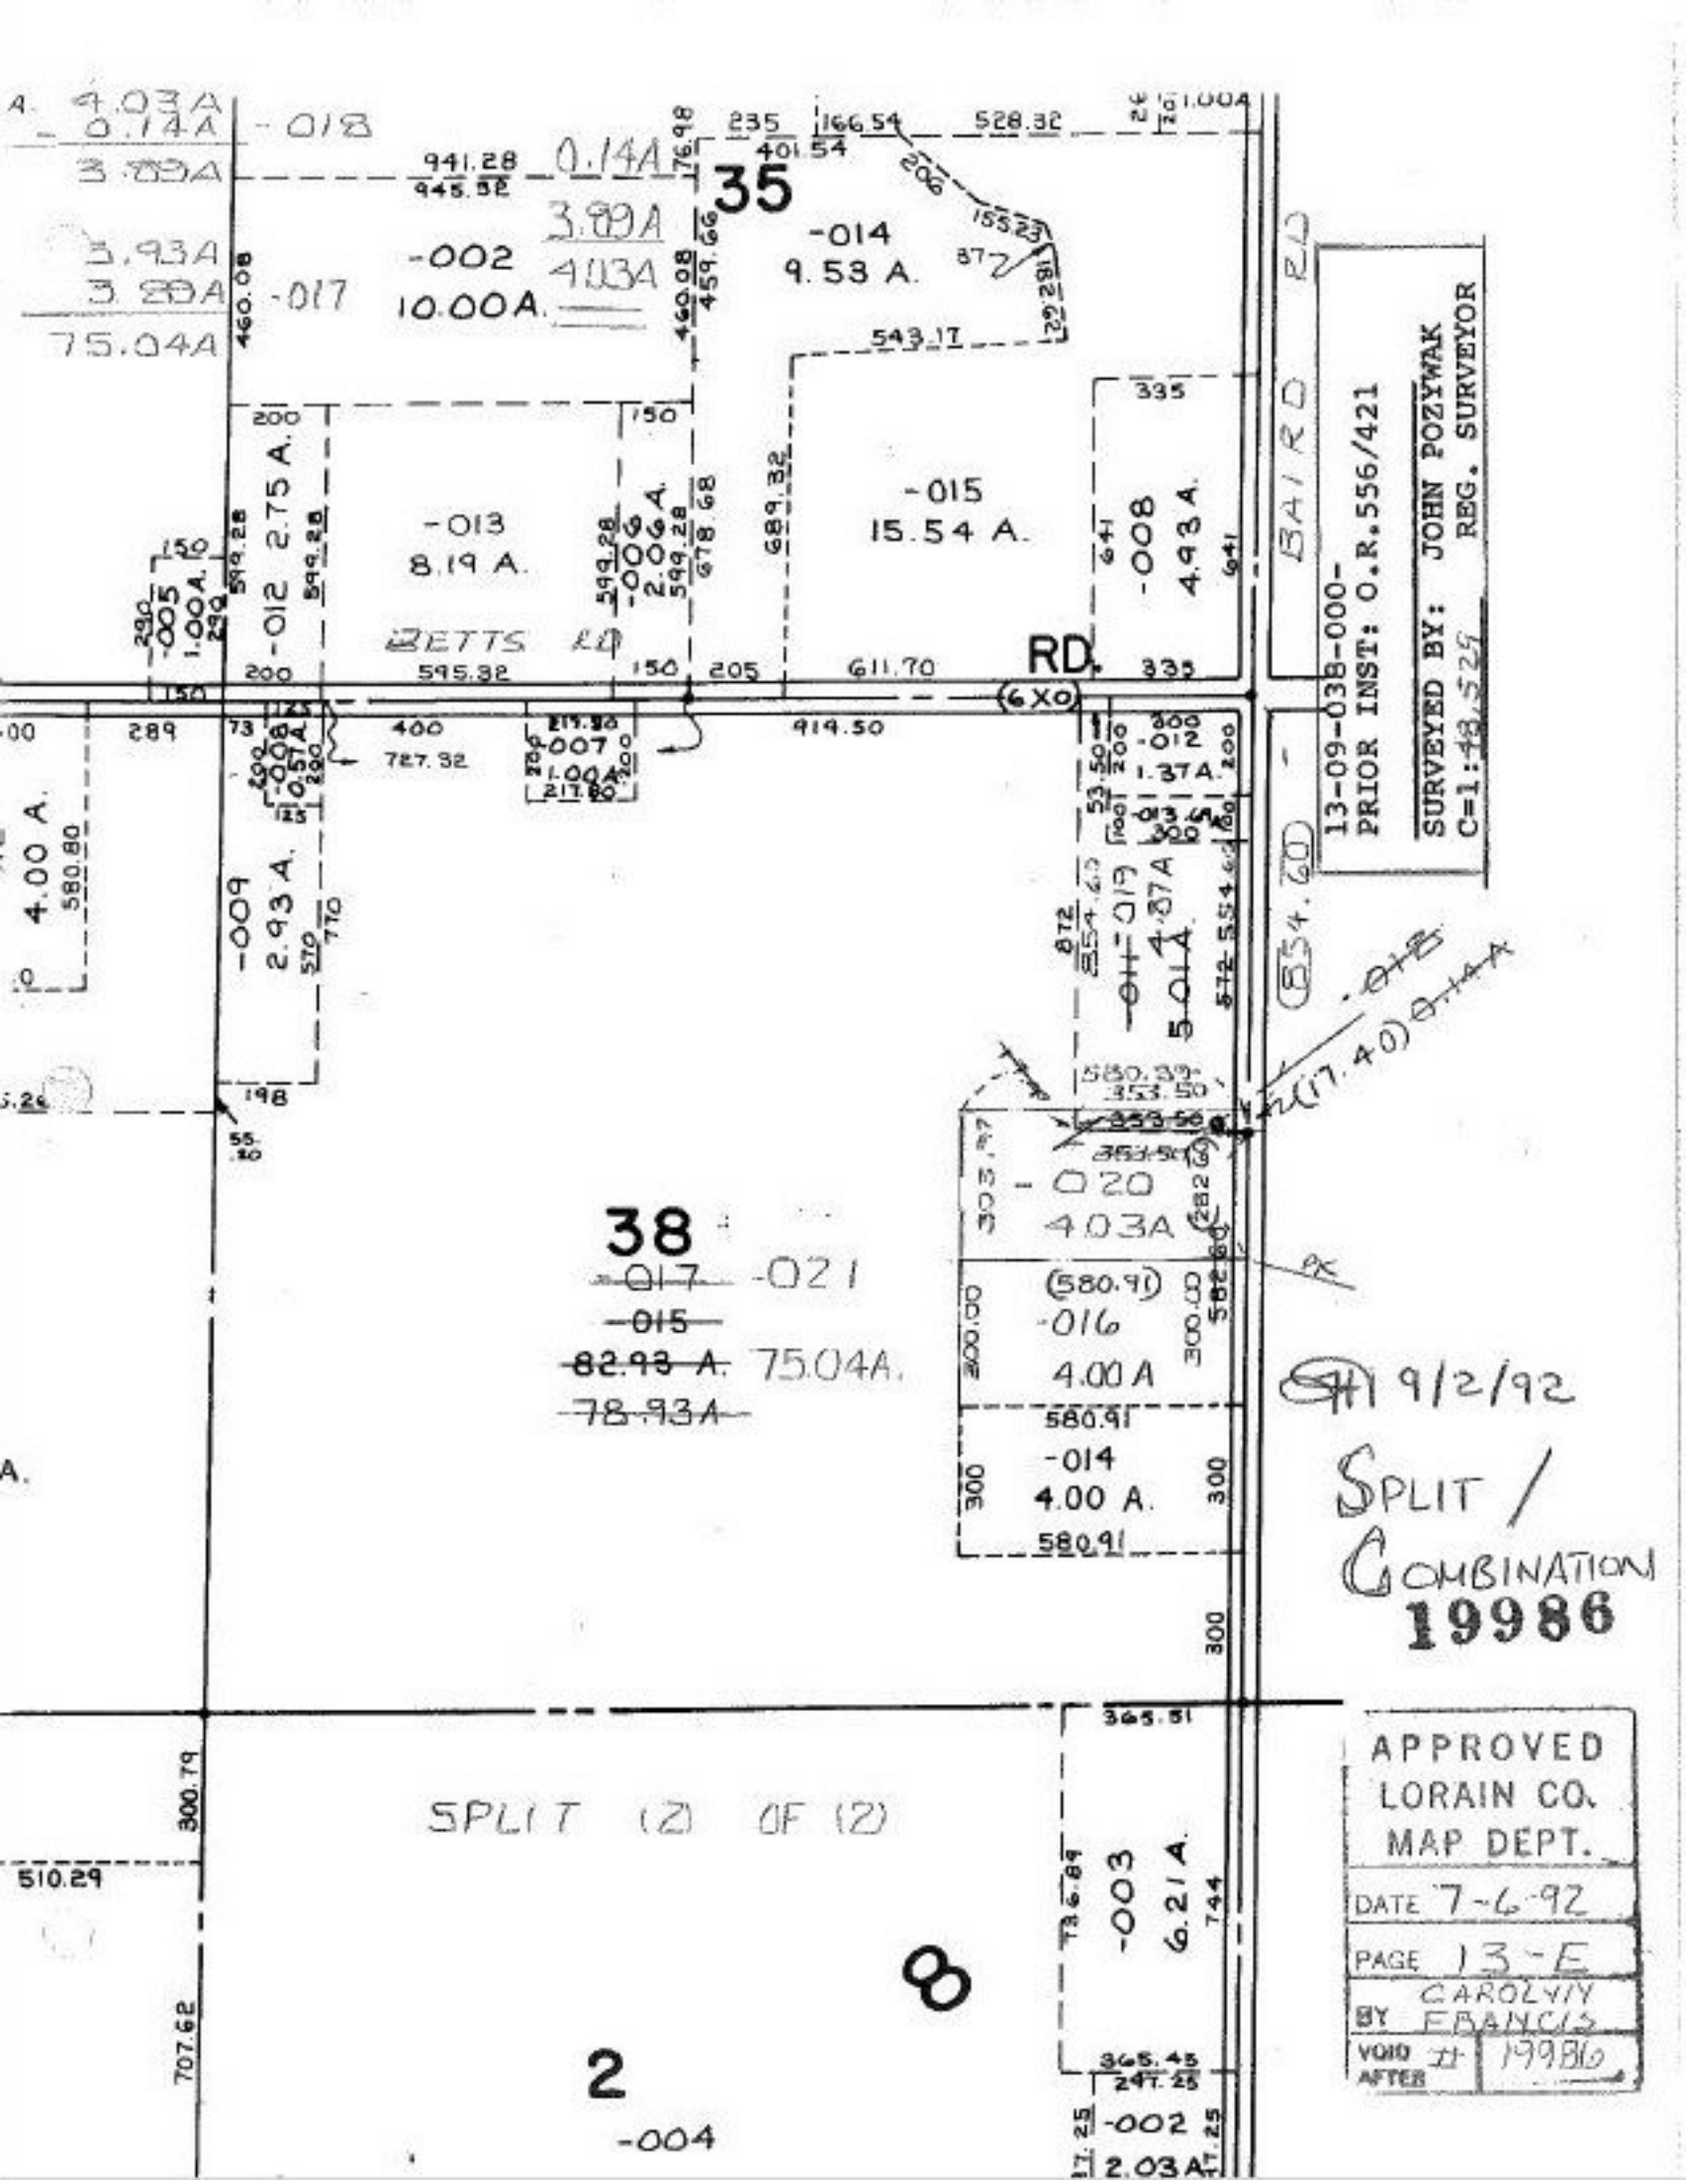
35
-014
9.53 A.
-015
15.54 A.
-013
8.19 A.
-012 2.75 A.
-005 1.00A.
-006 2.00A.
-007 1.00A.
-008 4.93 A.
-009 2.93 A.
-010 1.37A.
-011 4.87A
-019 5.01A.
-020 4.03A
-016 4.00A
-014 4.00 A.
-003 6.21 A.
-002 2.03 A.
-004
4.00 A.
BETTS RD.
BAIRD RD.
(534.60)
(617.40)
13-09-038-000-
PRIOR INST: O.R.556/421
SURVEYED BY: JOHN POZYWAK
C=1:48,525 REG. SURVEYOR
38
-017 -021
-015
82.93 A. 75.04A.
78.93A
SPLIT (2) OF (2)
8
2
9/2/92
SPLIT / COMBINATION
19986
APPROVED
LORAIN CO.
MAP DEPT.
DATE 7-6-92
PAGE 13-E
BY CAROLYN FRANCIS
VOID AFTER 19986