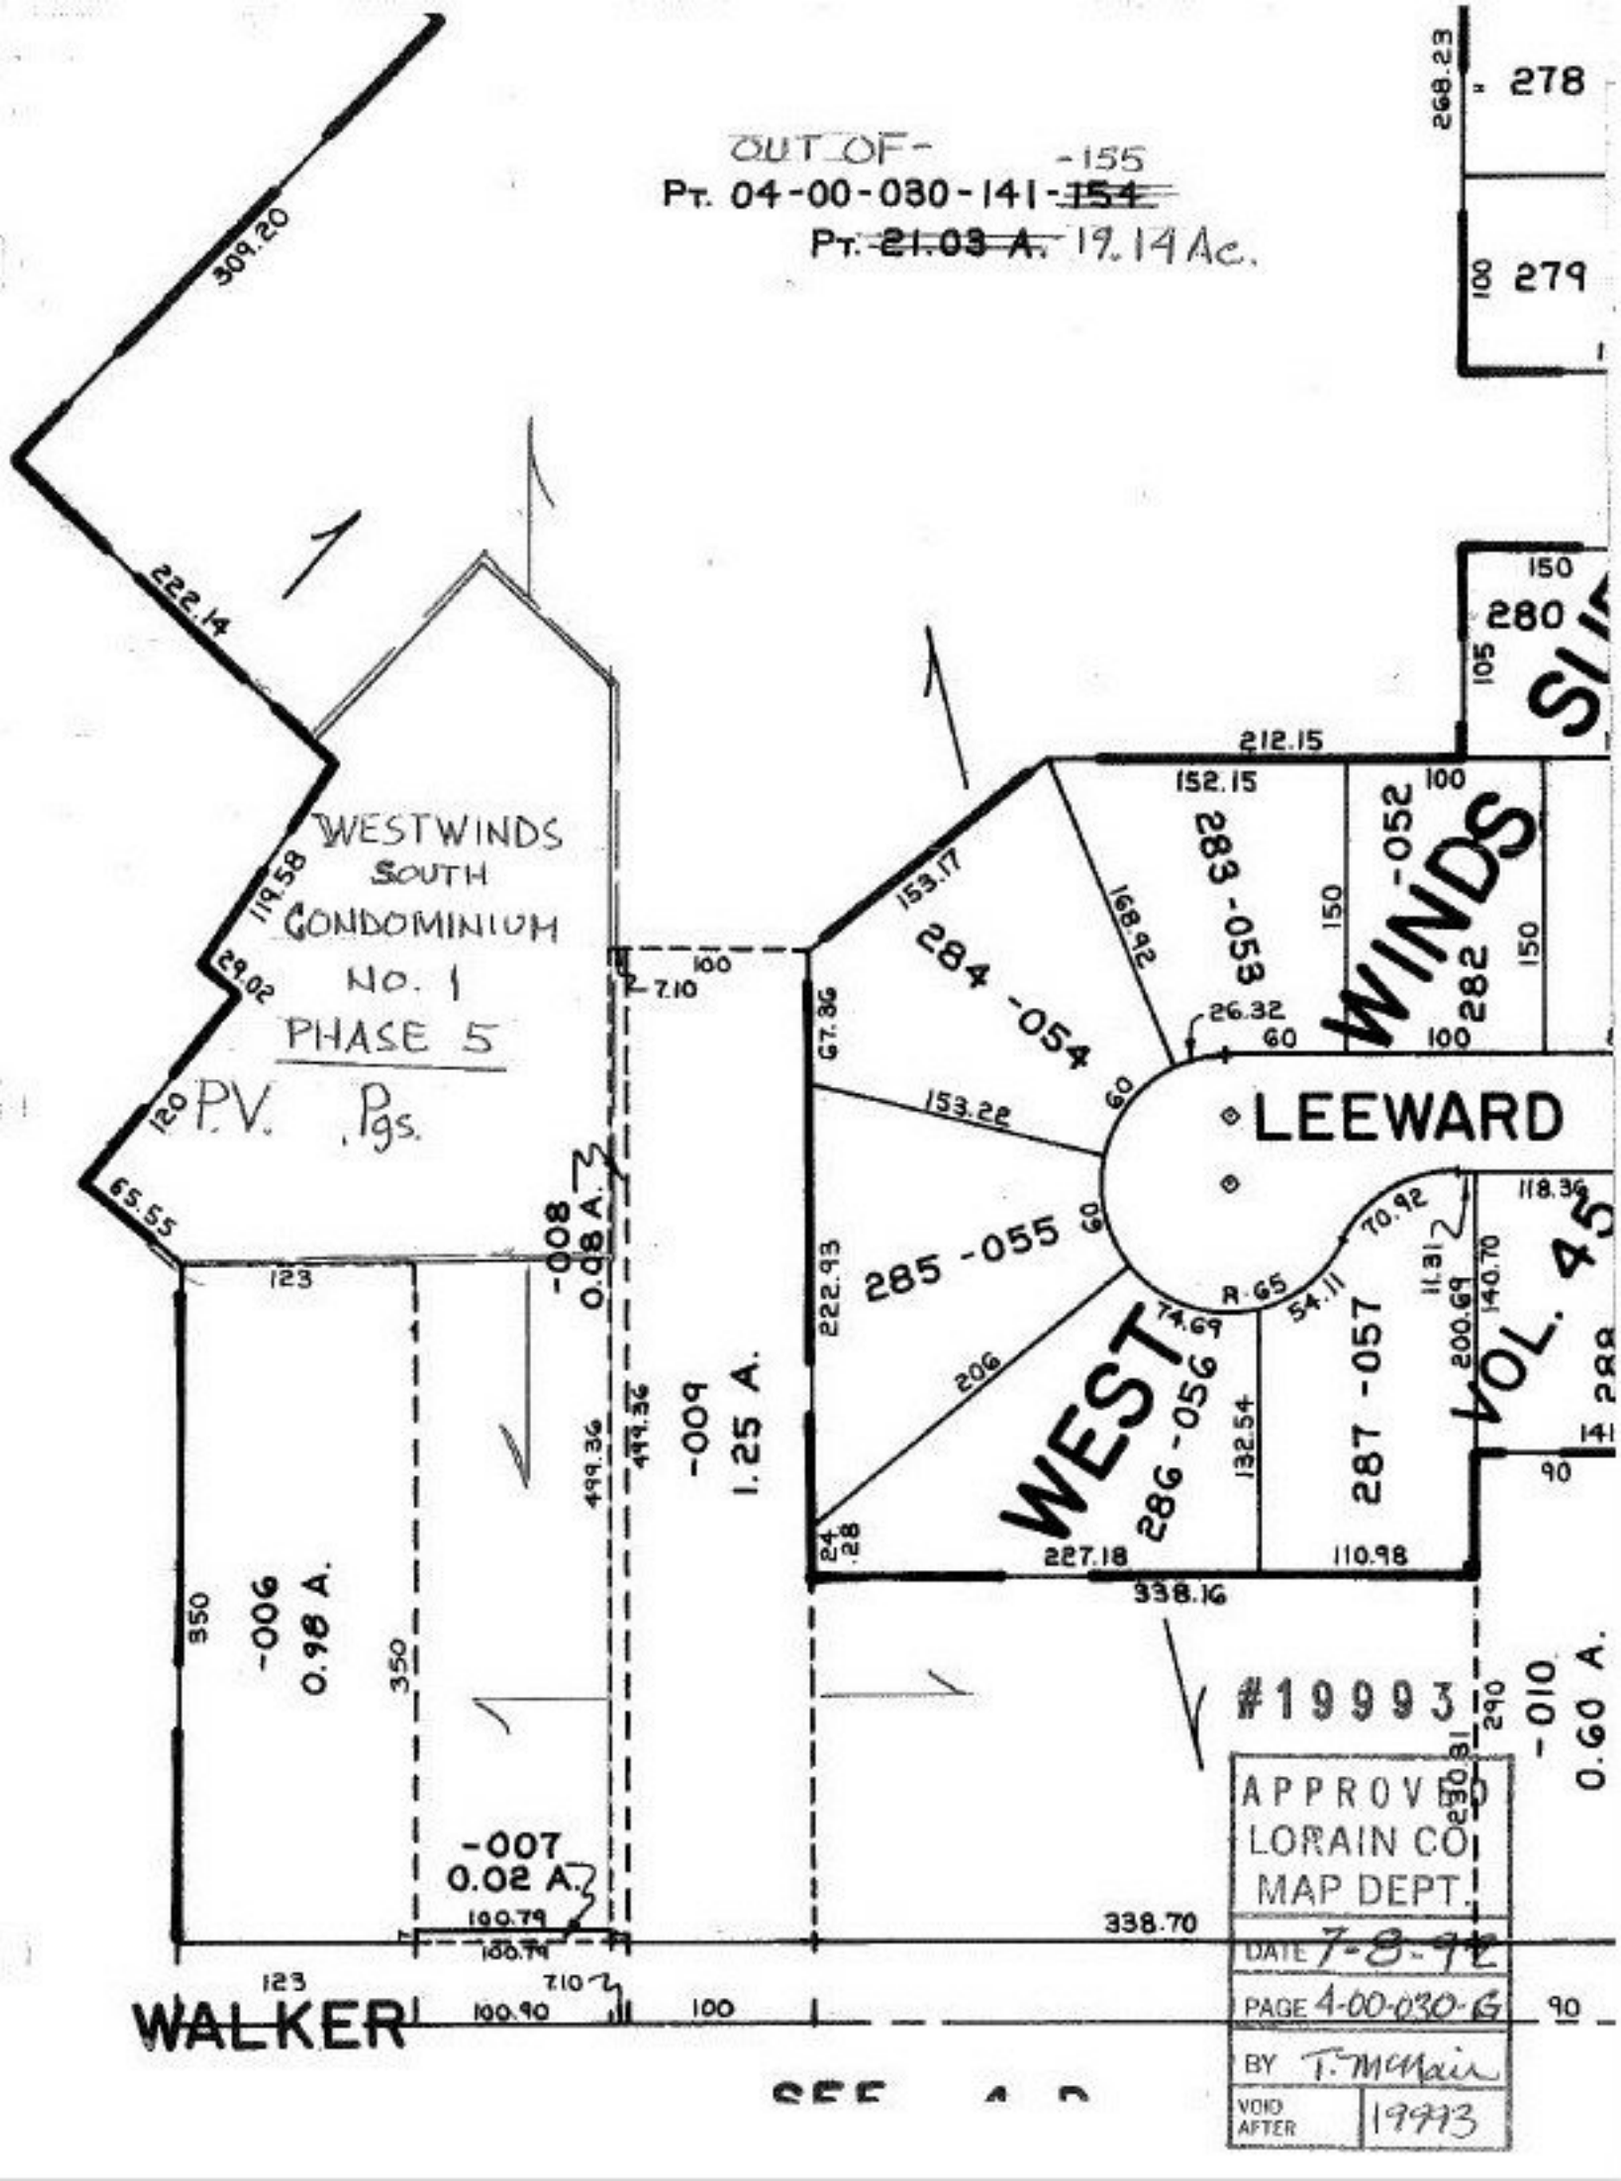
OUT OF-
PT. 04-00-030-141-~~154~~ -155
PT. ~~21.03 A.~~ 19.14 Ac.
WESTWINDS SOUTH CONDOMINIUM NO. 1 PHASE 5
P.V. Pgs.
LEEWARD
WEST WINDS
VOL. 45
WALKER
-006 0.98 A.
-007 0.02 A.
-008 0.08 A.
-009 1.25 A.
-010 0.60 A.
284 -054
285 -055
286 -056
287 -057
283 -053
282 -052
278
279
280
309.20
222.14
119.58
29.02
65.55
212.15
152.15
153.17
153.22
168.92
26.32
67.36
222.93
206
74.69
54.11
70.92
11.31
200.69
140.70
118.36
132.54
227.18
110.98
338.16
338.70
100.79
100.90
7.10
123
350
499.36
268.23
#19993
APPROVED
LORAIN CO.
MAP DEPT.
DATE 7-8-92
PAGE 4-00-030-G
BY T. McNair
VOID AFTER 19993