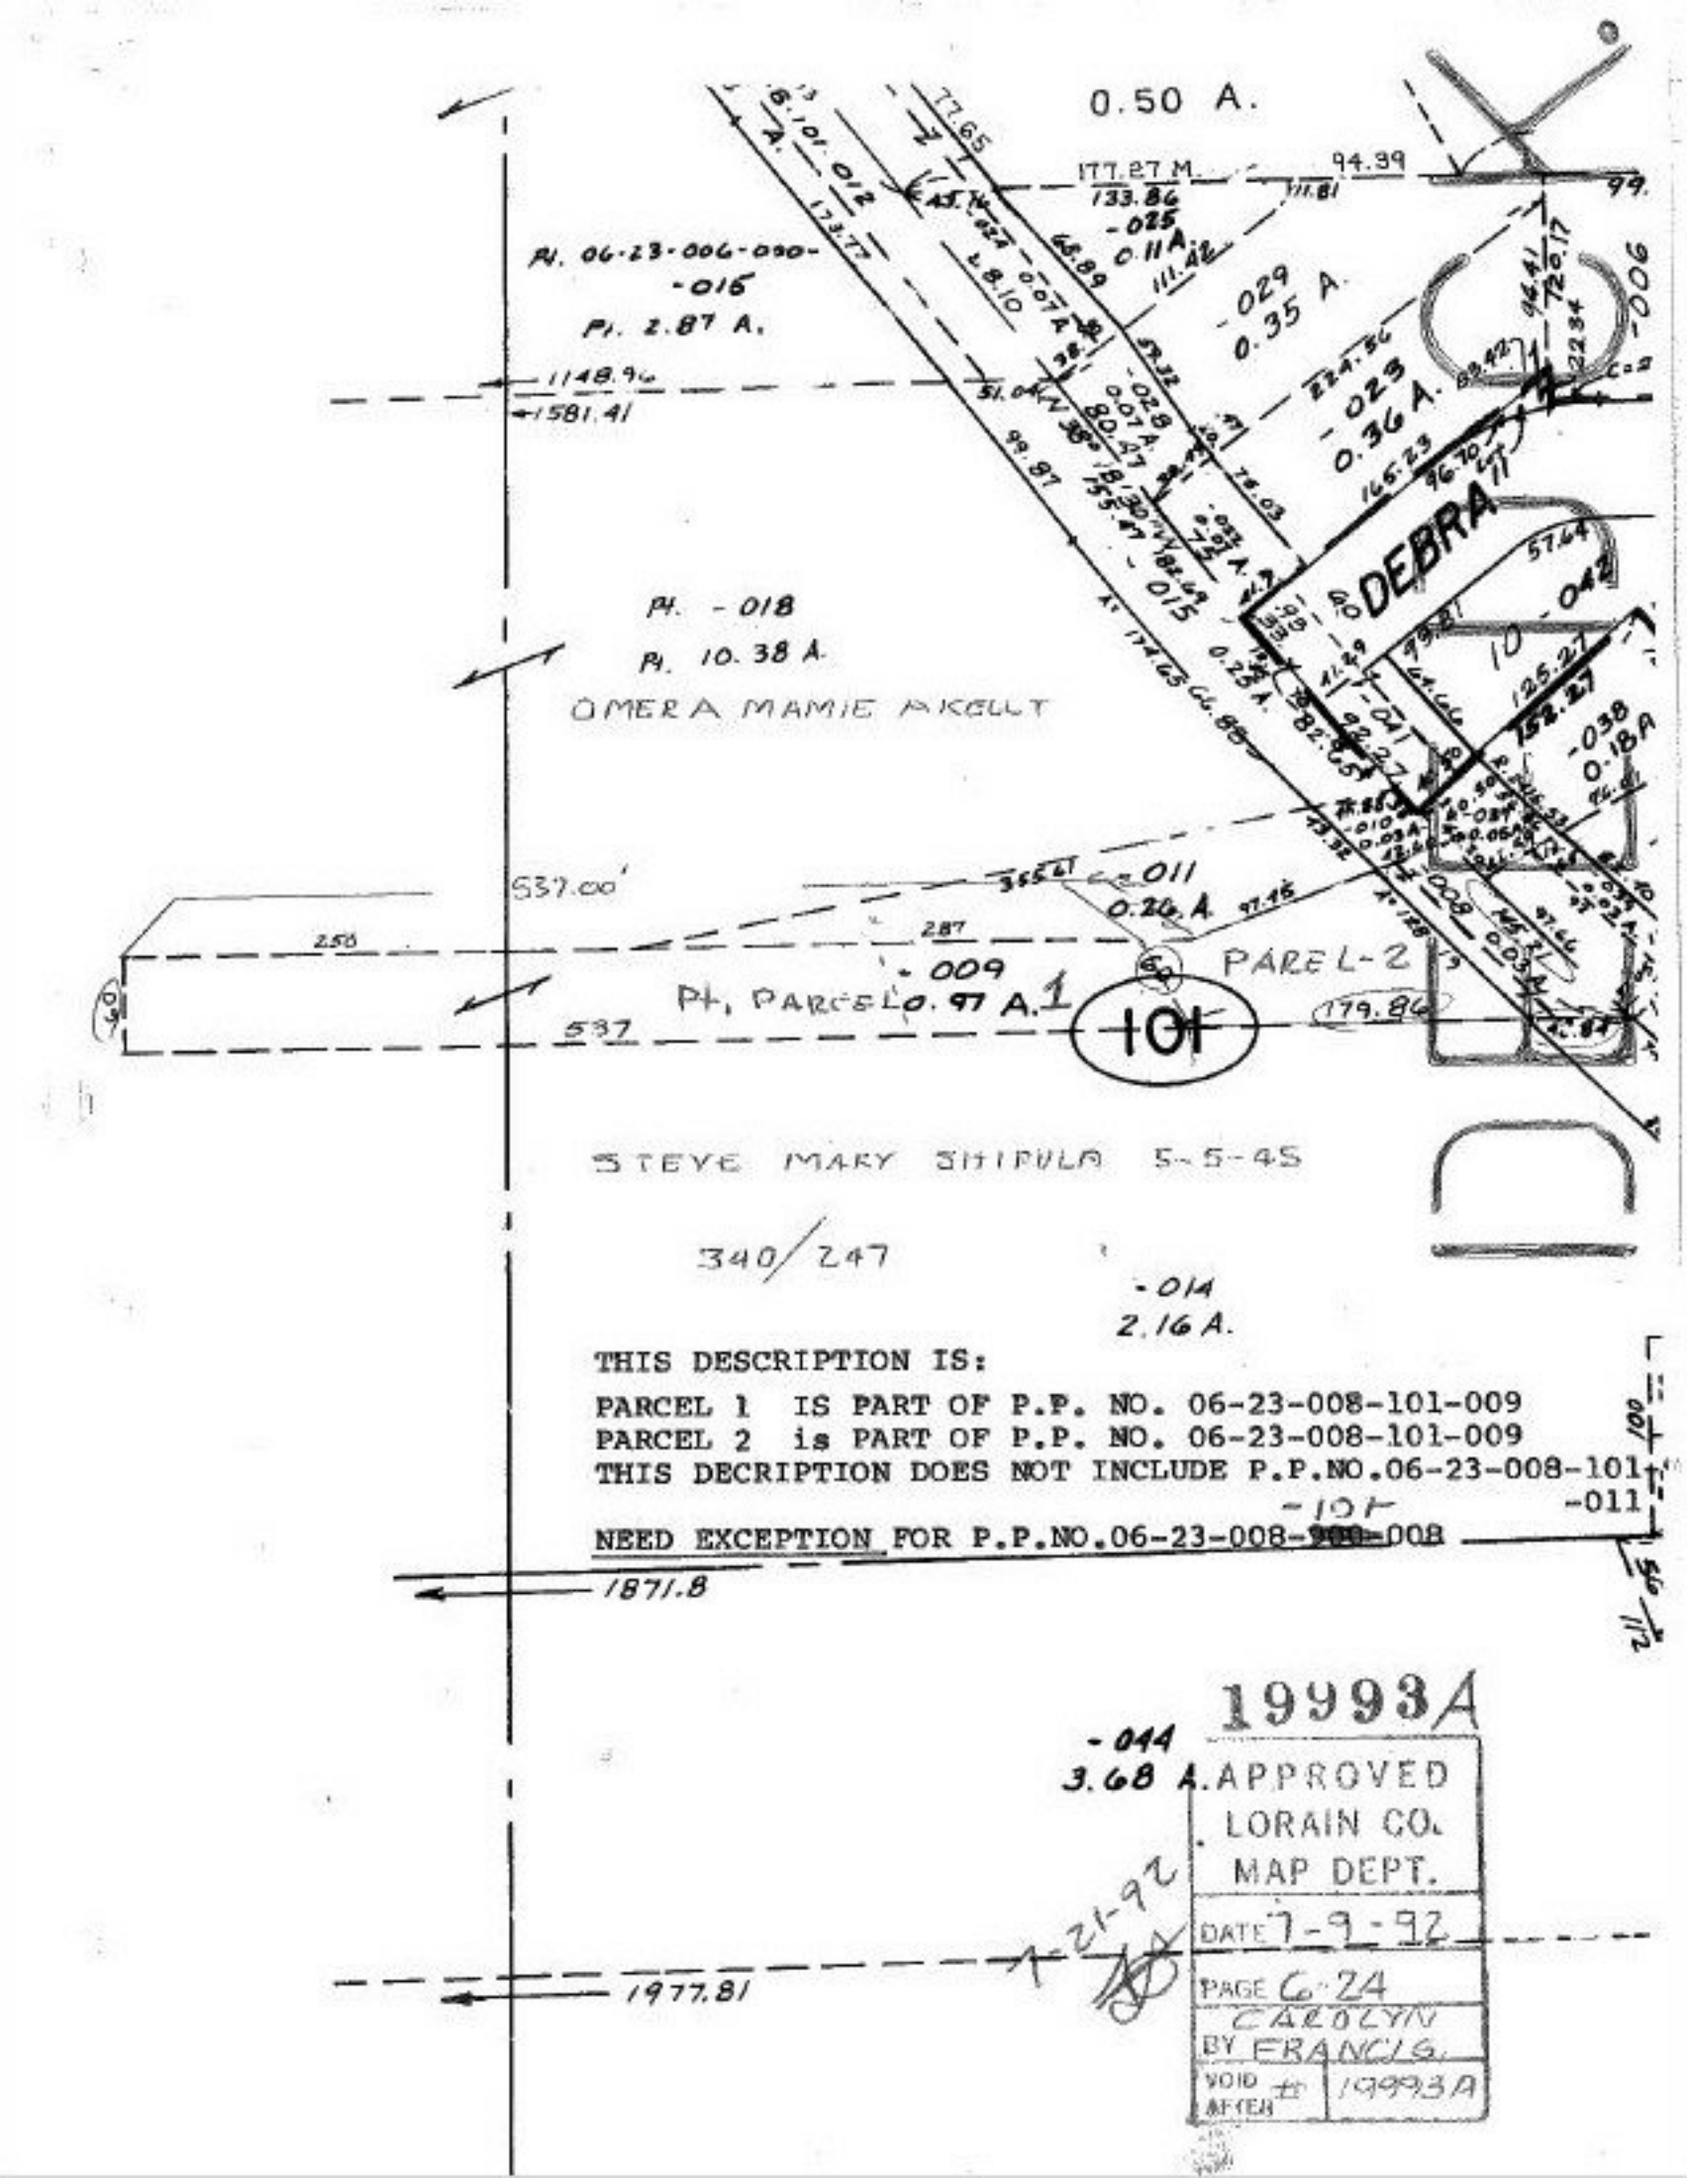

THIS DESCRIPTION IS:

PARCEL 1 IS PART OF P.P. NO. 06-23-008-101-009
PARCEL 2 is PART OF P.P. NO. 06-23-008-101-009
THIS DECRIPTION DOES NOT INCLUDE P.P.NO.06-23-008-101-011
-101
NEED EXCEPTION FOR P.P.NO.06-23-008-~~101~~-008

19993A

APPROVED
LORAIN CO.
MAP DEPT.
DATE 7-9-92
PAGE C-24
CAROLYN
BY FRANCIS
VOID AFTER # 19993A