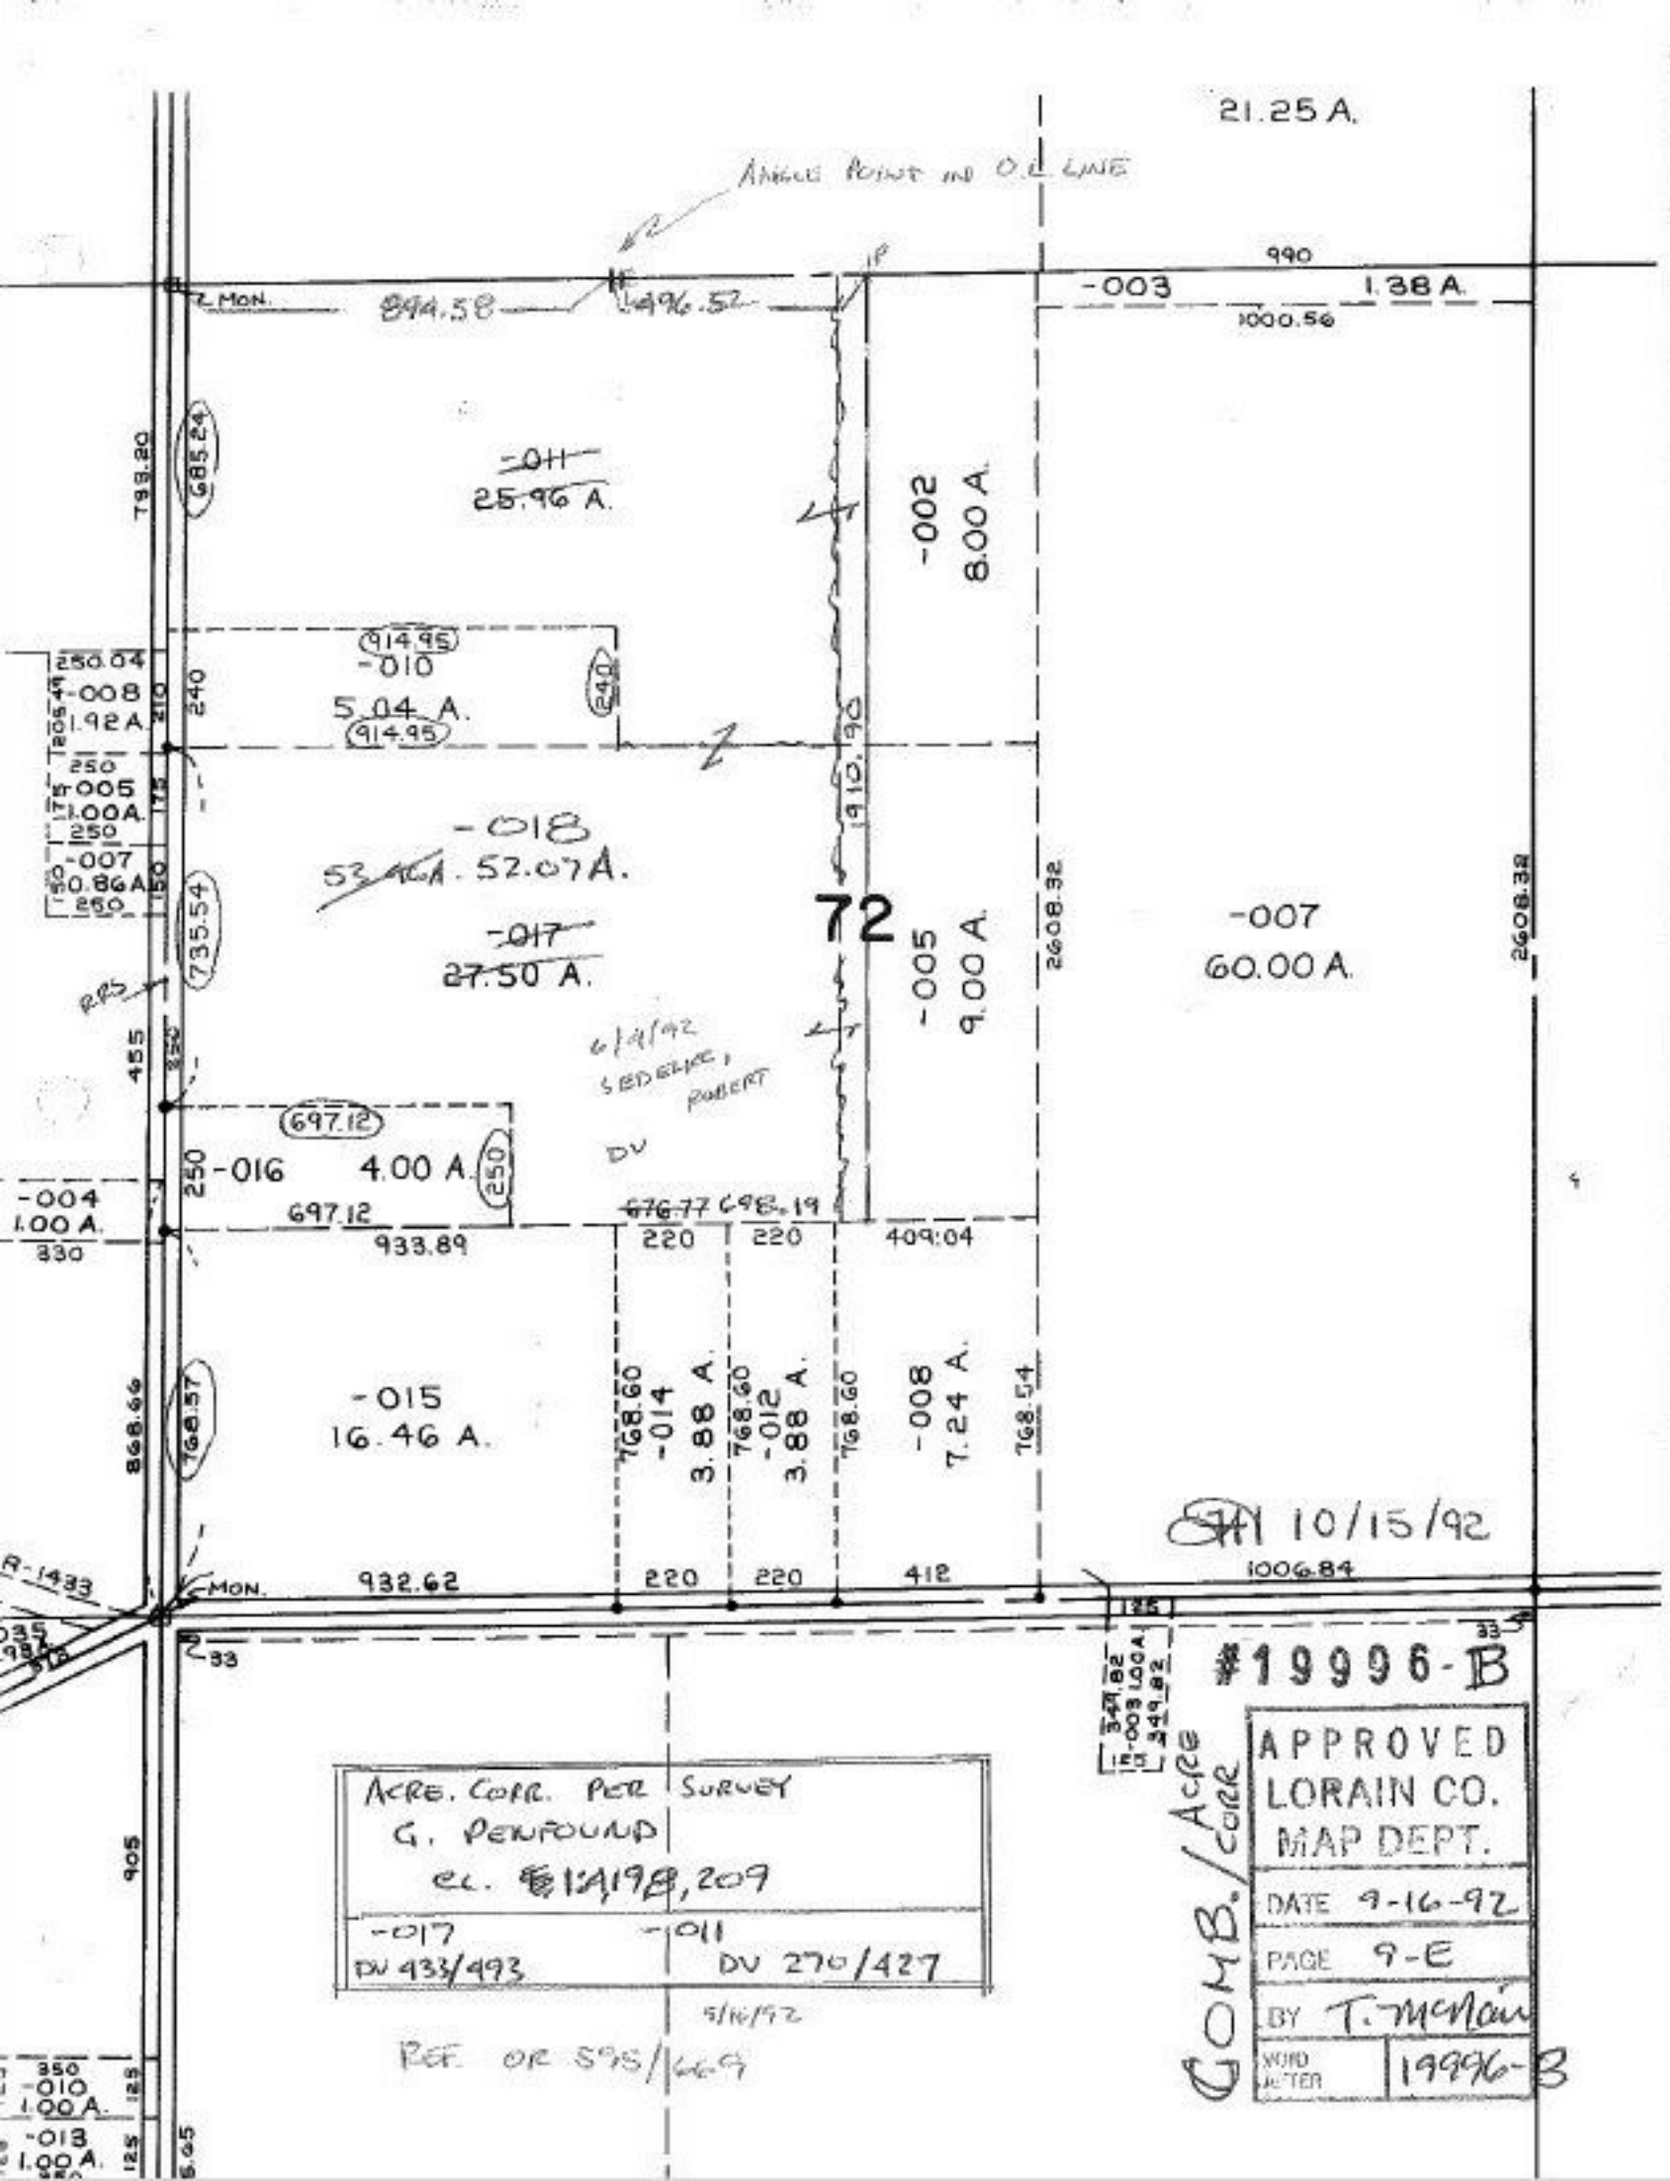
21.25 A.
ANGLE POINT IN O.L. LINE
990
-003
1.38 A.
1000.56
MON.
894.58
496.52
-011
25.96 A.
-002
8.00 A.
914.95
-010
5.04 A.
914.95
-008
1.92 A.
-005
1.00 A.
-007
0.86 A.
-018
52.07 A.
-017
27.50 A.
72
-005
9.00 A.
-007
60.00 A.
2608.32
2608.32
6/4/92
SEDELIC, ROBERT
DV
697.12
-016
4.00 A.
-004
1.00 A.
697.12
933.89
676.77
698.19
220
220
409.04
-015
16.46 A.
768.60
-014
3.88 A.
768.60
-012
3.88 A.
768.60
-008
7.24 A.
768.54
10/15/92
MON.
932.62
220
220
412
1006.84
#19996-B
ACRE. CORR. PER SURVEY
G. PENFOUND
EL. 1:4,198,209
-017
DV 433/493
-011
DV 270/427
5/16/92
REF. OR 595/669
COMB./ACRE CORR
APPROVED
LORAIN CO.
MAP DEPT.
DATE 9-16-92
PAGE 9-E
BY T. McNair
WORD LETTER 19996-B
-010
1.00 A.
-013
1.00 A.