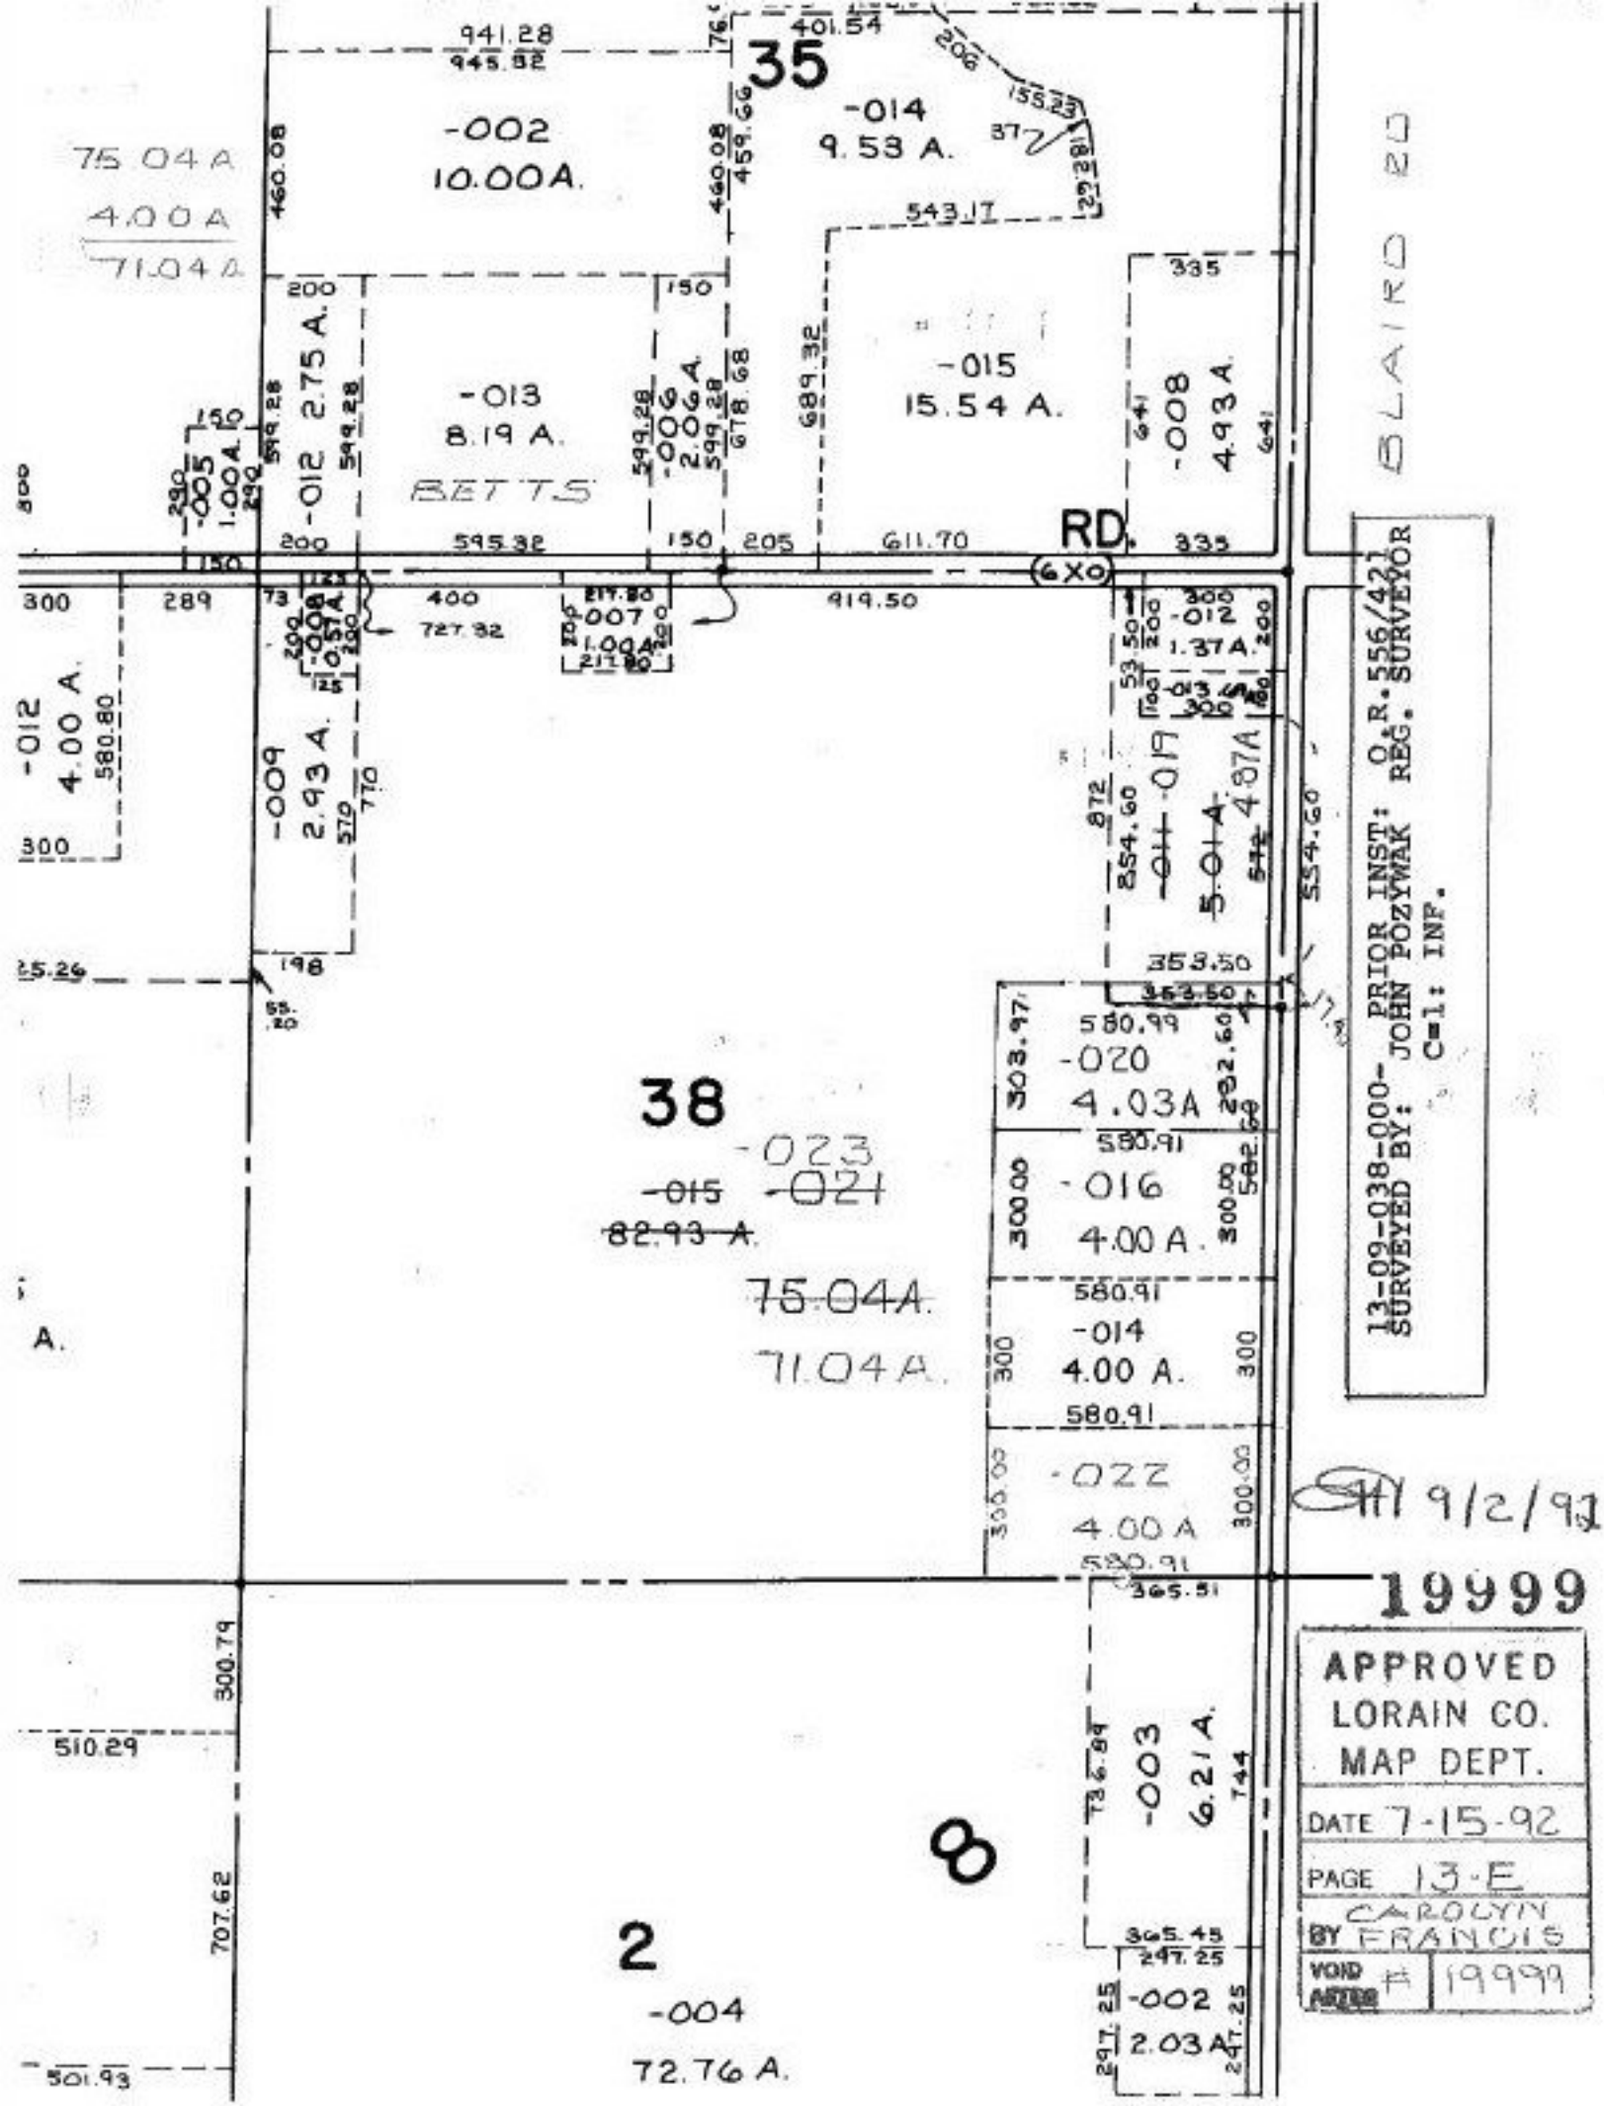
35
-002
10.00A.
-014
9.53 A.
75.04A
4.00A
71.04A
-013
8.19 A.
BETTS
-012 2.75 A.
-005 1.00A.
-006 2.06A.
-015
15.54 A.
-008
4.93 A.
BLAIRD RD.
-012
4.00 A.
-009
2.93 A.
-007 1.00A.
-012 1.37A.
-011 -019
5.01A. 4.87A
13-09-038-000-
SURVEYED BY: JOHN POZYWAK PRIOR INST: O.R. 556/421 REG. SURVEYOR
C=1: INF.
38
-023
-015 -021
82.93 A.
75.04A.
71.04A.
-020
4.03A
-016
4.00 A.
-014
4.00 A.
-022
4.00A
-003
6.21A.
8
2
-004
72.76 A.
-002
2.03A.
9/2/91
19999
APPROVED
LORAIN CO.
MAP DEPT.
DATE 7-15-92
PAGE 13-E
BY CAROLYN FRANCIS
VOID AFTER # 19999