PARENT PARCEL: 08-00-087-000-010
CHILD PARCEL: 08-00-087-000-024, -025
STARTING POINT: INTERSECTION OF C/L OF S.R.113 AND C/L OF BAUMHART RD.

20-00769

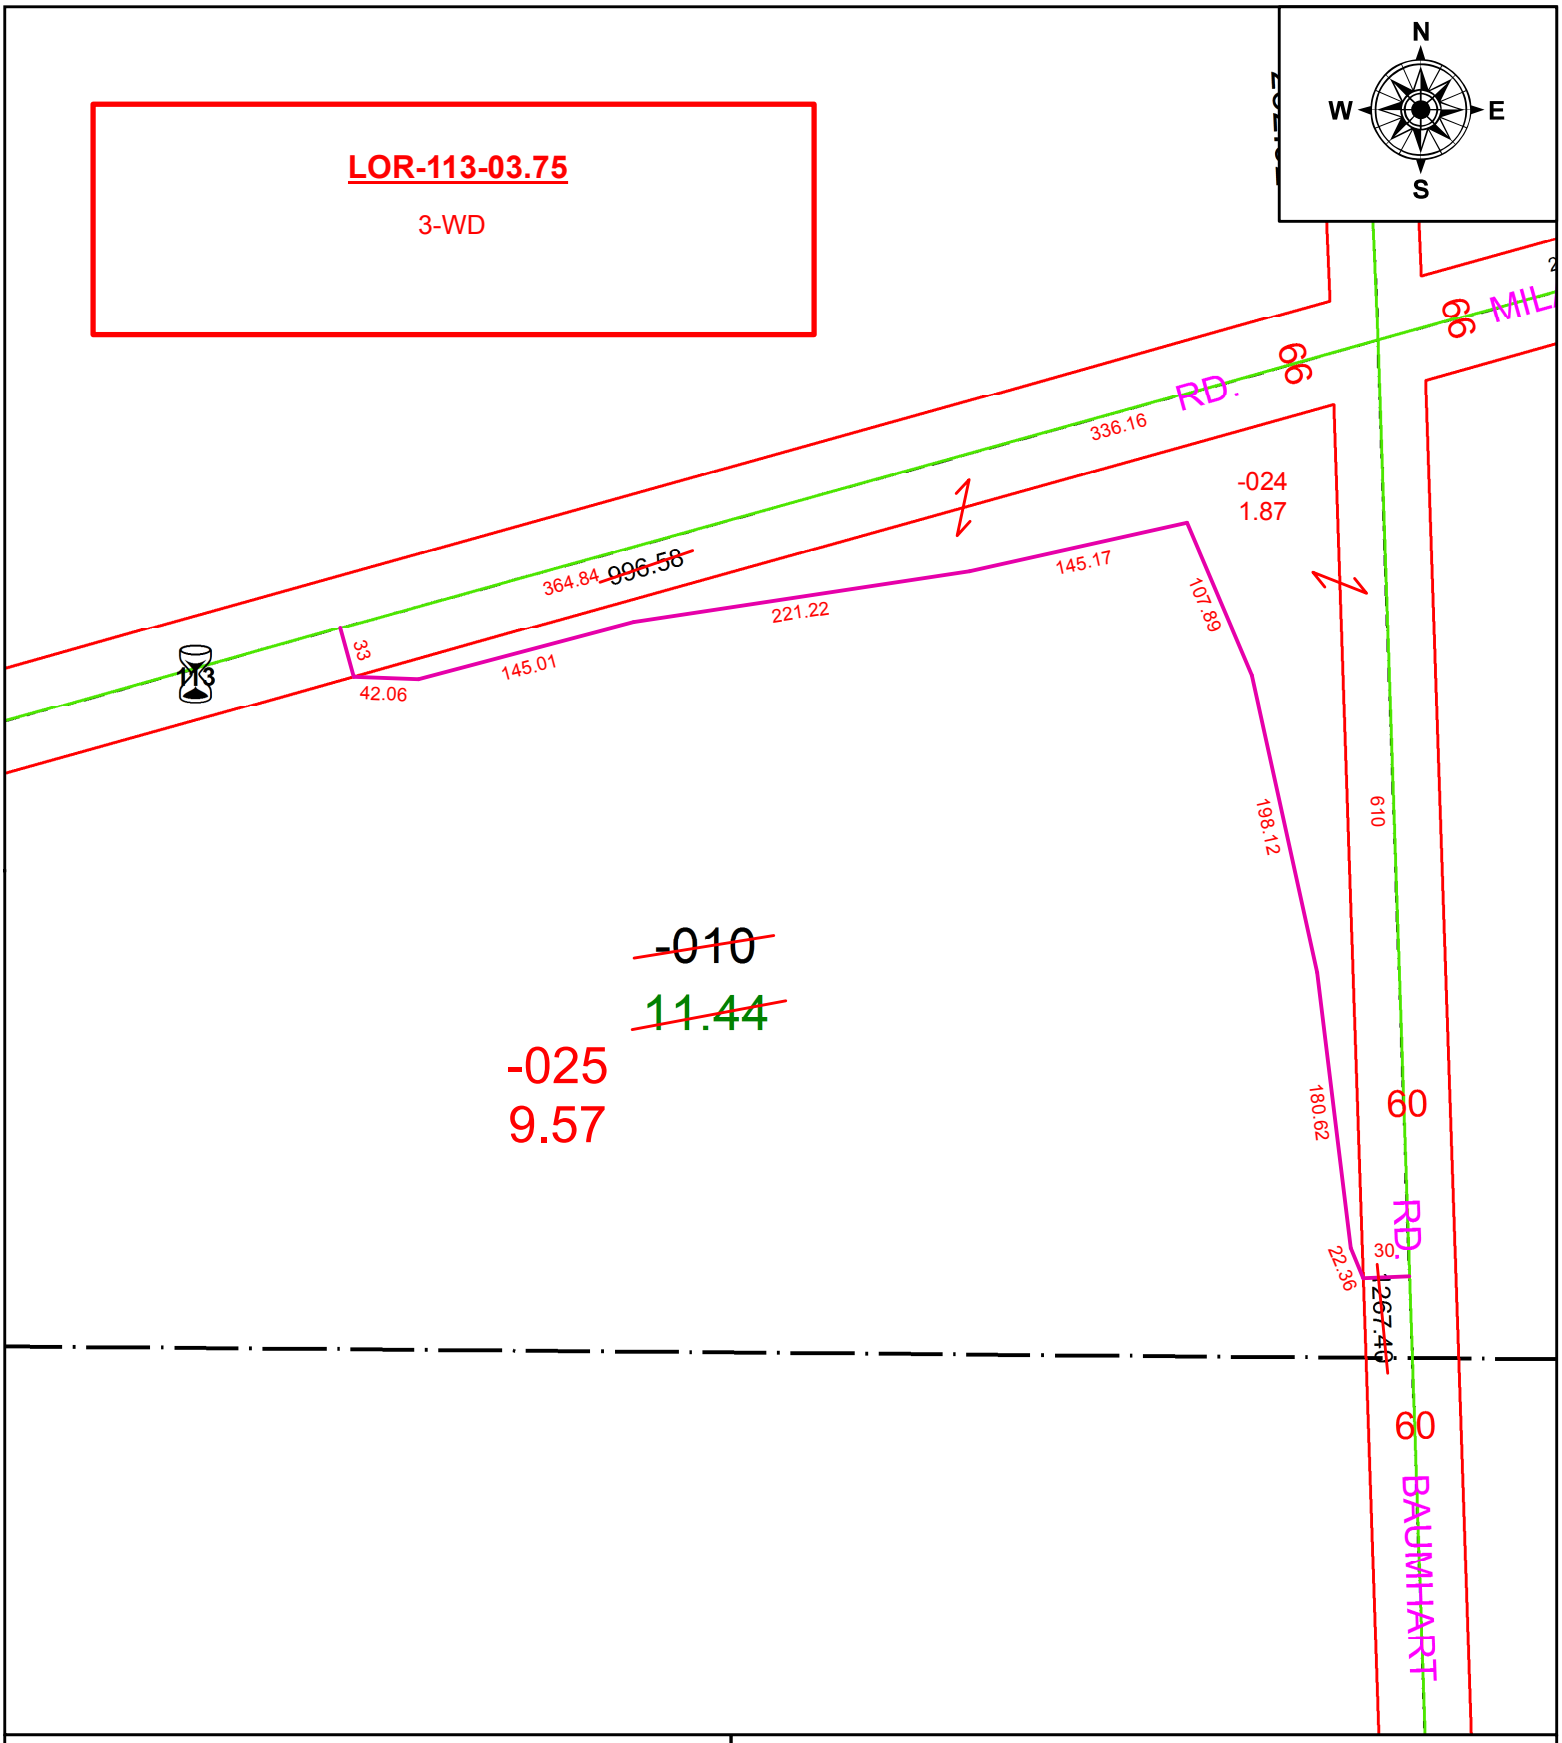

SPLITS/DEEDS PROCESSED
LORAIN COUNTY TAX MAP DEPARTMENT
226 MIDDLE AVE. ELYRIA, OH

SURVEYED BY: JEFFREY M, BAIRD
CLOSURE: 1:589,608
MAP PAGE(S): 8-00-087
APPOVED BY: RRM **DATE:** 7-7-20
SCALE: 1" = 125 **PRIOR INSTRUMENT:** 20120440646