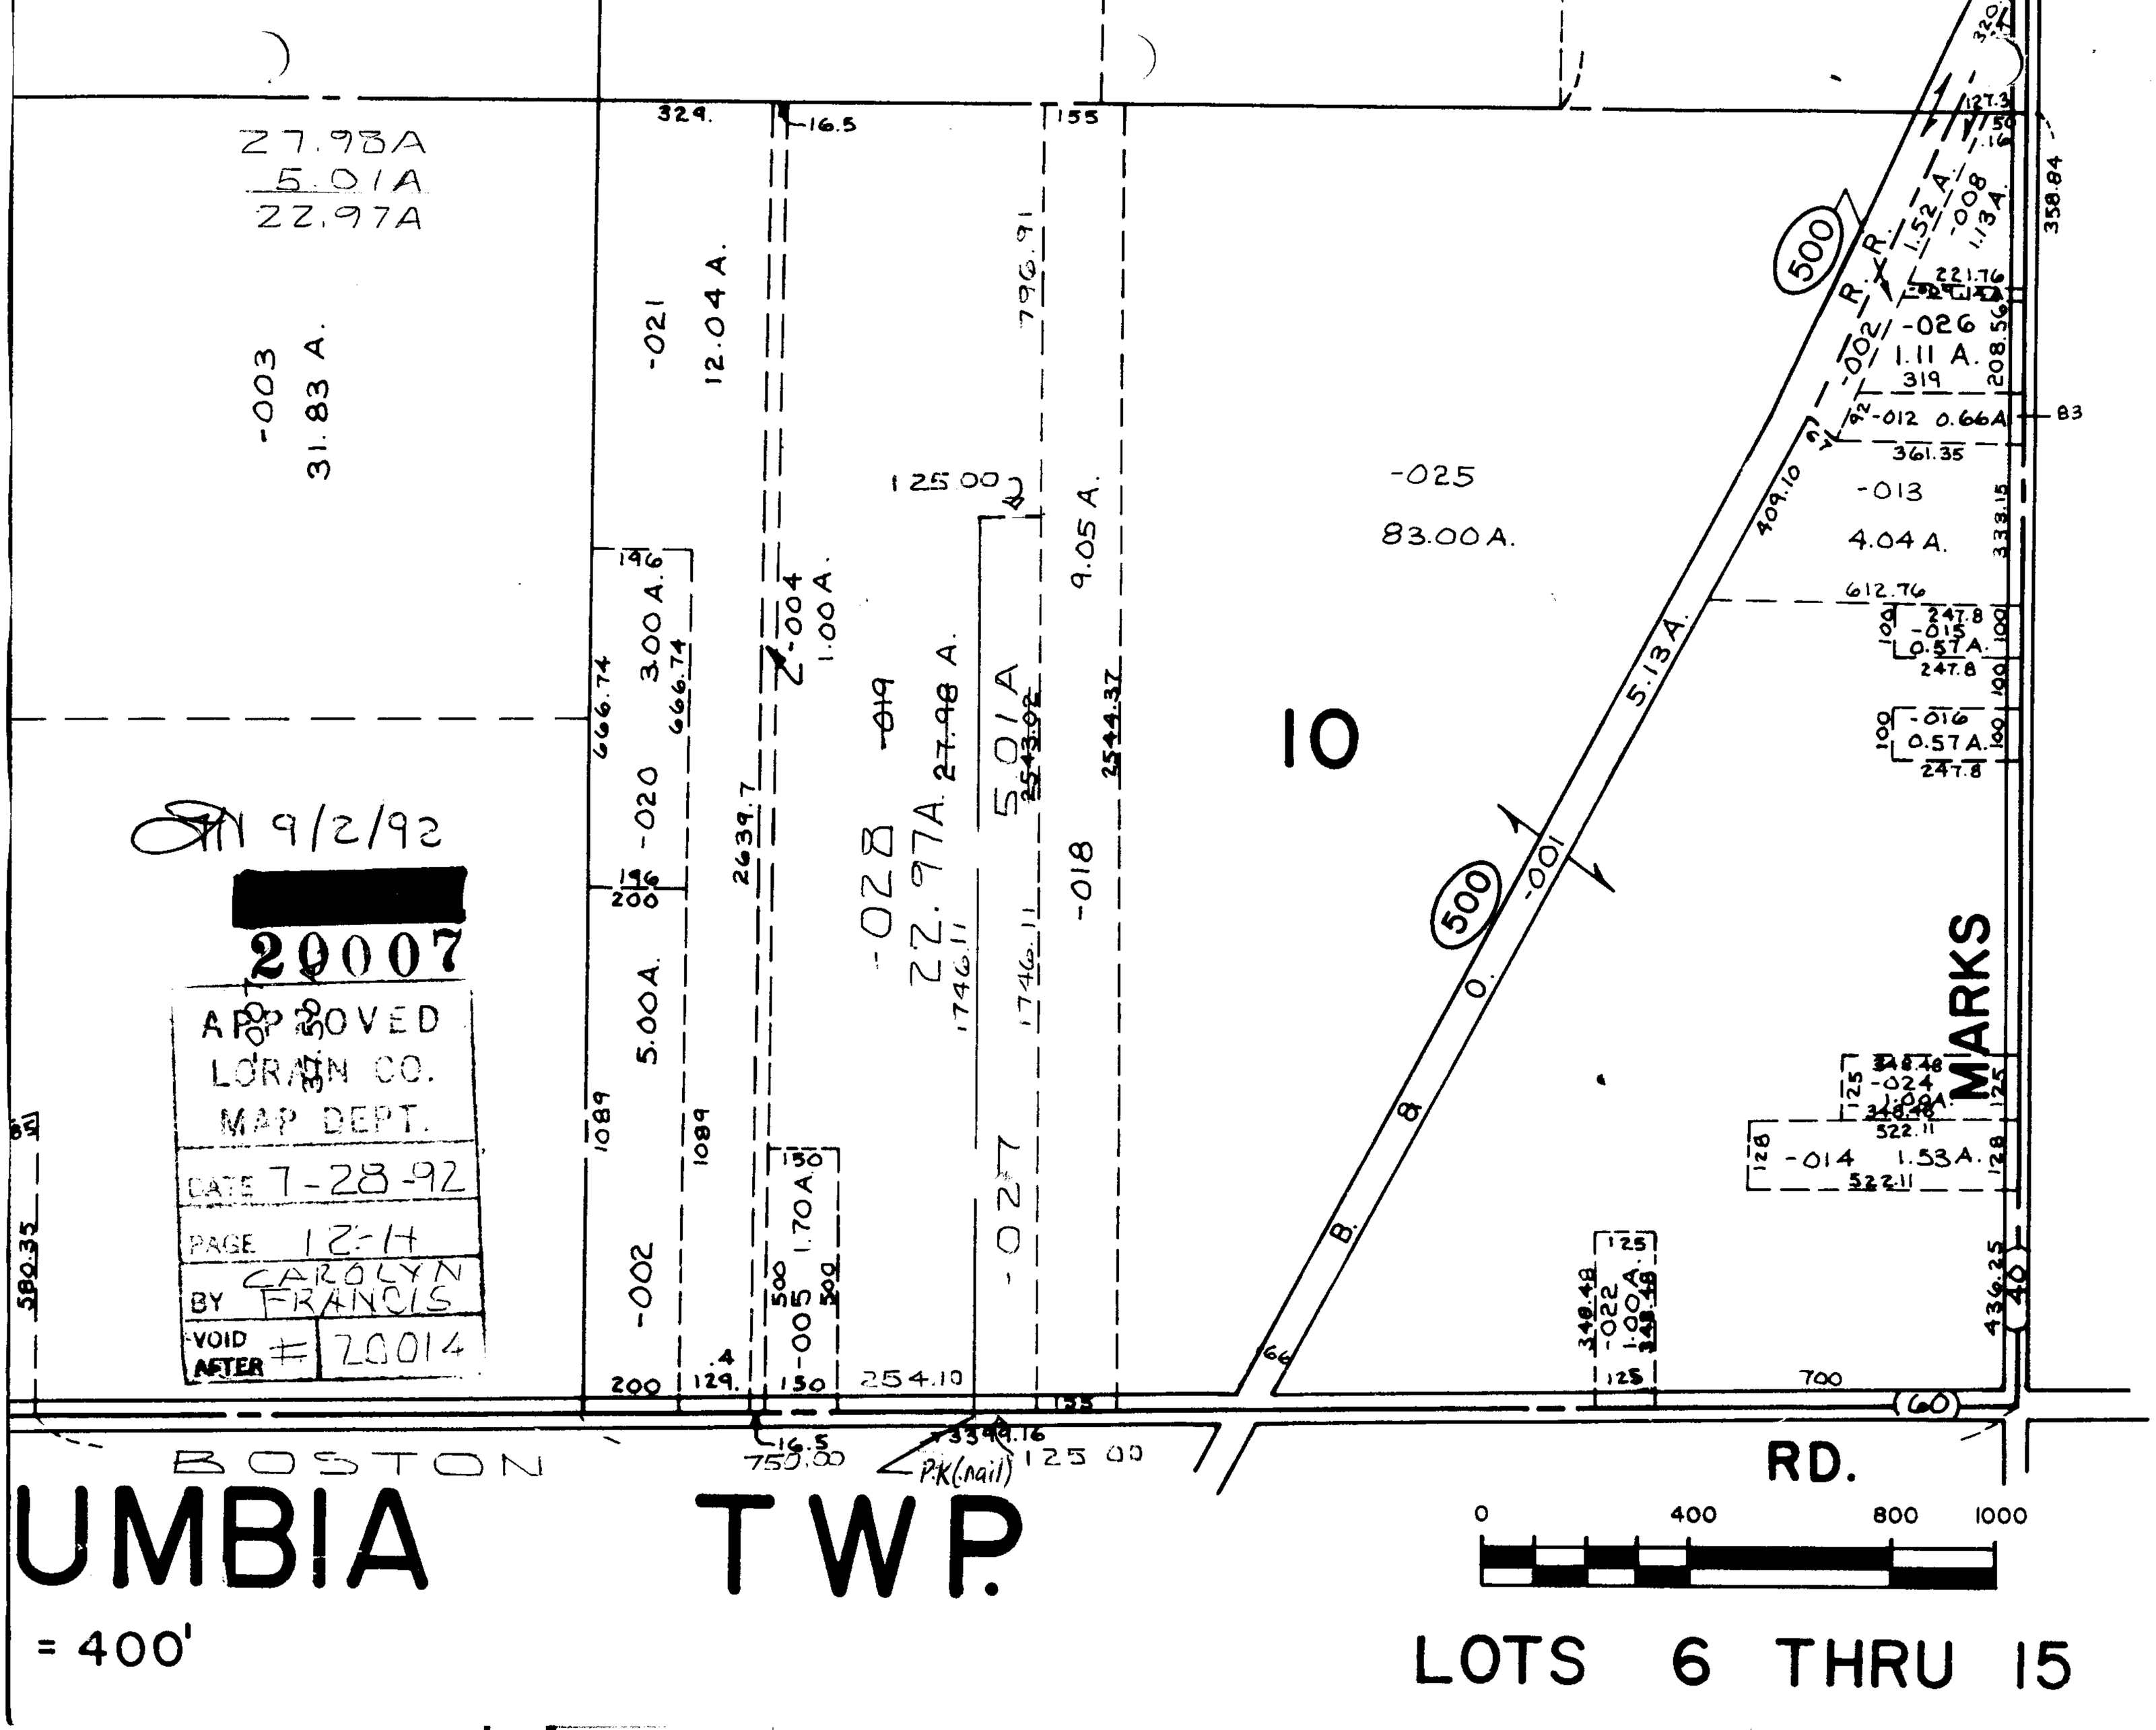

9/2/92

[redacted]

20007

APPROVED
LORAIN CO.
MAP DEPT.
DATE 7-28-92
PAGE 12-H
BY CAROLYN FRANCIS
VOID AFTER # 20014

UMBIA TWP.

LOTS 6 THRU 15