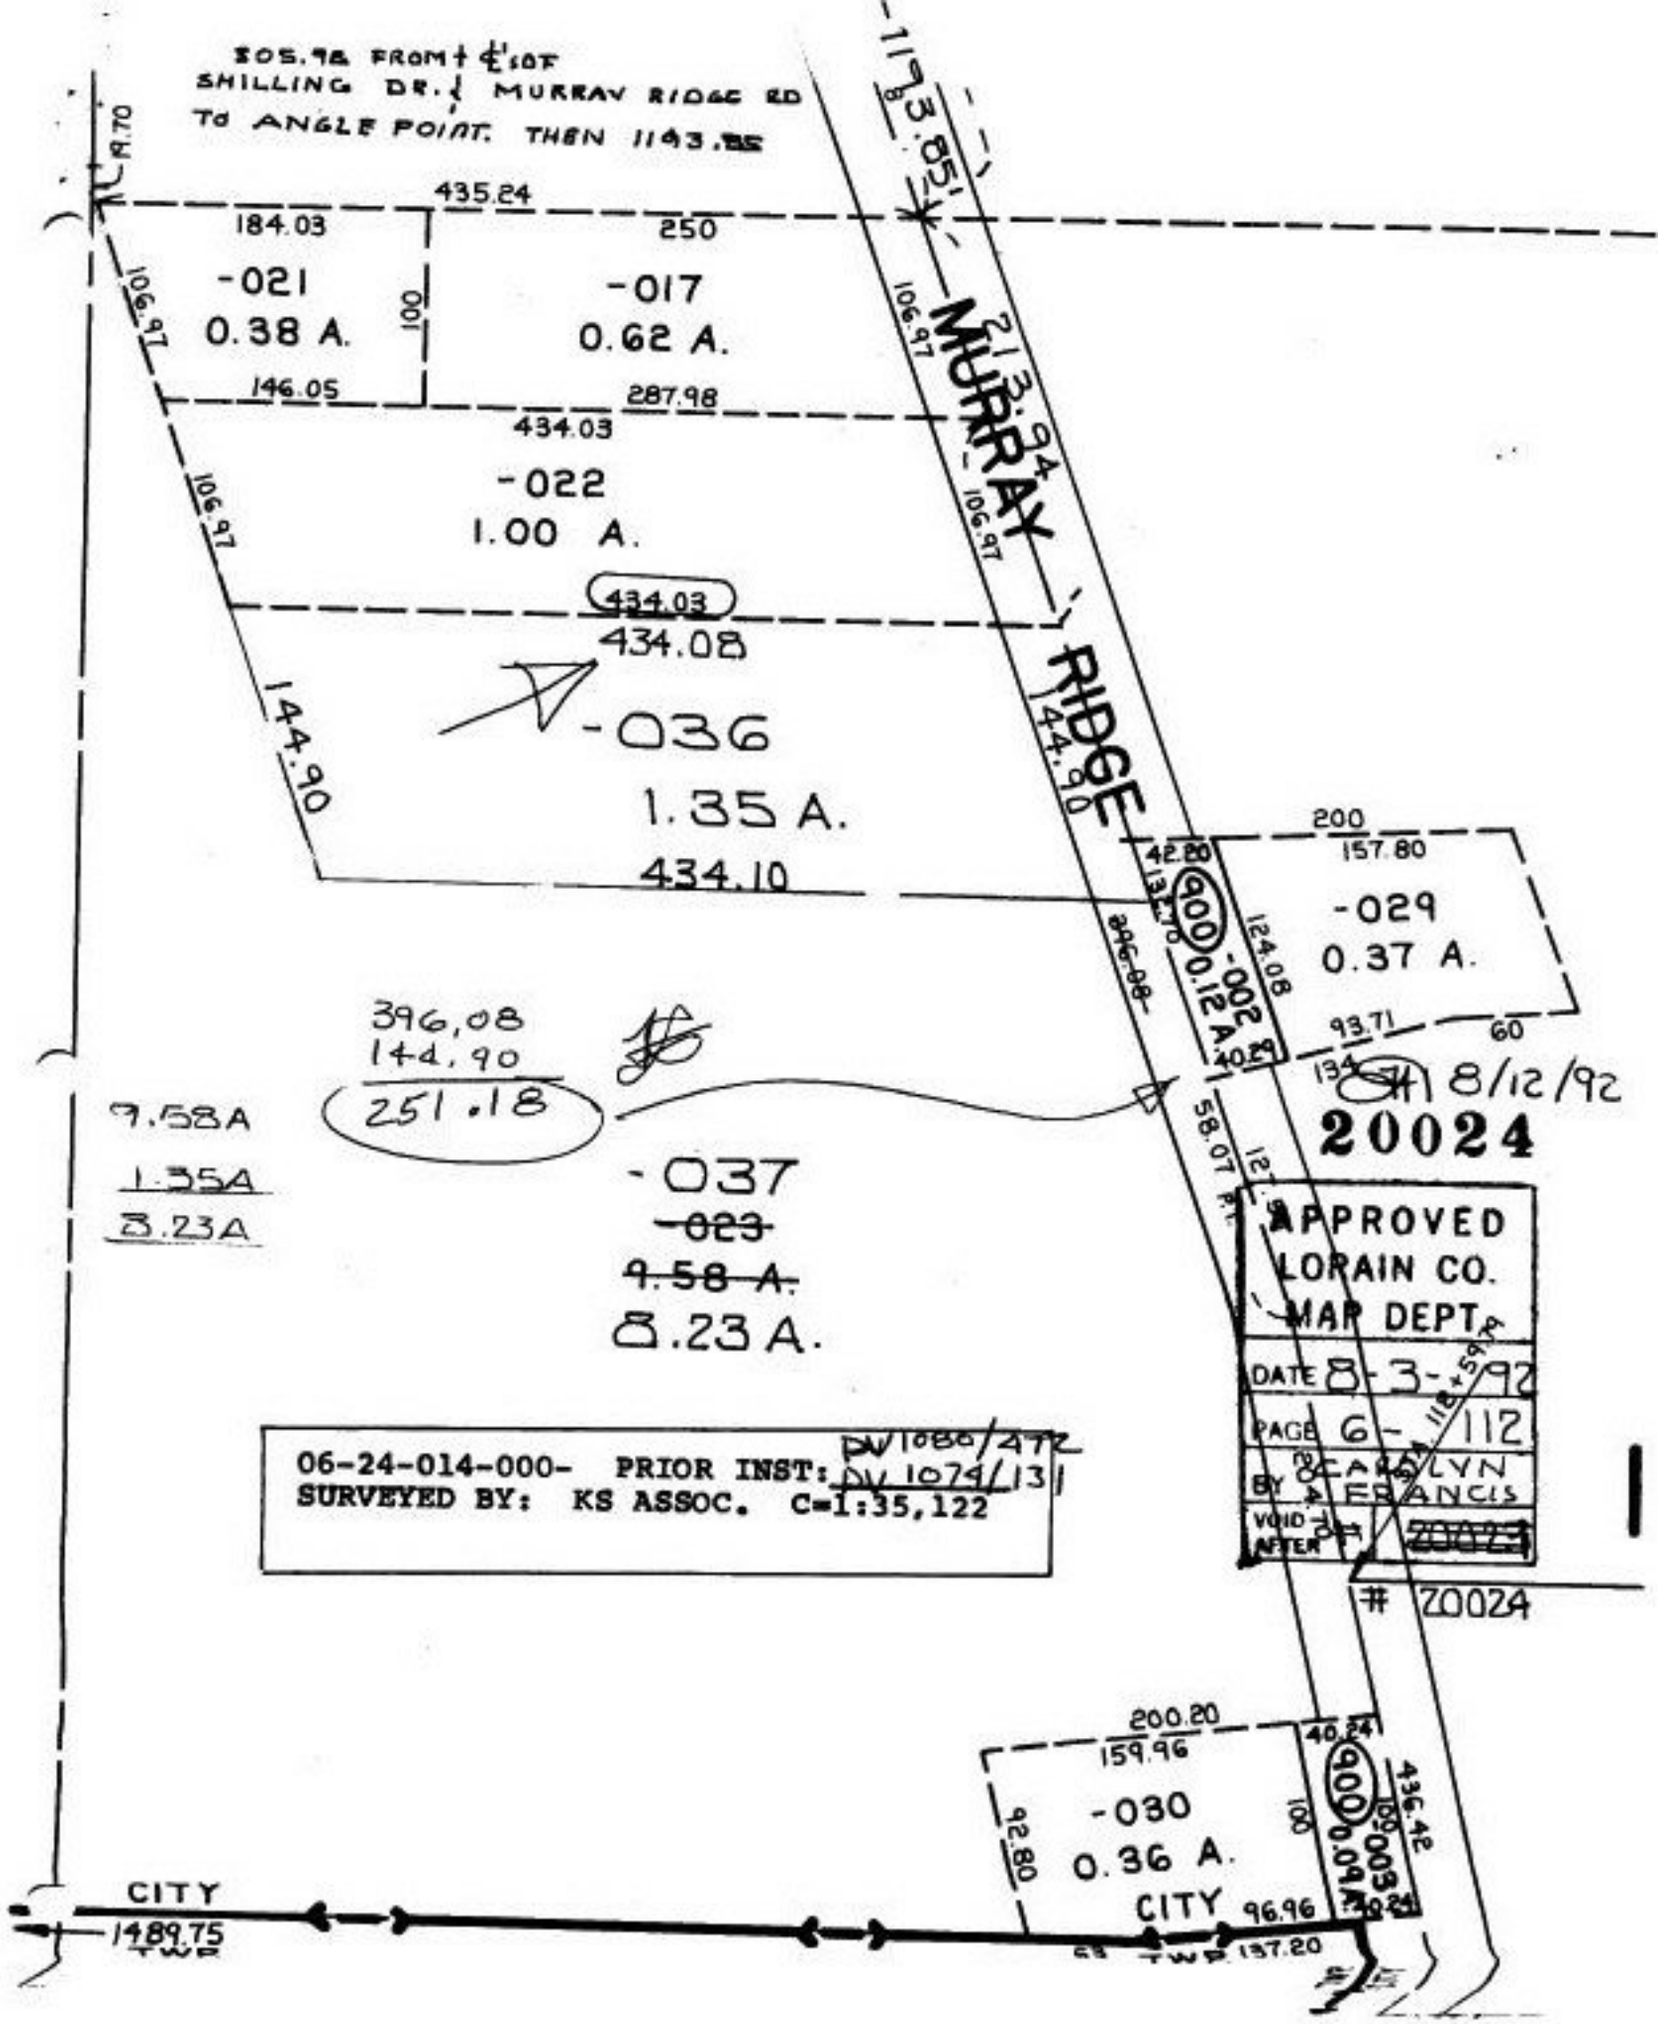
1143.85'
MURRAY RIDGE
106.97
435.24
184.03
250
-021
0.38 A.
-017
0.62 A.
100
146.05
287.98
434.03
-022
1.00 A.
434.03
434.08
144.90
-036
1.35 A.
434.10
200
157.80
42.80
132.70
900
-002
0.12 A.
-029
0.37 A.
124.08
93.71
60
40.24
396.08
144.90
251.18
9.58A
1.35A
8.23A
-037
-023
9.58 A.
8.23 A.
58.07 P.T.
APPROVED
LORAIN CO.
MAP DEPT.
DATE 8-3-92
PAGE 6-112
BY CAROLYN FRANCIS
VOID AFTER 2 YRS
8/12/92
20024
20024
06-24-014-000- PRIOR INST: DV 1086/472
SURVEYED BY: KS ASSOC. C=1:35,122
DV 1074/131
200.20
159.96
-030
0.36 A.
92.80
100
436.42
900
003
0.09 A.
CITY
1489.75
TWP
CITY
96.96
137.20
TWP