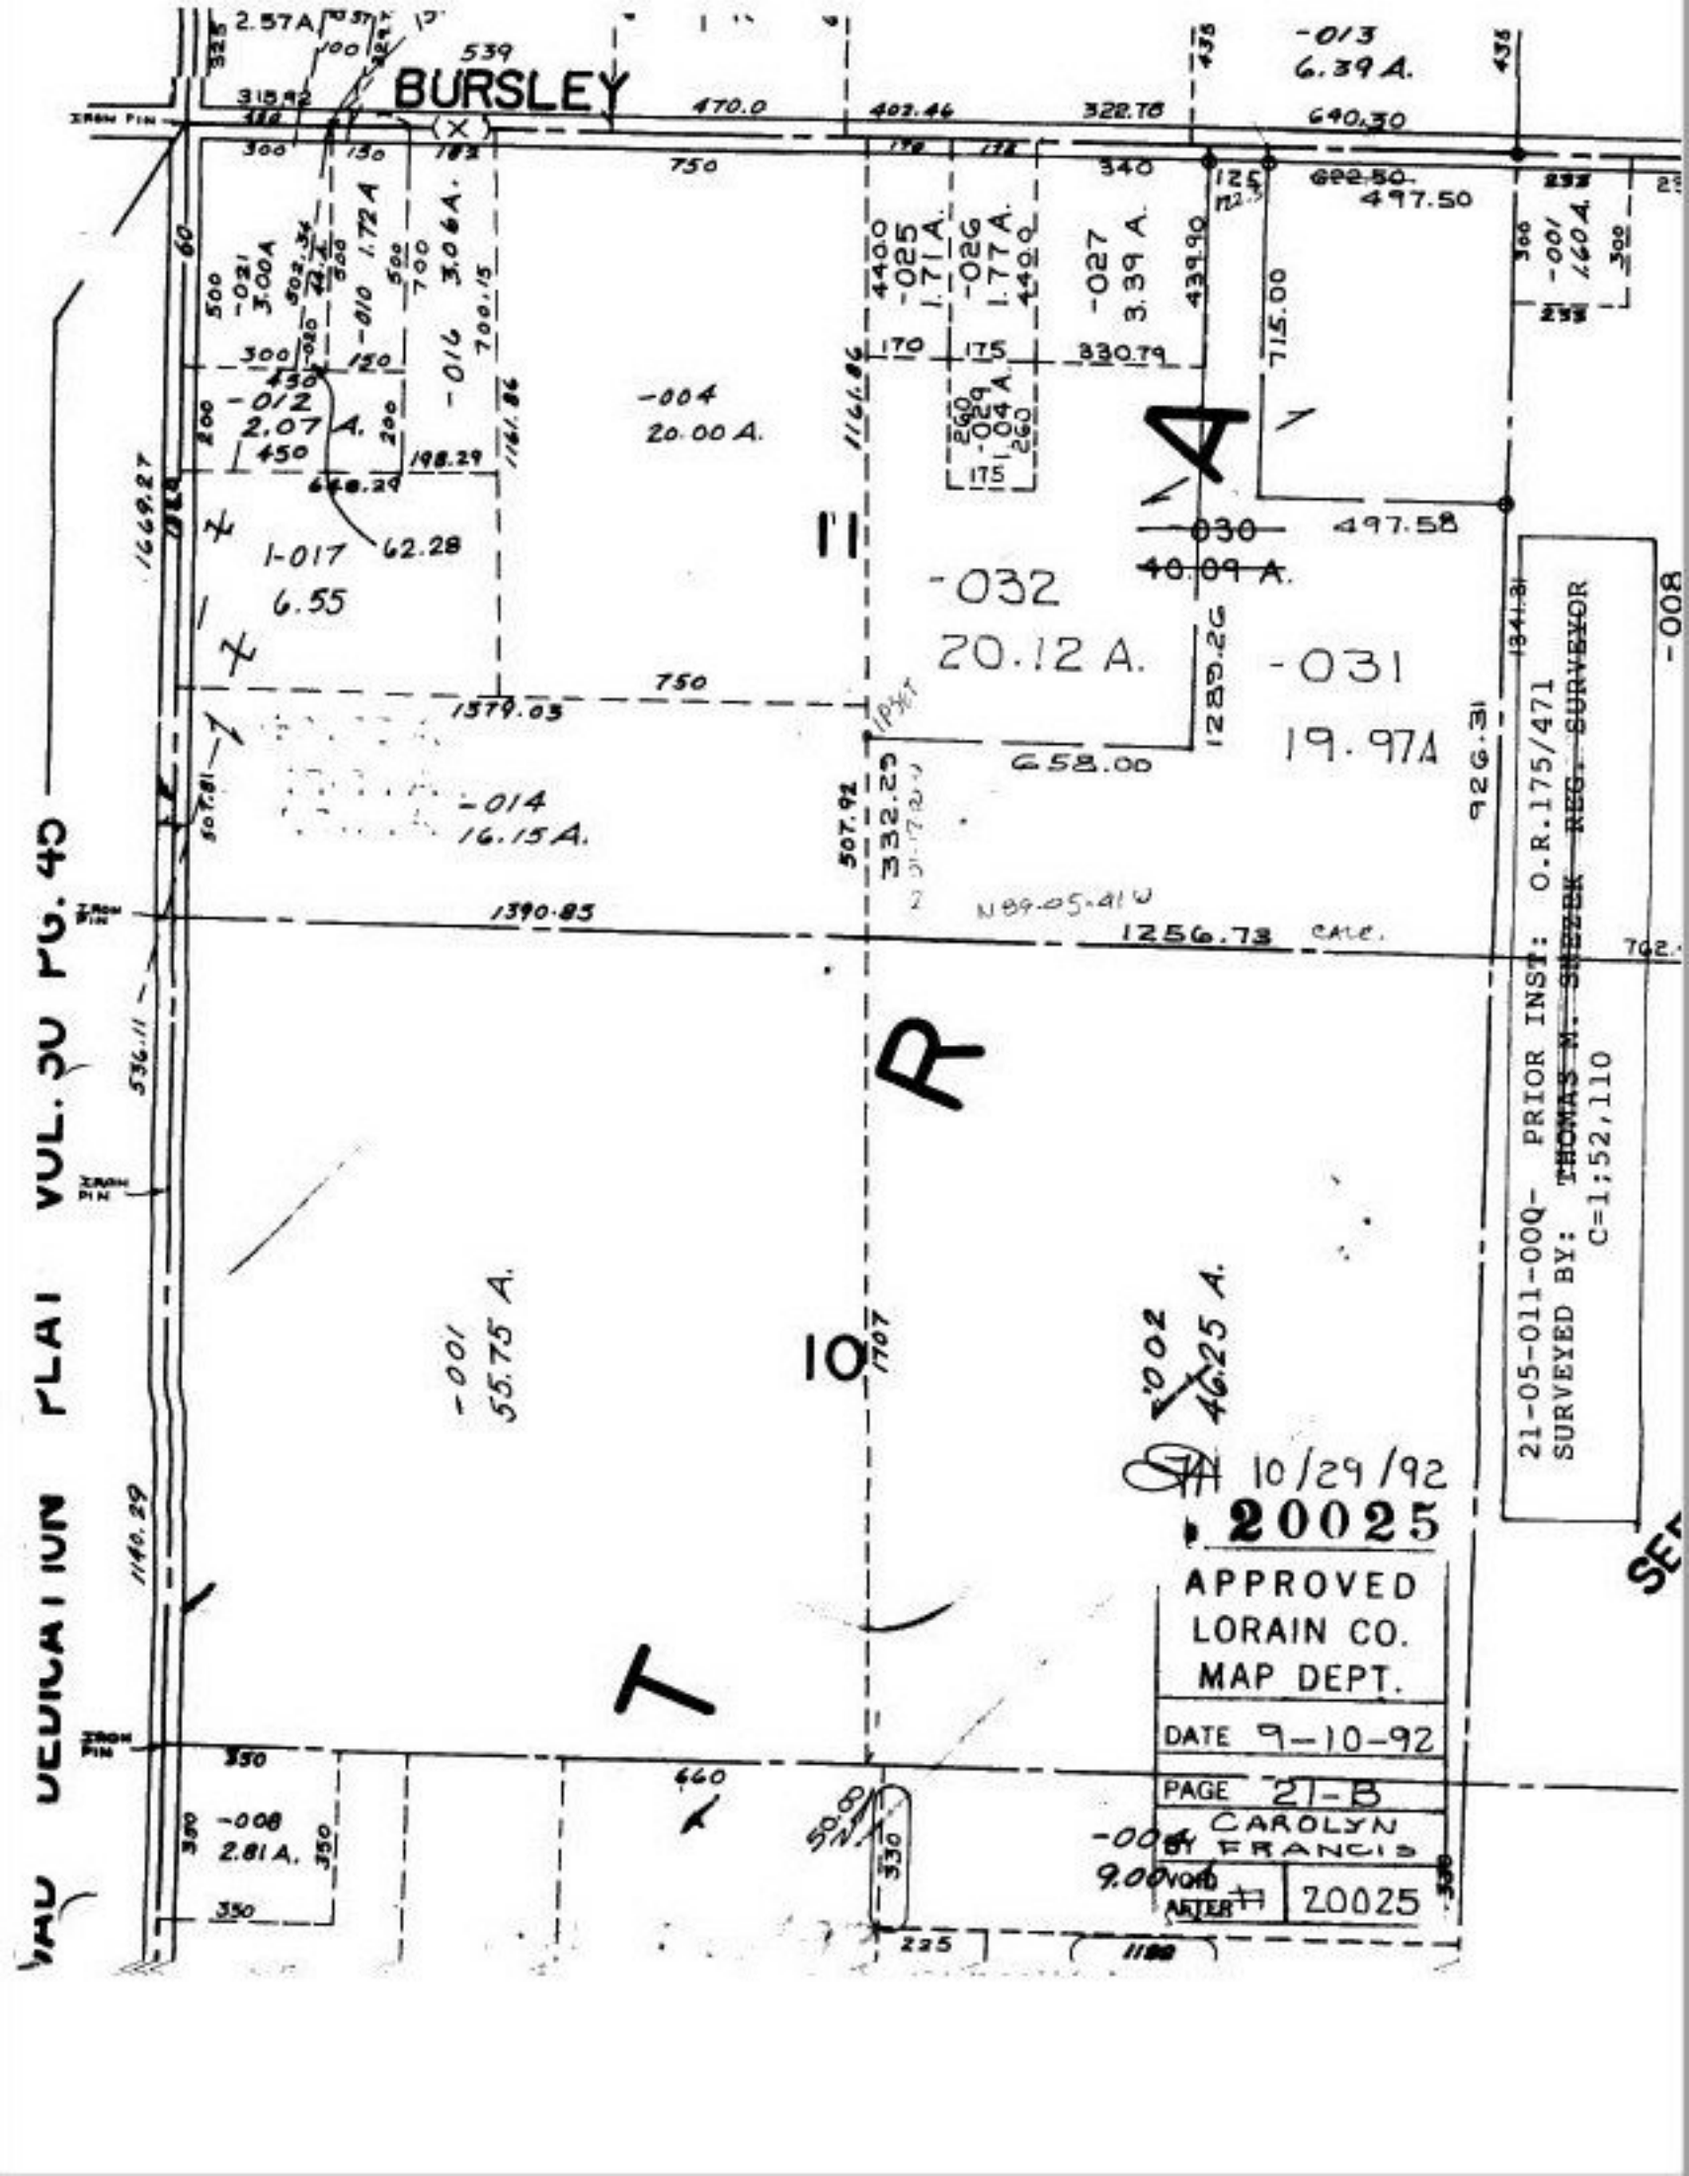
BURSLEY
2.57A
539
-013
6.39 A.
470.0
402.46
322.76
640.30
497.50
-021
3.00A
-010
1.72A
-016
3.06A.
-025
1.71 A.
-026
1.77 A.
-027
3.39 A.
715.00
-001
1.60A.
-012
2.07 A.
-004
20.00 A.
1-017
6.55
62.28
198.29
1579.03
-014
16.15 A.
-032
20.12 A.
-031
19.97A
497.58
40.09 A.
658.00
1289.26
926.31
1390.85
1256.73 CALC.
-001
55.75 A.
-002
46.25 A.
-008
2.81 A.
9.00
10/29/92
20025
APPROVED
LORAIN CO.
MAP DEPT.
DATE 9-10-92
PAGE 21-B
BY CAROLYN FRANCIS
VOID AFTER 20025
21-05-011-000- PRIOR INST: O.R.175/471
SURVEYED BY: THOMAS M. SHEPPARD REG. SURVEYOR
C=1;52,110
VAU VEDUCAI ION PLAI VUL. 30 PG. 45
R
T
10