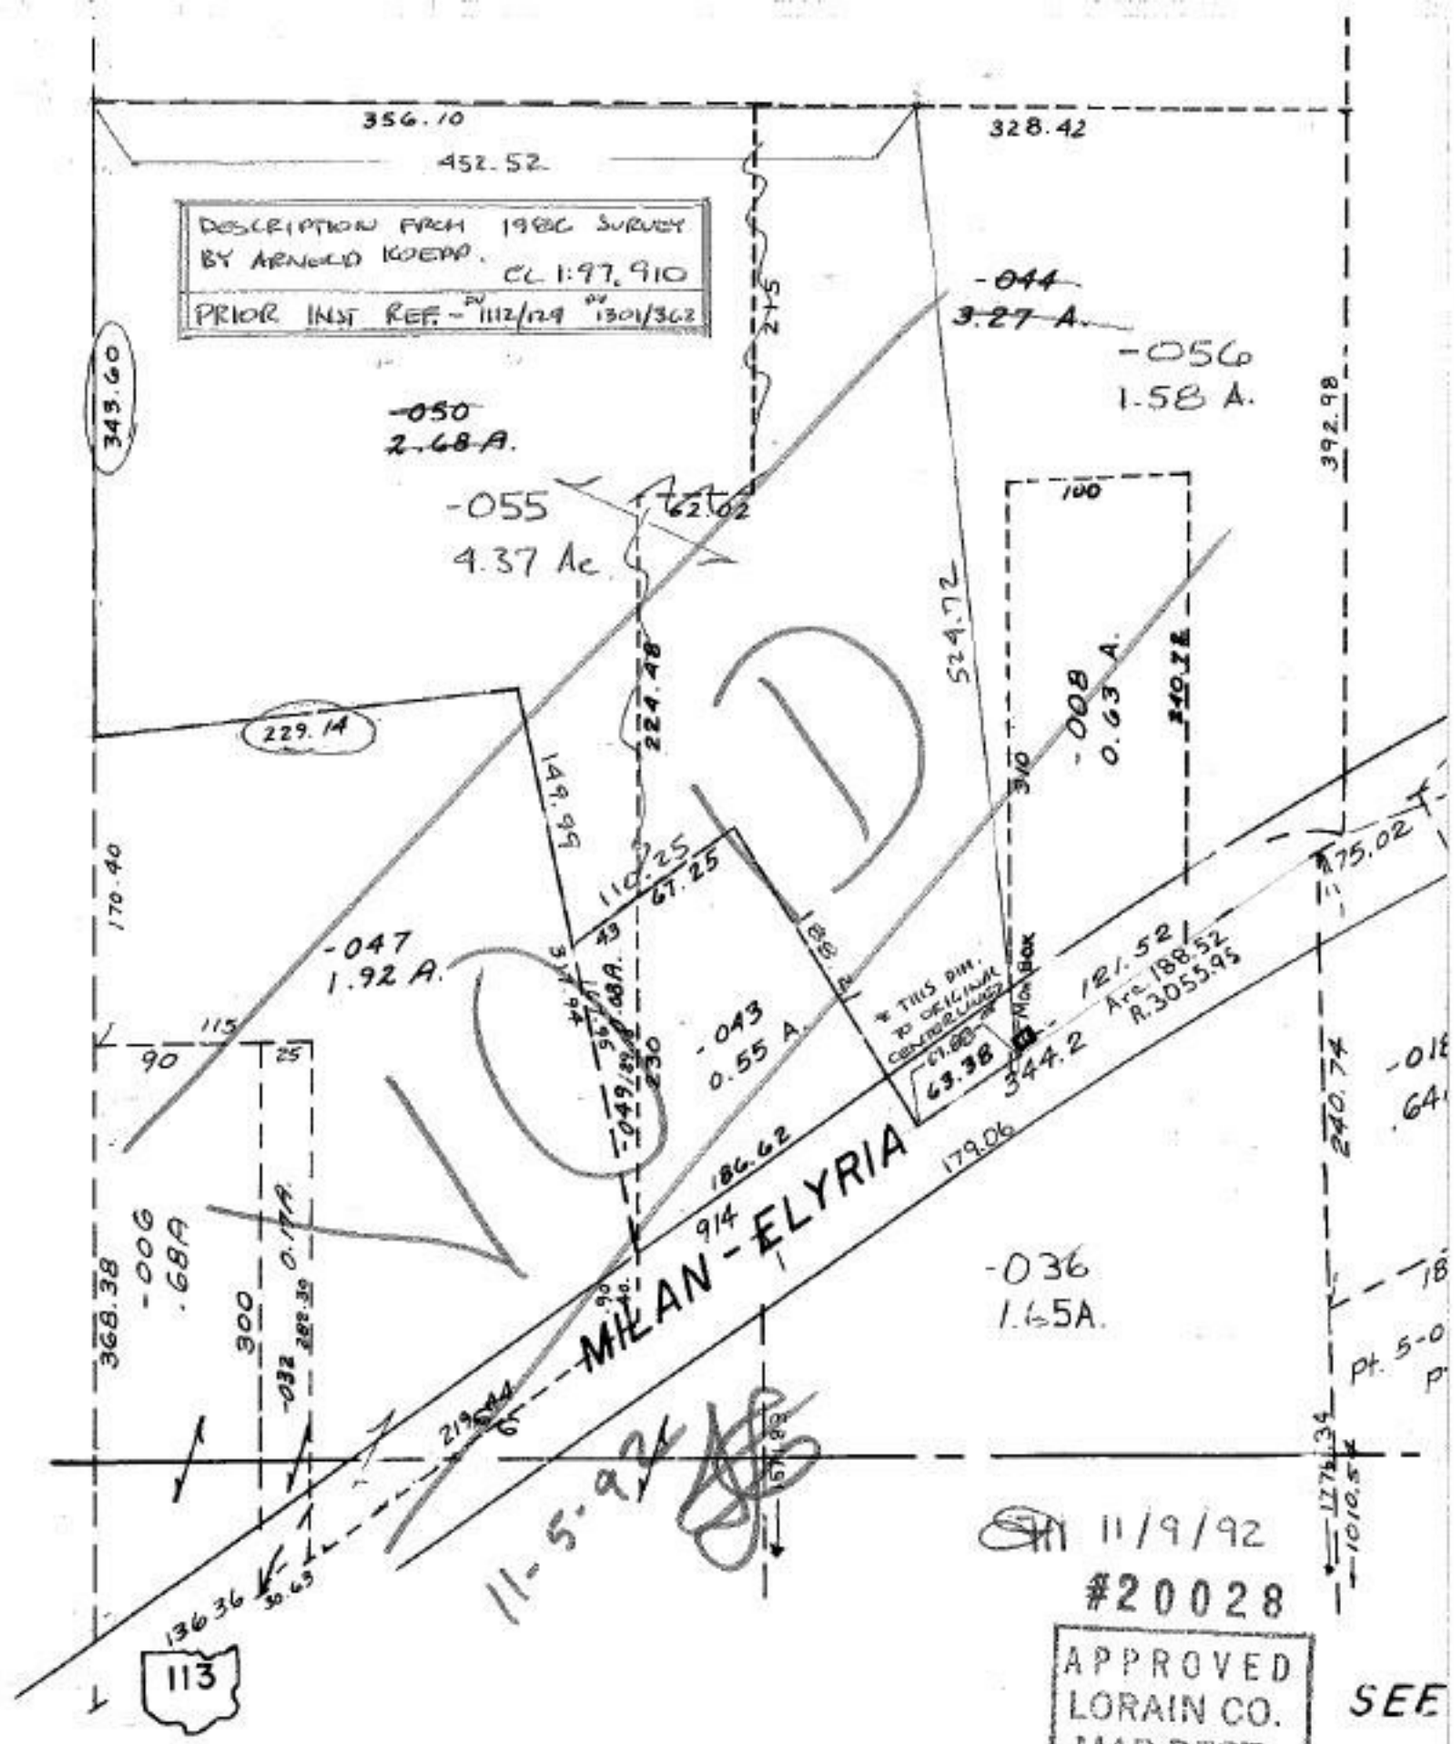
356.10
452.52
328.42
DESCRIPTION FROM 1986 SURVEY BY ARNOLD KOEPP. CL 1:97,910
PRIOR INST REF. - DV 1112/129 DV 1301/362
-044
3.27 A.
-056
1.58 A.
-050
2.68 A.
343.60
-055
4.37 Ac.
162.02
392.98
100
524.72
224.48
229.14
149.99
110.25
67.25
-008
0.63 A.
340.18
310
170.40
-047
1.92 A.
113
90
25
-043
0.55 A.
* THIS PIN. TO ORIGINAL CENTER LINE
61.88
63.38
344.2
121.52
Arc 188.52
R.3055.93
275.02
240.74
-036
1.65A.
MILAN - ELYRIA
368.38
-006
.689
300
-032
0.17A.
288.30
186.62
914
179.06
219.44
136.36
30.63
113
11-5-92
11/9/92
#20028
APPROVED
LORAIN CO.
MAP DEPT.
DATE 8-17-92
PAGE 5-00-033-B
BY T. McMain
VOID AFTER 20028
SEE