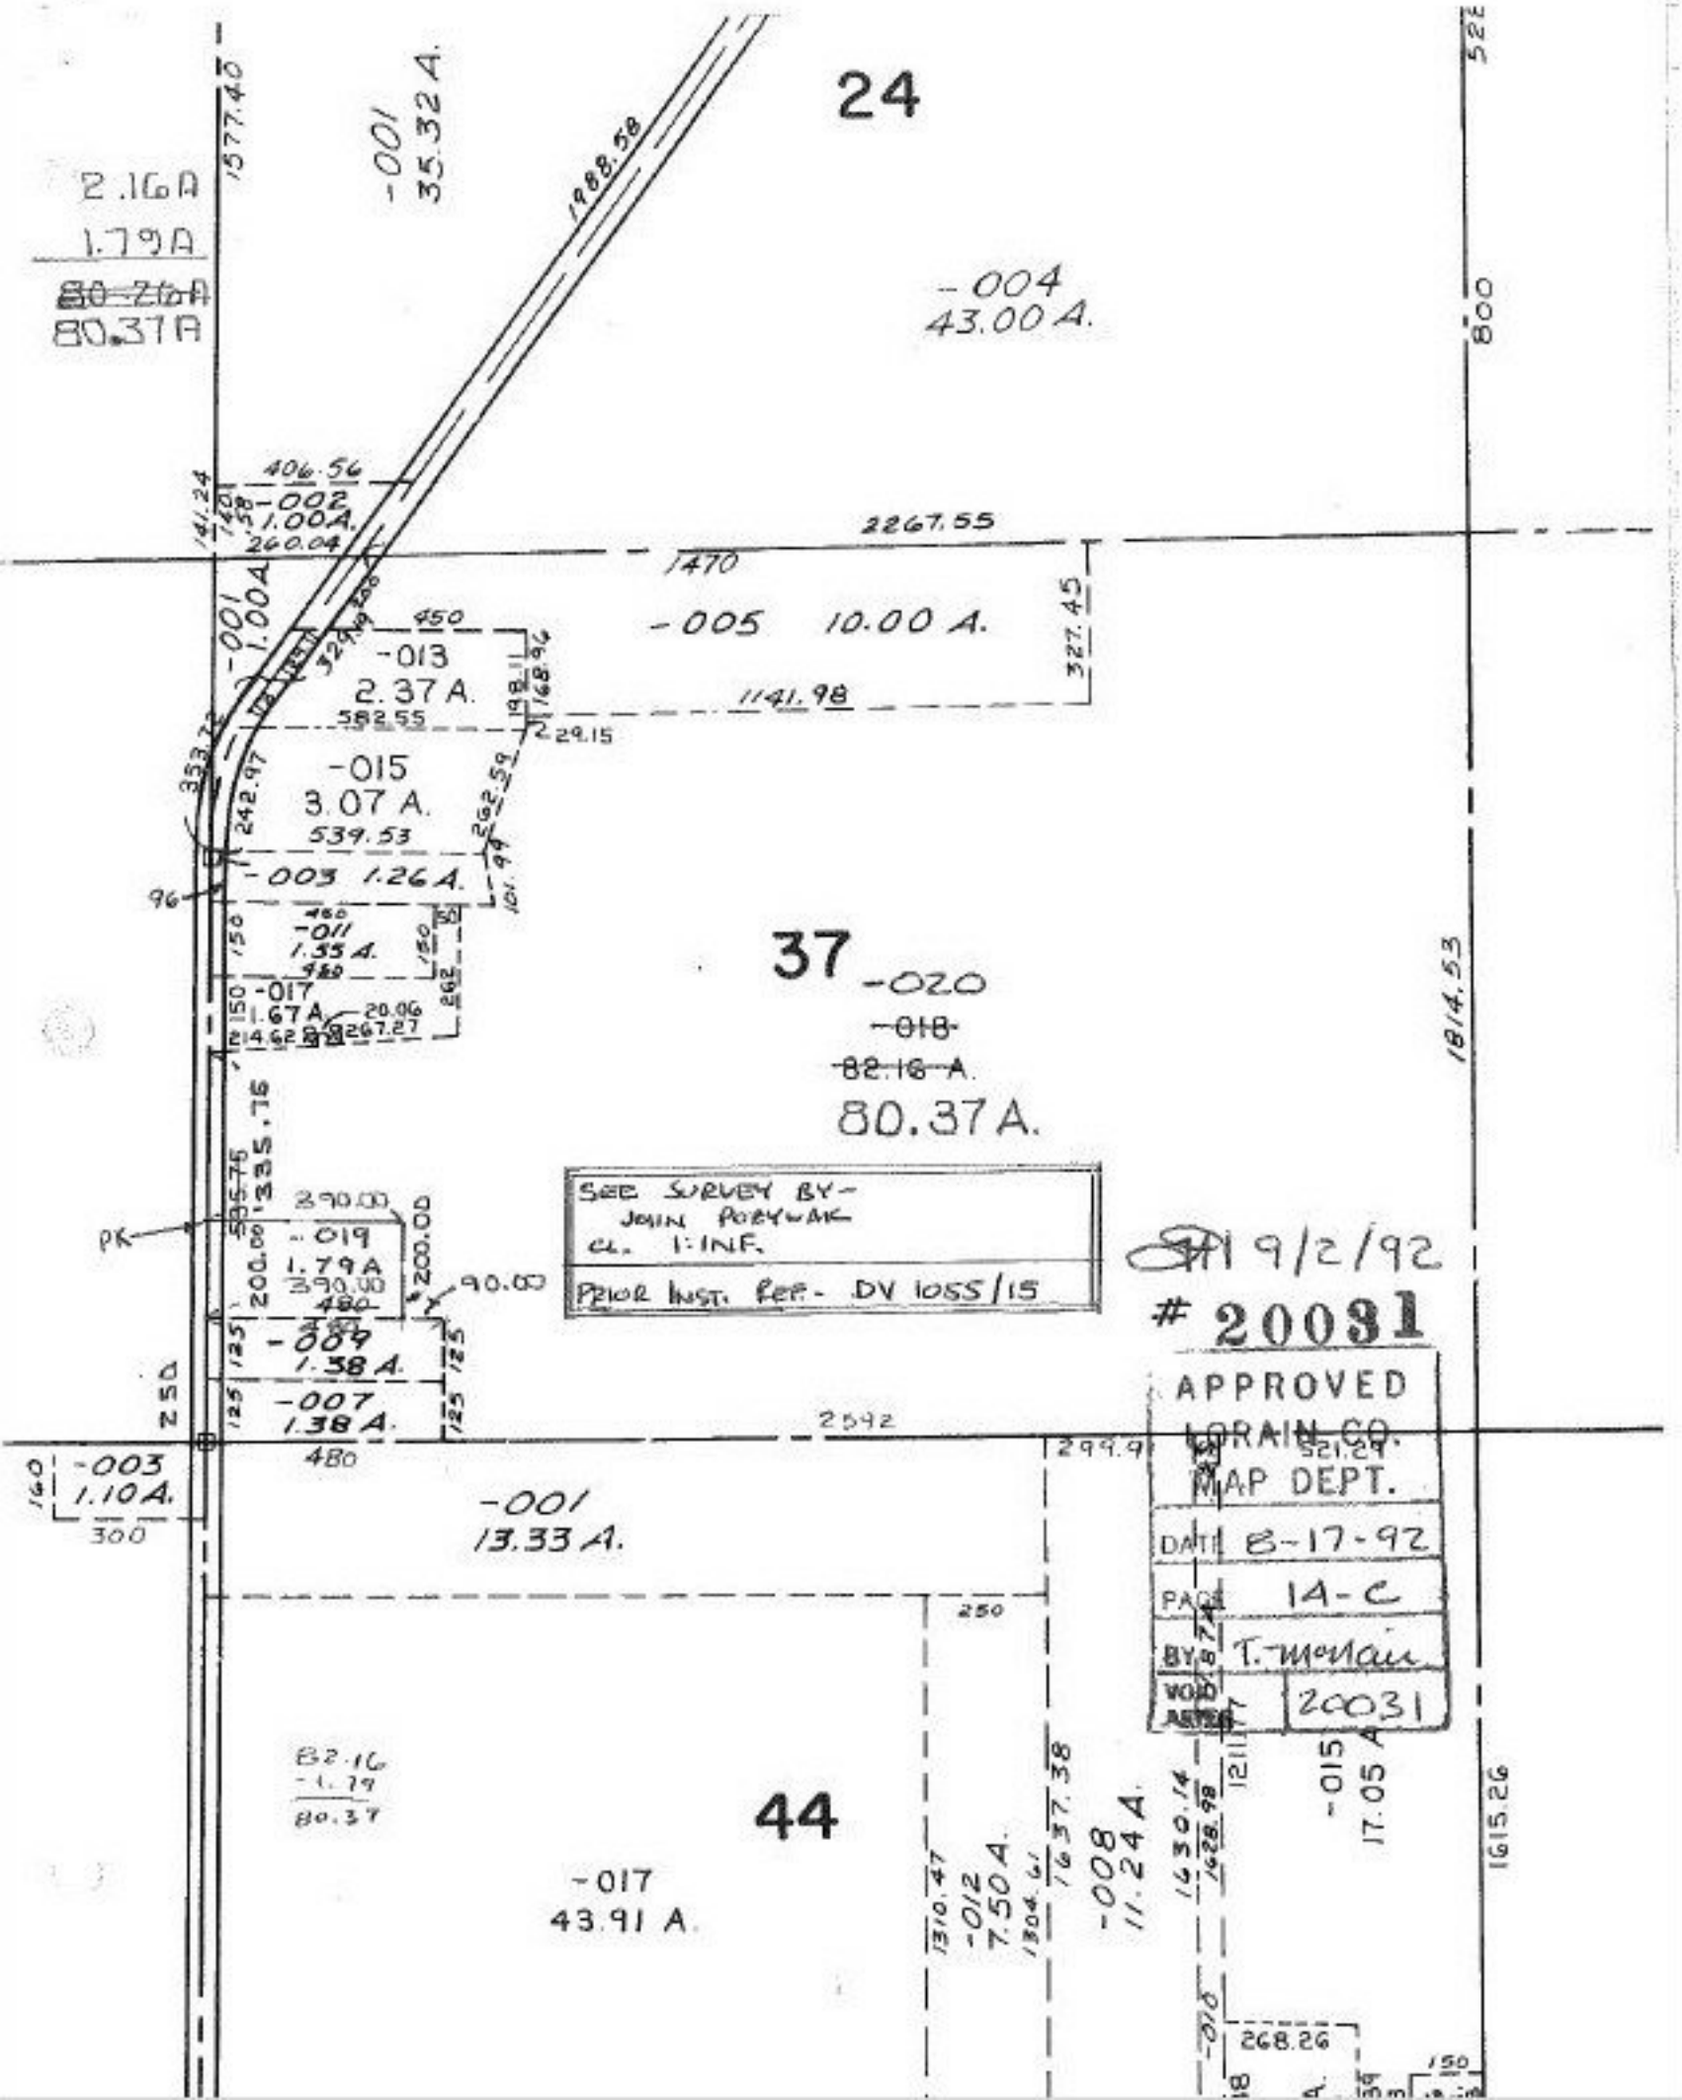
24
2.16 A
1.79 A
~~80.21 A~~
80.37 A
-001
35.32 A.
1577.40
1988.58
-004
43.00 A.
522
800
406.56
-002
1.00 A.
260.04
141.24
2267.55
1470
-001
1.00 A.
-005 10.00 A.
327.45
450
-013
2.37 A.
582.55
1141.98
-015
3.07 A.
539.53
242.97
-003 1.26 A.
96
-011
1.35 A.
-017
1.67 A
37
-020
~~-018~~
~~82.16 A.~~
80.37 A.
1814.53
SEE SURVEY BY-
JOHN POLYWAK
CL. 1:INF.
PRIOR INST. REF.- DV 1055/15
9/2/92
20031
APPROVED
LORAIN CO.
MAP DEPT.
DATE 8-17-92
PAGE 14-C
BY T. McNair
-019
1.79 A
390.00
200.00
-009
1.38 A.
-007
1.38 A.
480
250
2542
299.9
521.29
-003
1.10 A.
300
-001
13.33 A.
82.16
-1.79
80.37
44
-017
43.91 A.
1310.47
-012
7.50 A.
1637.38
-008
11.24 A.
1430.14
1428.98
-015
17.05 A
1615.26
268.26