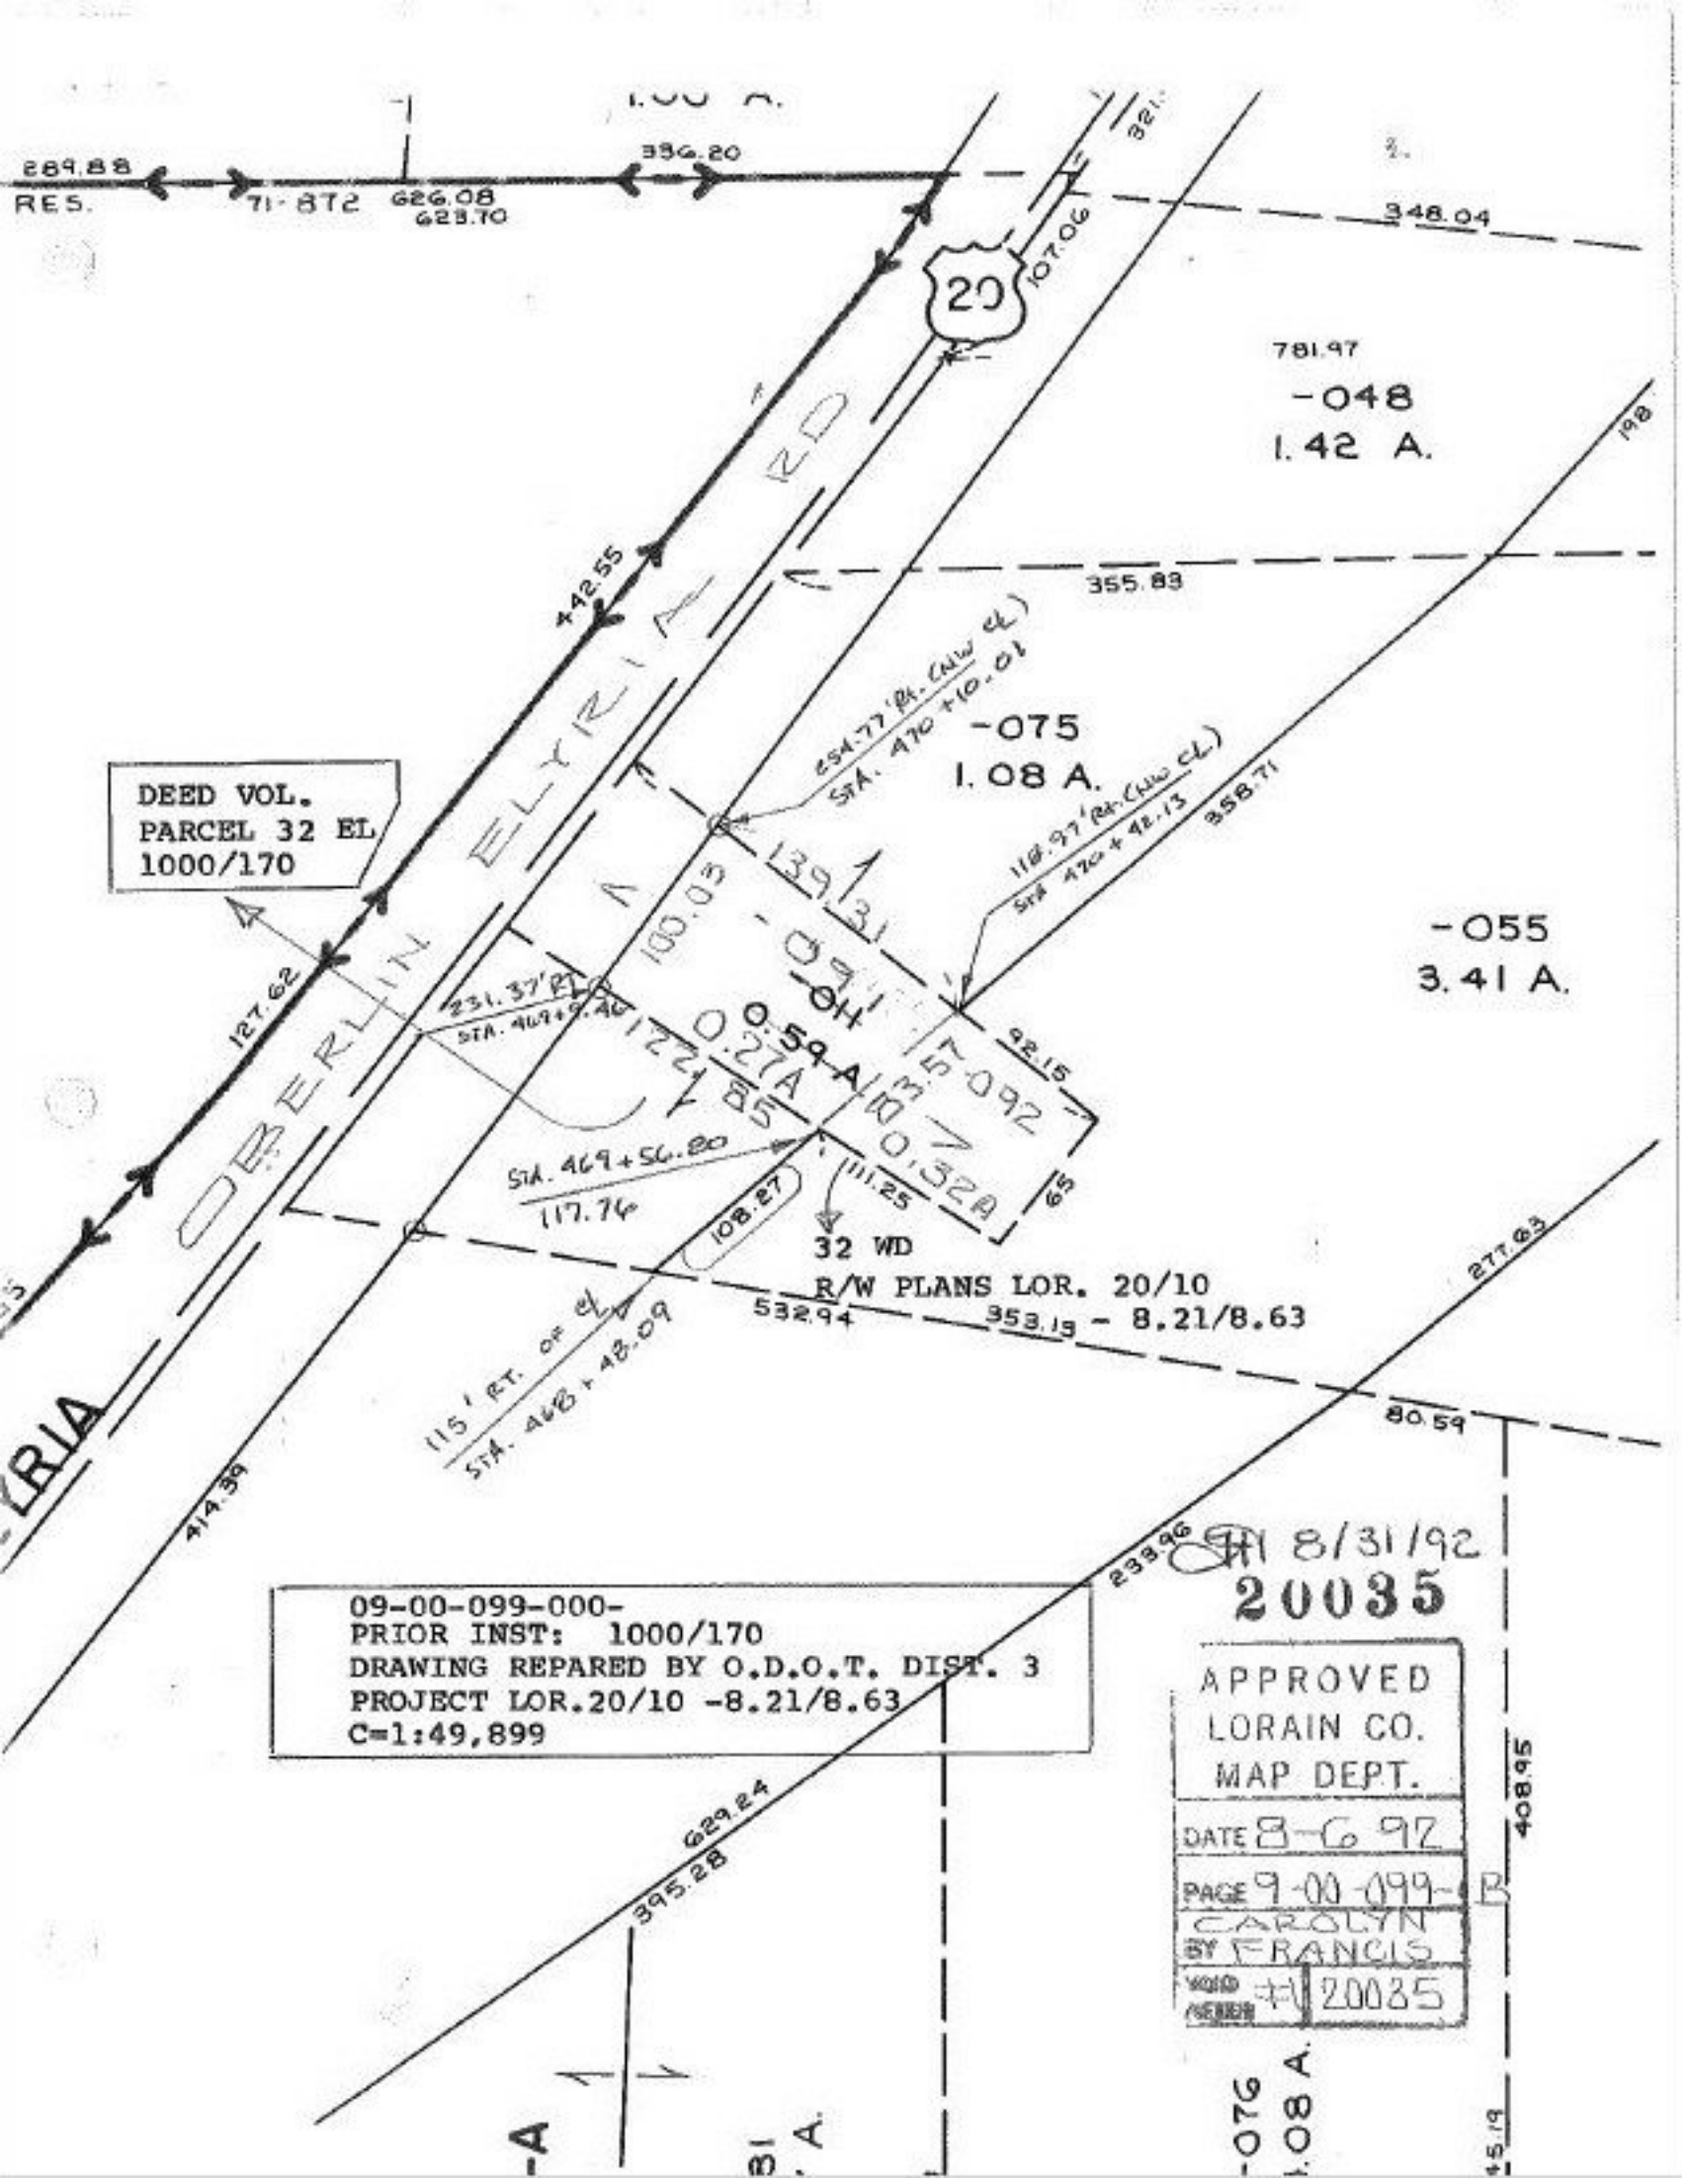

8/31/92
20035

APPROVED
LORAIN CO.
MAP DEPT.
DATE 8-6-92
PAGE 9-00-099-B
CAROLYN
BY FRANCIS
VOID #1 20035