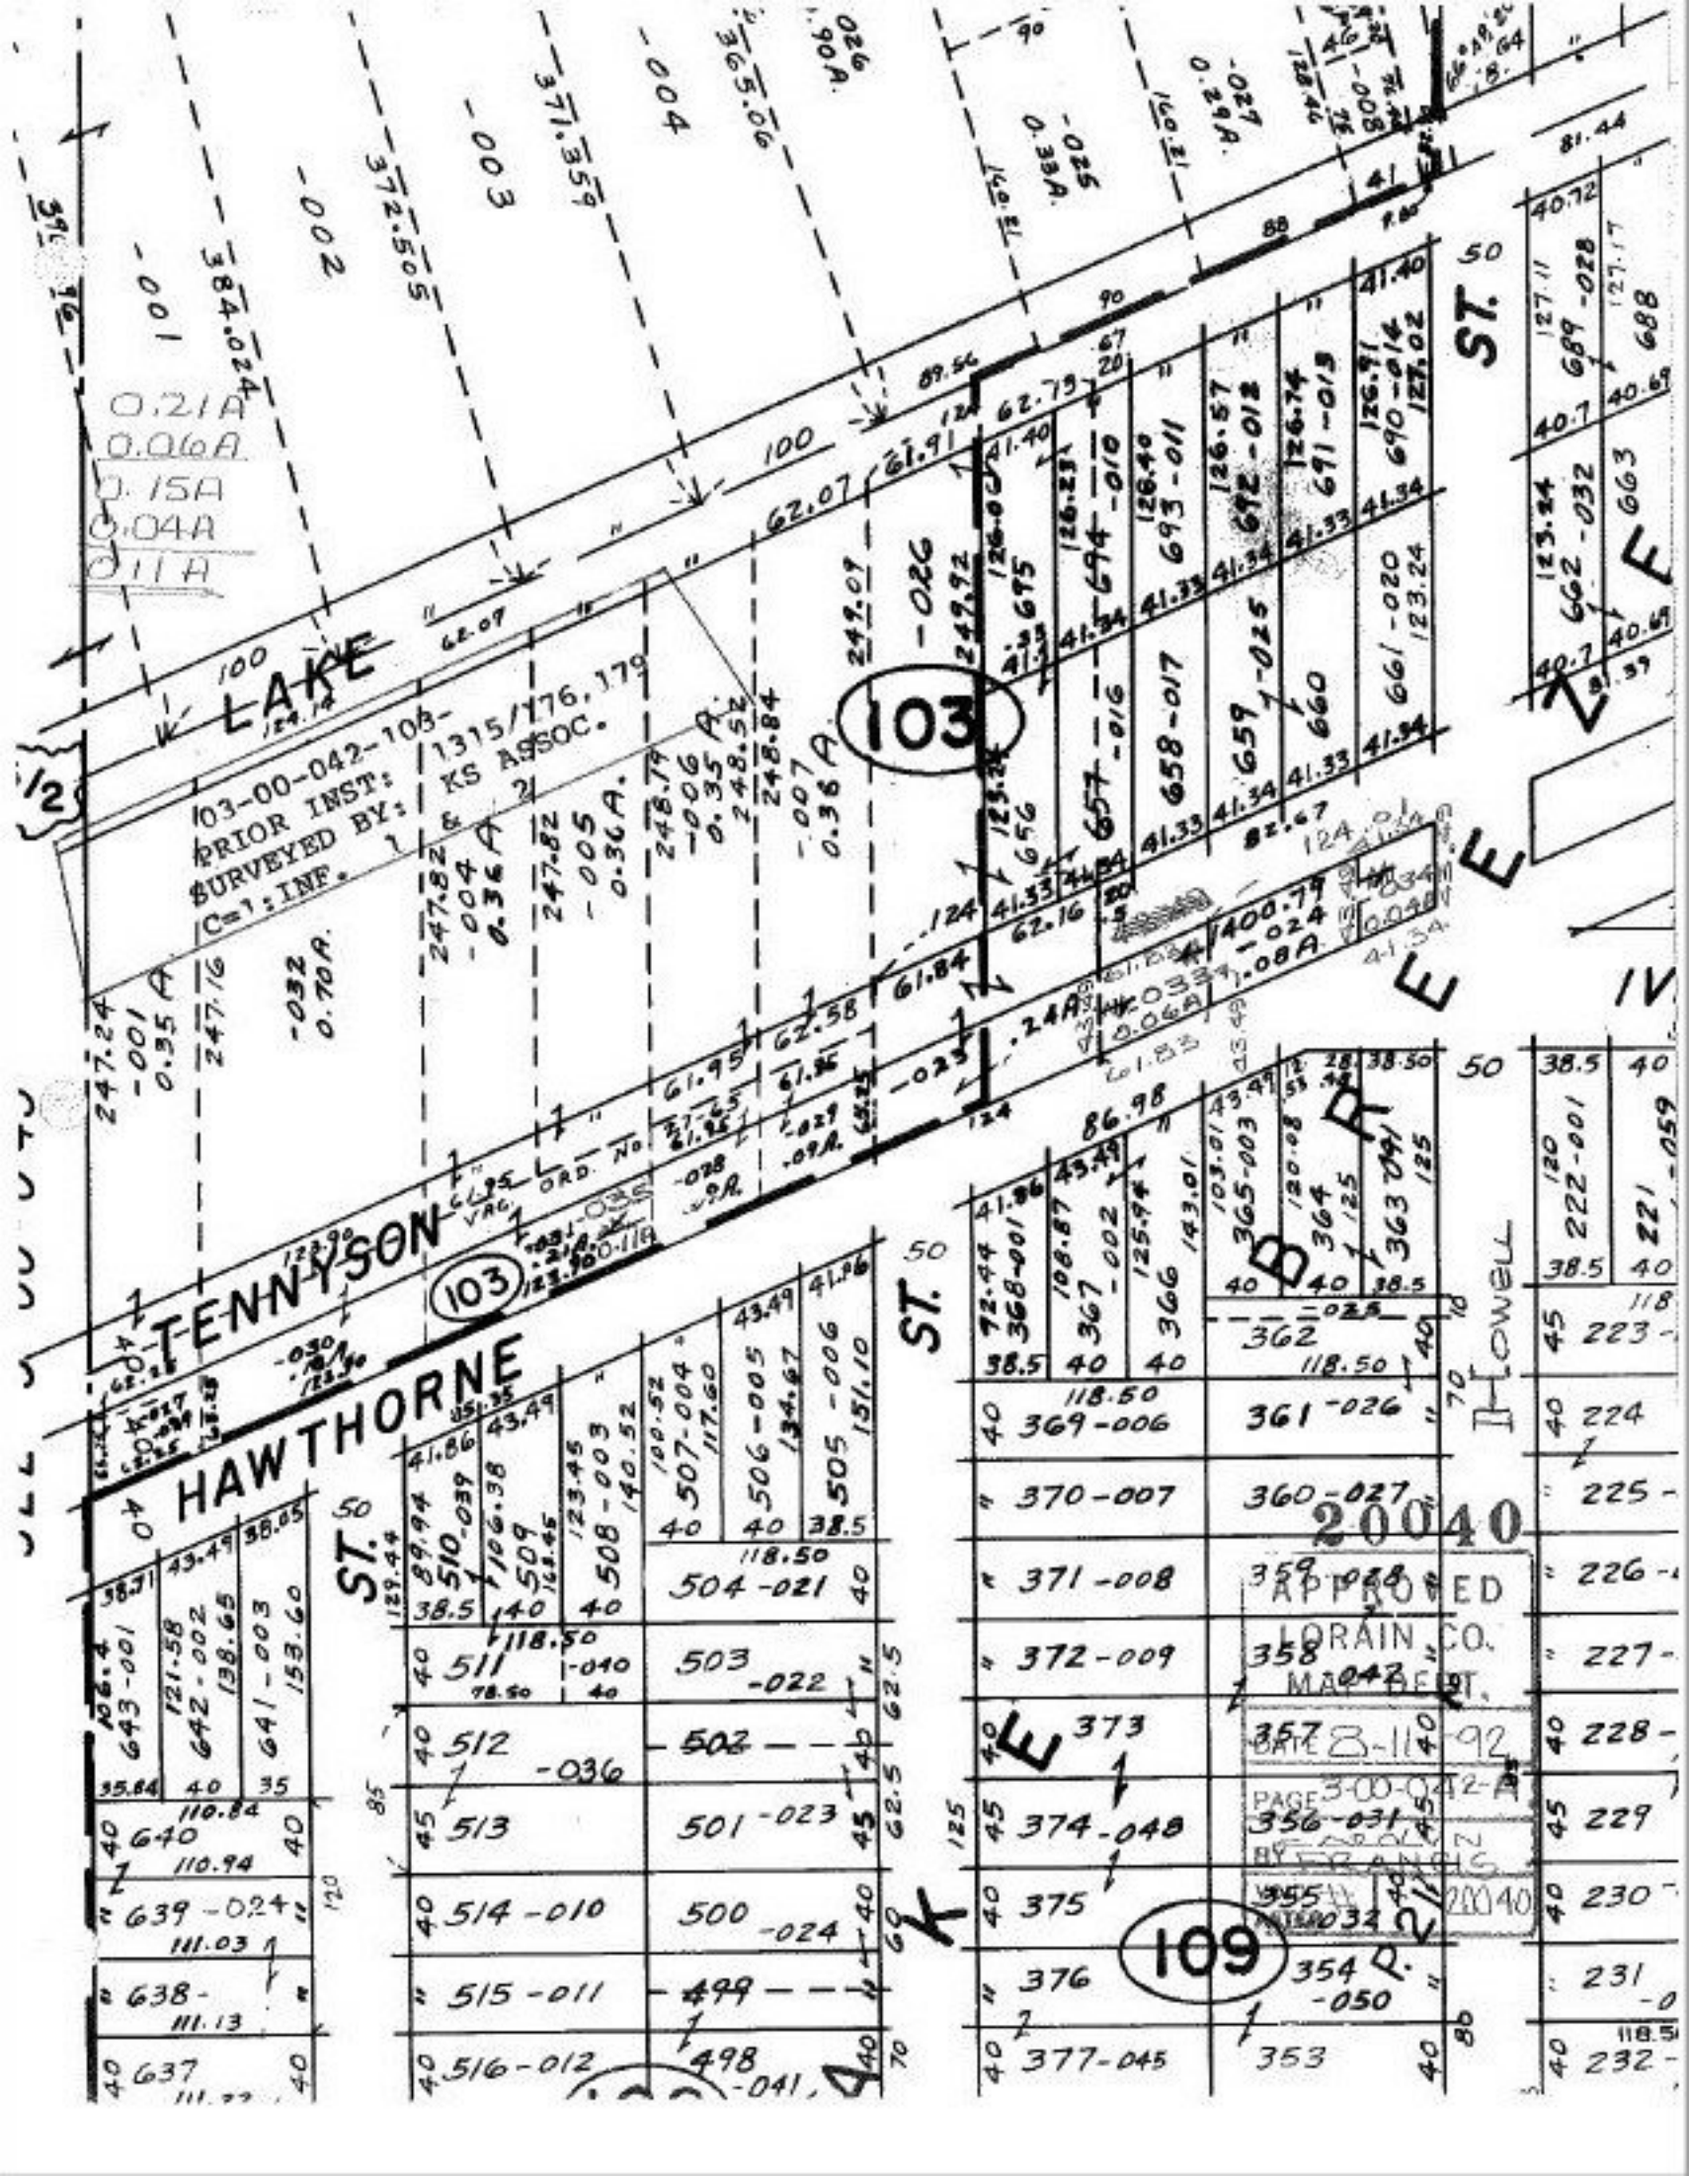
LAKE
TENNYSON
HAWTHORNE
ST.
103
109
103-00-042-108-
PRIOR INST: 1315/176, 179
SURVEYED BY: KS ASSOC.
C=1: INF. 1 2
0.21A
0.06A
0.15A
0.04A
0.11A
20040
APPROVED
LORAIN CO.
MAP DEPT.
DATE 8-11-92
PAGE 3-00-042-A
BY FRANCIS