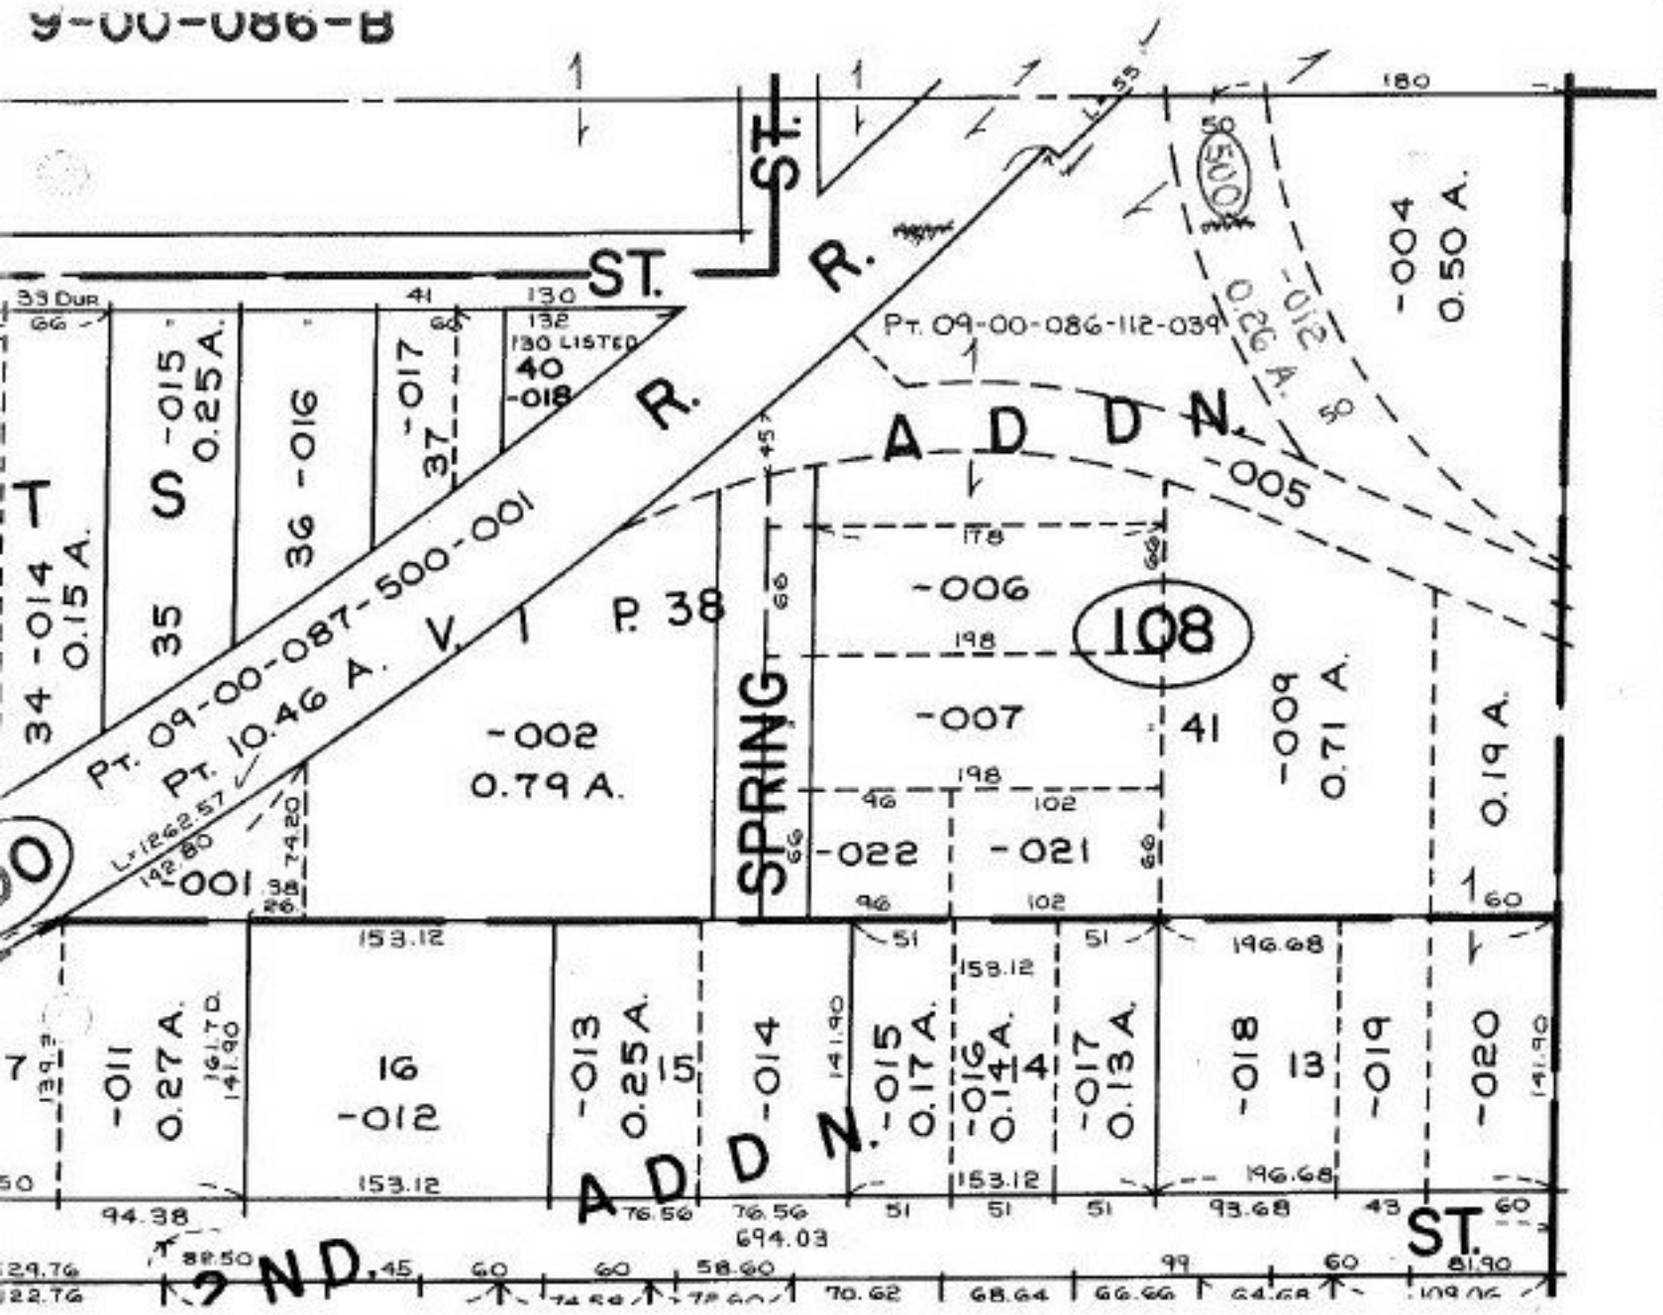

ADD TO DUPLICATE PER DEED VOL. 1198 PGS. 579-585 &
MAP DEPT. CALCULATION.

PARCEL SHOULD HAVE BEEN CREATED 2/16/78
PER SPLIT NO. 11399

8/31/92
#20043-A

APPROVED
LORAIN CO.
MAP DEPT.
DATE 8/11/92
PAGE 9-00-086-B
BY T. HOLLIS
VOID AFTER 20043-A