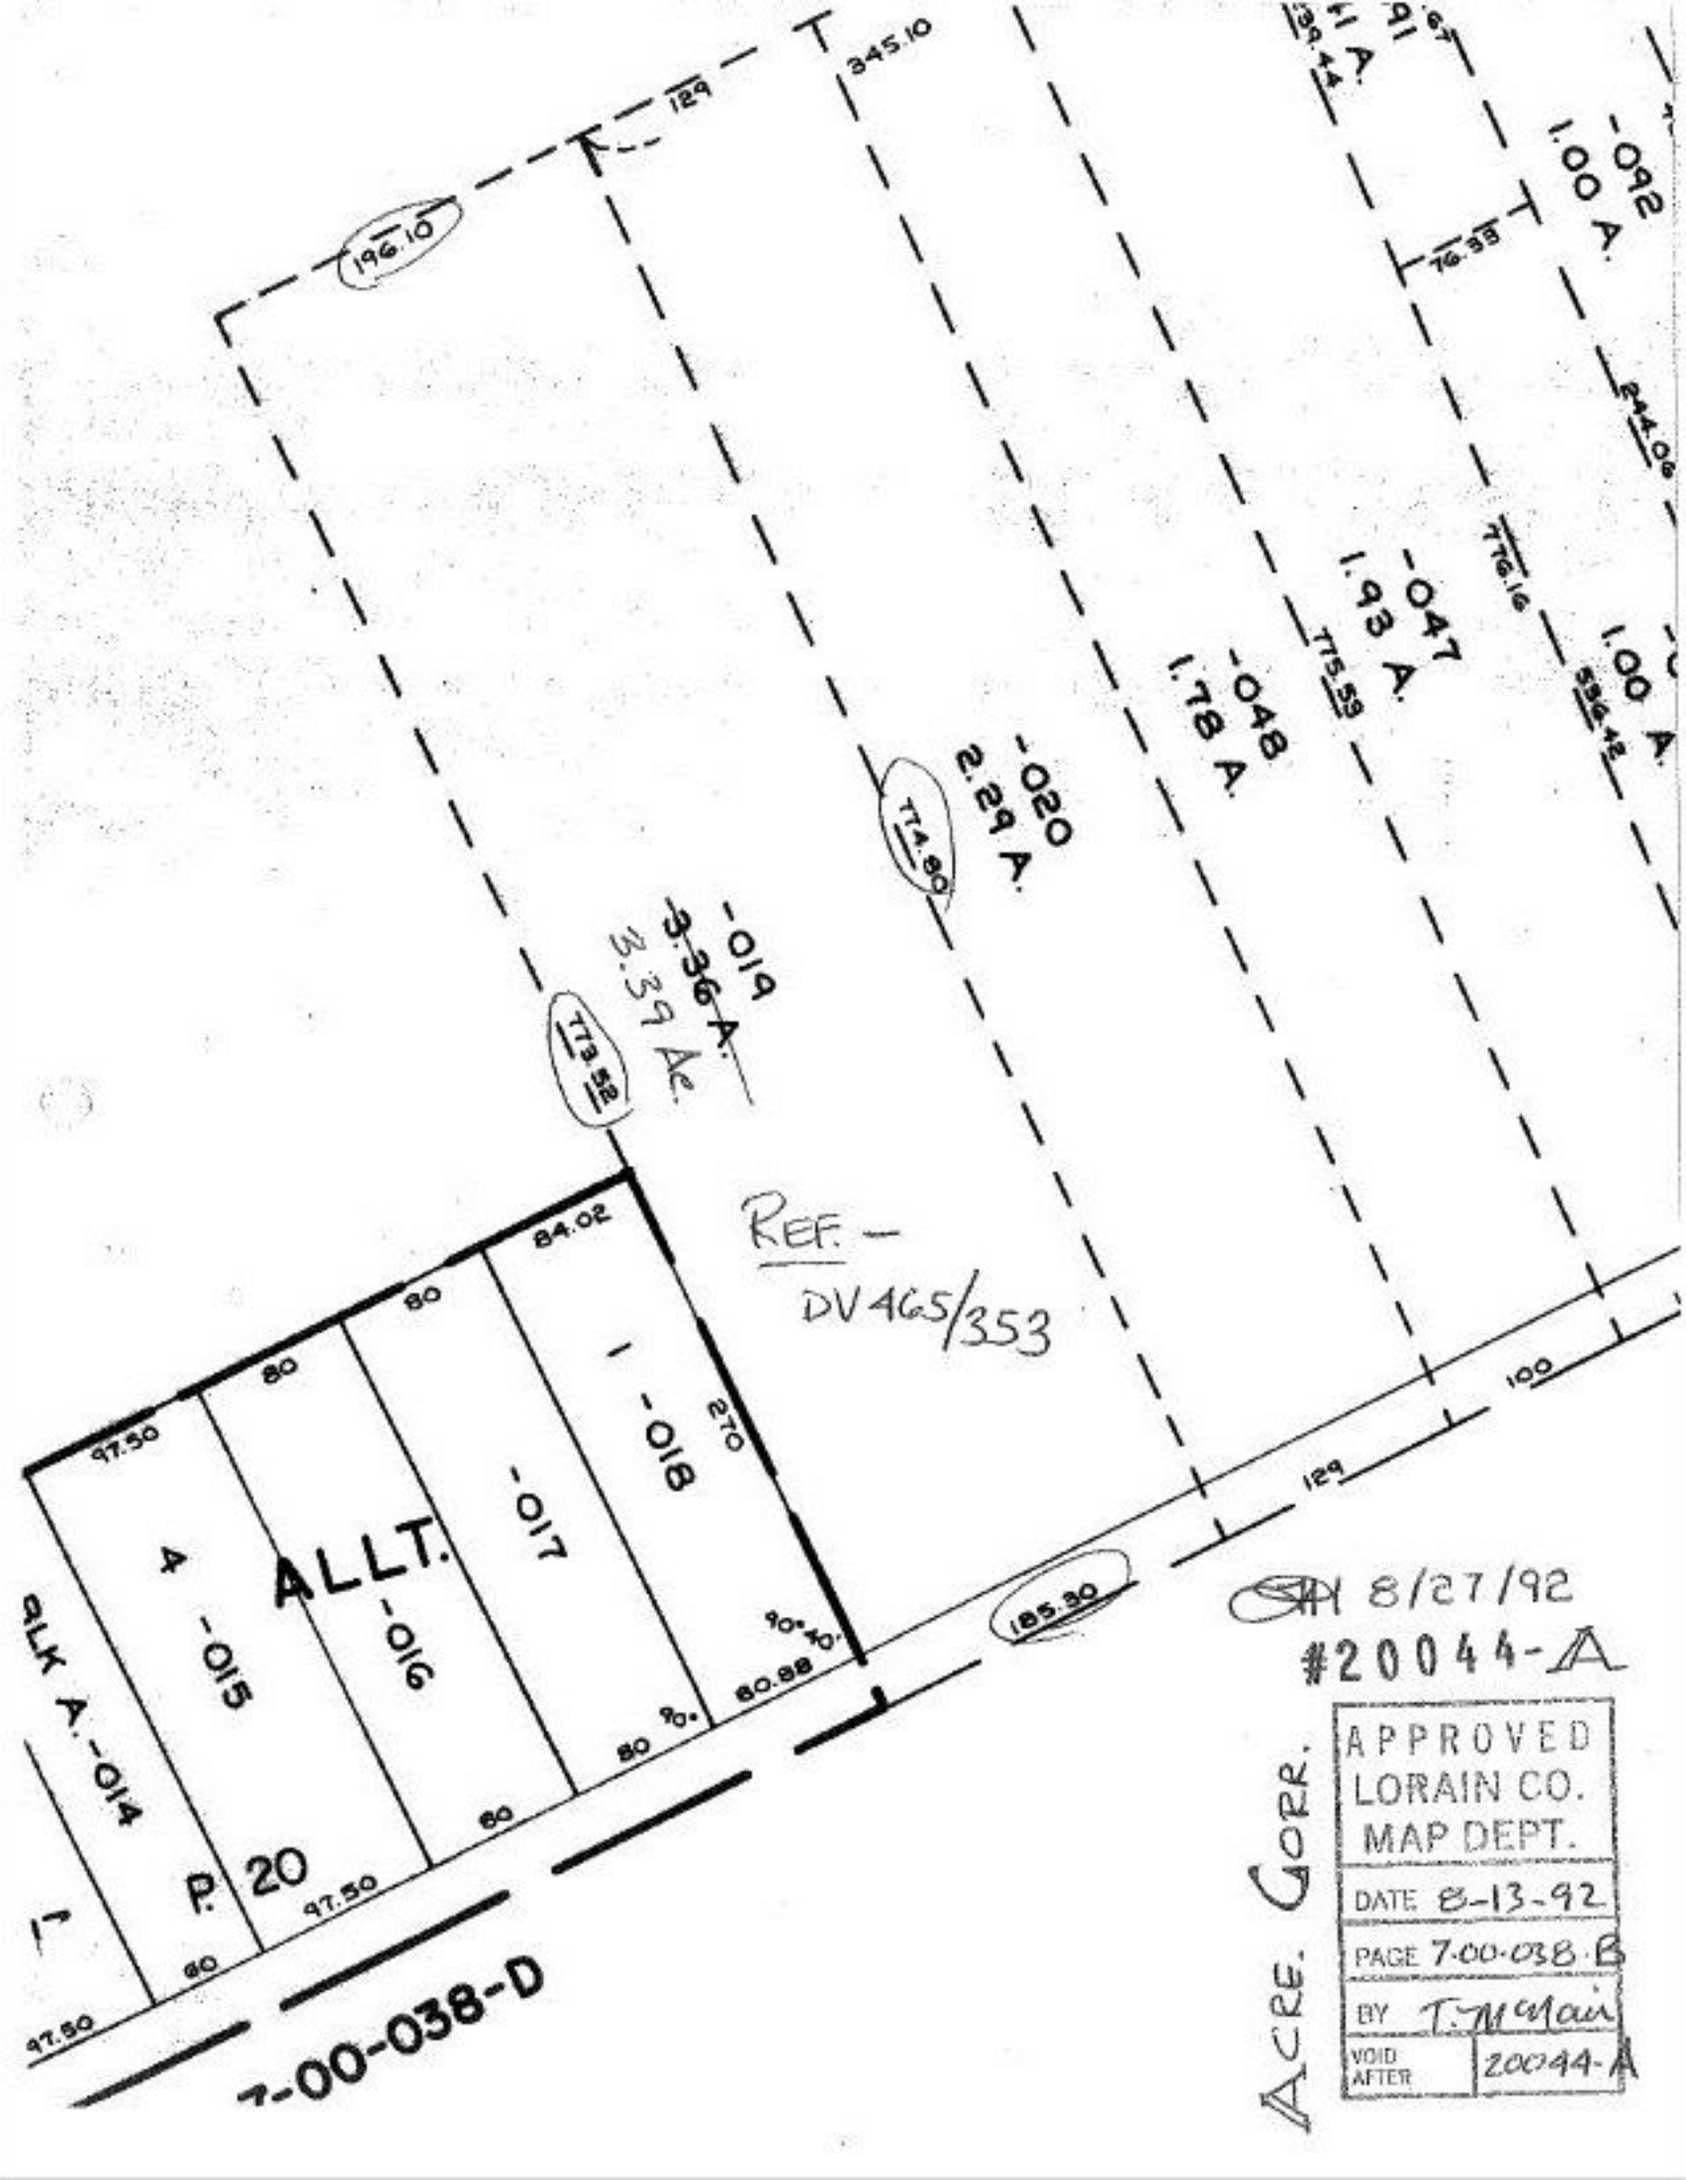
-092
1.00 A.
-047
1.93 A.
-048
1.78 A.
-020
2.29 A.
-019
3.36 A.
3.39 Ac.
-018
-017
-016
-015
ALLT.
4
P. 20
BLK A
-014
1
345.10
196.10
129
84.02
80
97.50
270
100
185.30
80.98
60
7-00-038-D
REF. —
DV 465/353
8/27/92
#20044-A
ACRE. CORR.
APPROVED
LORAIN CO.
MAP DEPT.
DATE 8-13-92
PAGE 7-00-038-B
BY T. McMain
VOID AFTER 20044-A