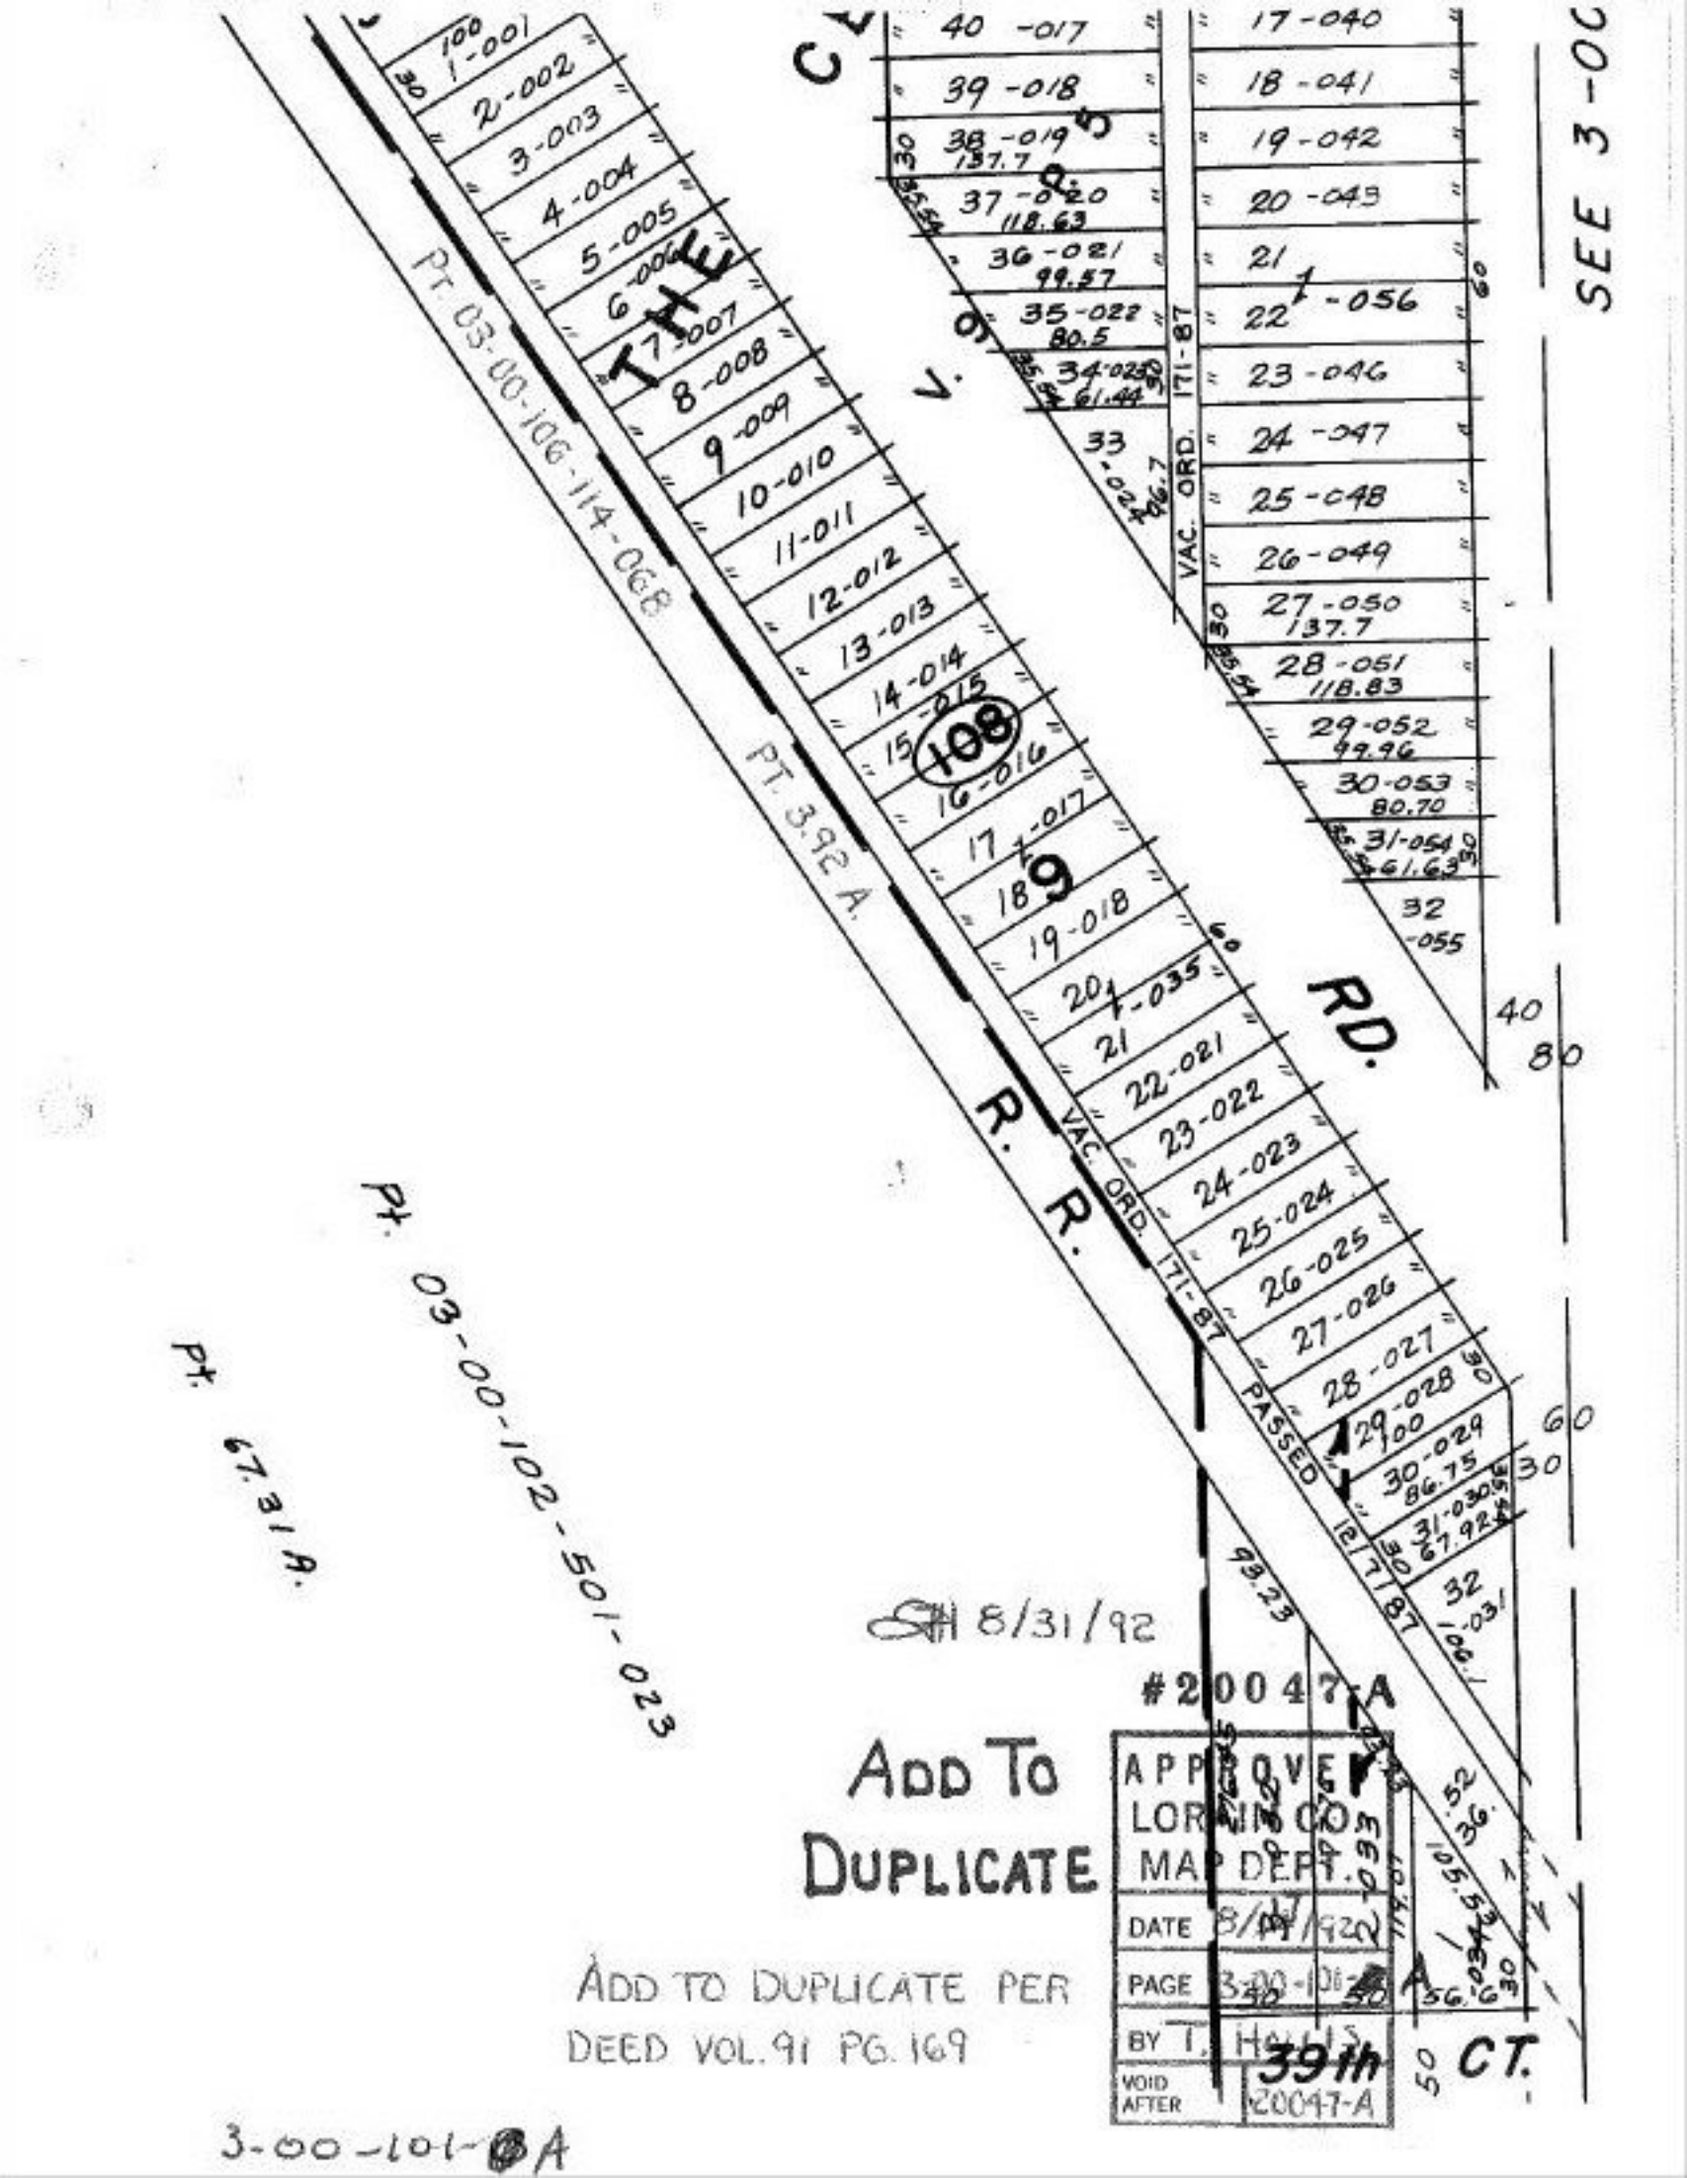
SEE 3-00
CA
ST.
THE
RD.
R. R.
VAC. ORD. 171-87
PASSED
VAC. ORD. 171-87
PT. 03-00-106-114-068
PT. 3.92 A.
Pt. 03-00-102-501-023
Pt. 67.31 A.
108
189
1-001
2-002
3-003
4-004
5-005
6-006
7-007
8-008
9-009
10-010
11-011
12-012
13-013
14-014
15-015
16-016
17-017
19-018
20-035
21
22-021
23-022
24-023
25-024
26-025
27-026
28-027
29-028
30-029
31-030
32-031
40-017
39-018
38-019
37-020
36-021
35-022
34-023
33-024
17-040
18-041
19-042
20-043
21
22-056
23-046
24-047
25-048
26-049
27-050
28-051
29-052
30-053
31-054
32-055
137.7
118.63
99.57
80.5
61.44
46.7
137.7
118.83
99.96
80.70
61.63
93.23
8/31/92
#20047-A
ADD TO
DUPLICATE
APPROVED
LORAIN CO.
MAP DEPT.
DATE 8/31/92
PAGE 3-00-101
BY T. HARRIS
VOID AFTER 39th
20047-A
ADD TO DUPLICATE PER
DEED VOL. 91 PG. 169
CT.
3-00-101-8A